

MIDSHIP SECTION "TURAKINA,"

No 382

STEEL SCREW STEAMER



TO CLASS 100 A.1. AT LLOYDS (THREE DECK RULE)

47'2"0 BP x 59'4" MLD x 34'11" MLD TO UPPER DECK

Scale 1/2 inch = 1 foot

INCREASED 3/8 AT SIDES OF HATCHES
AND ENGINE + BOILER CASING

SHELTER DECK

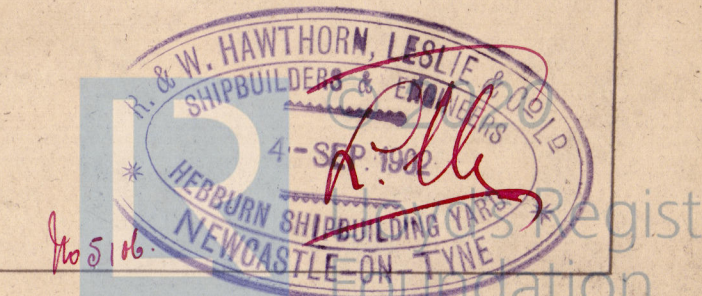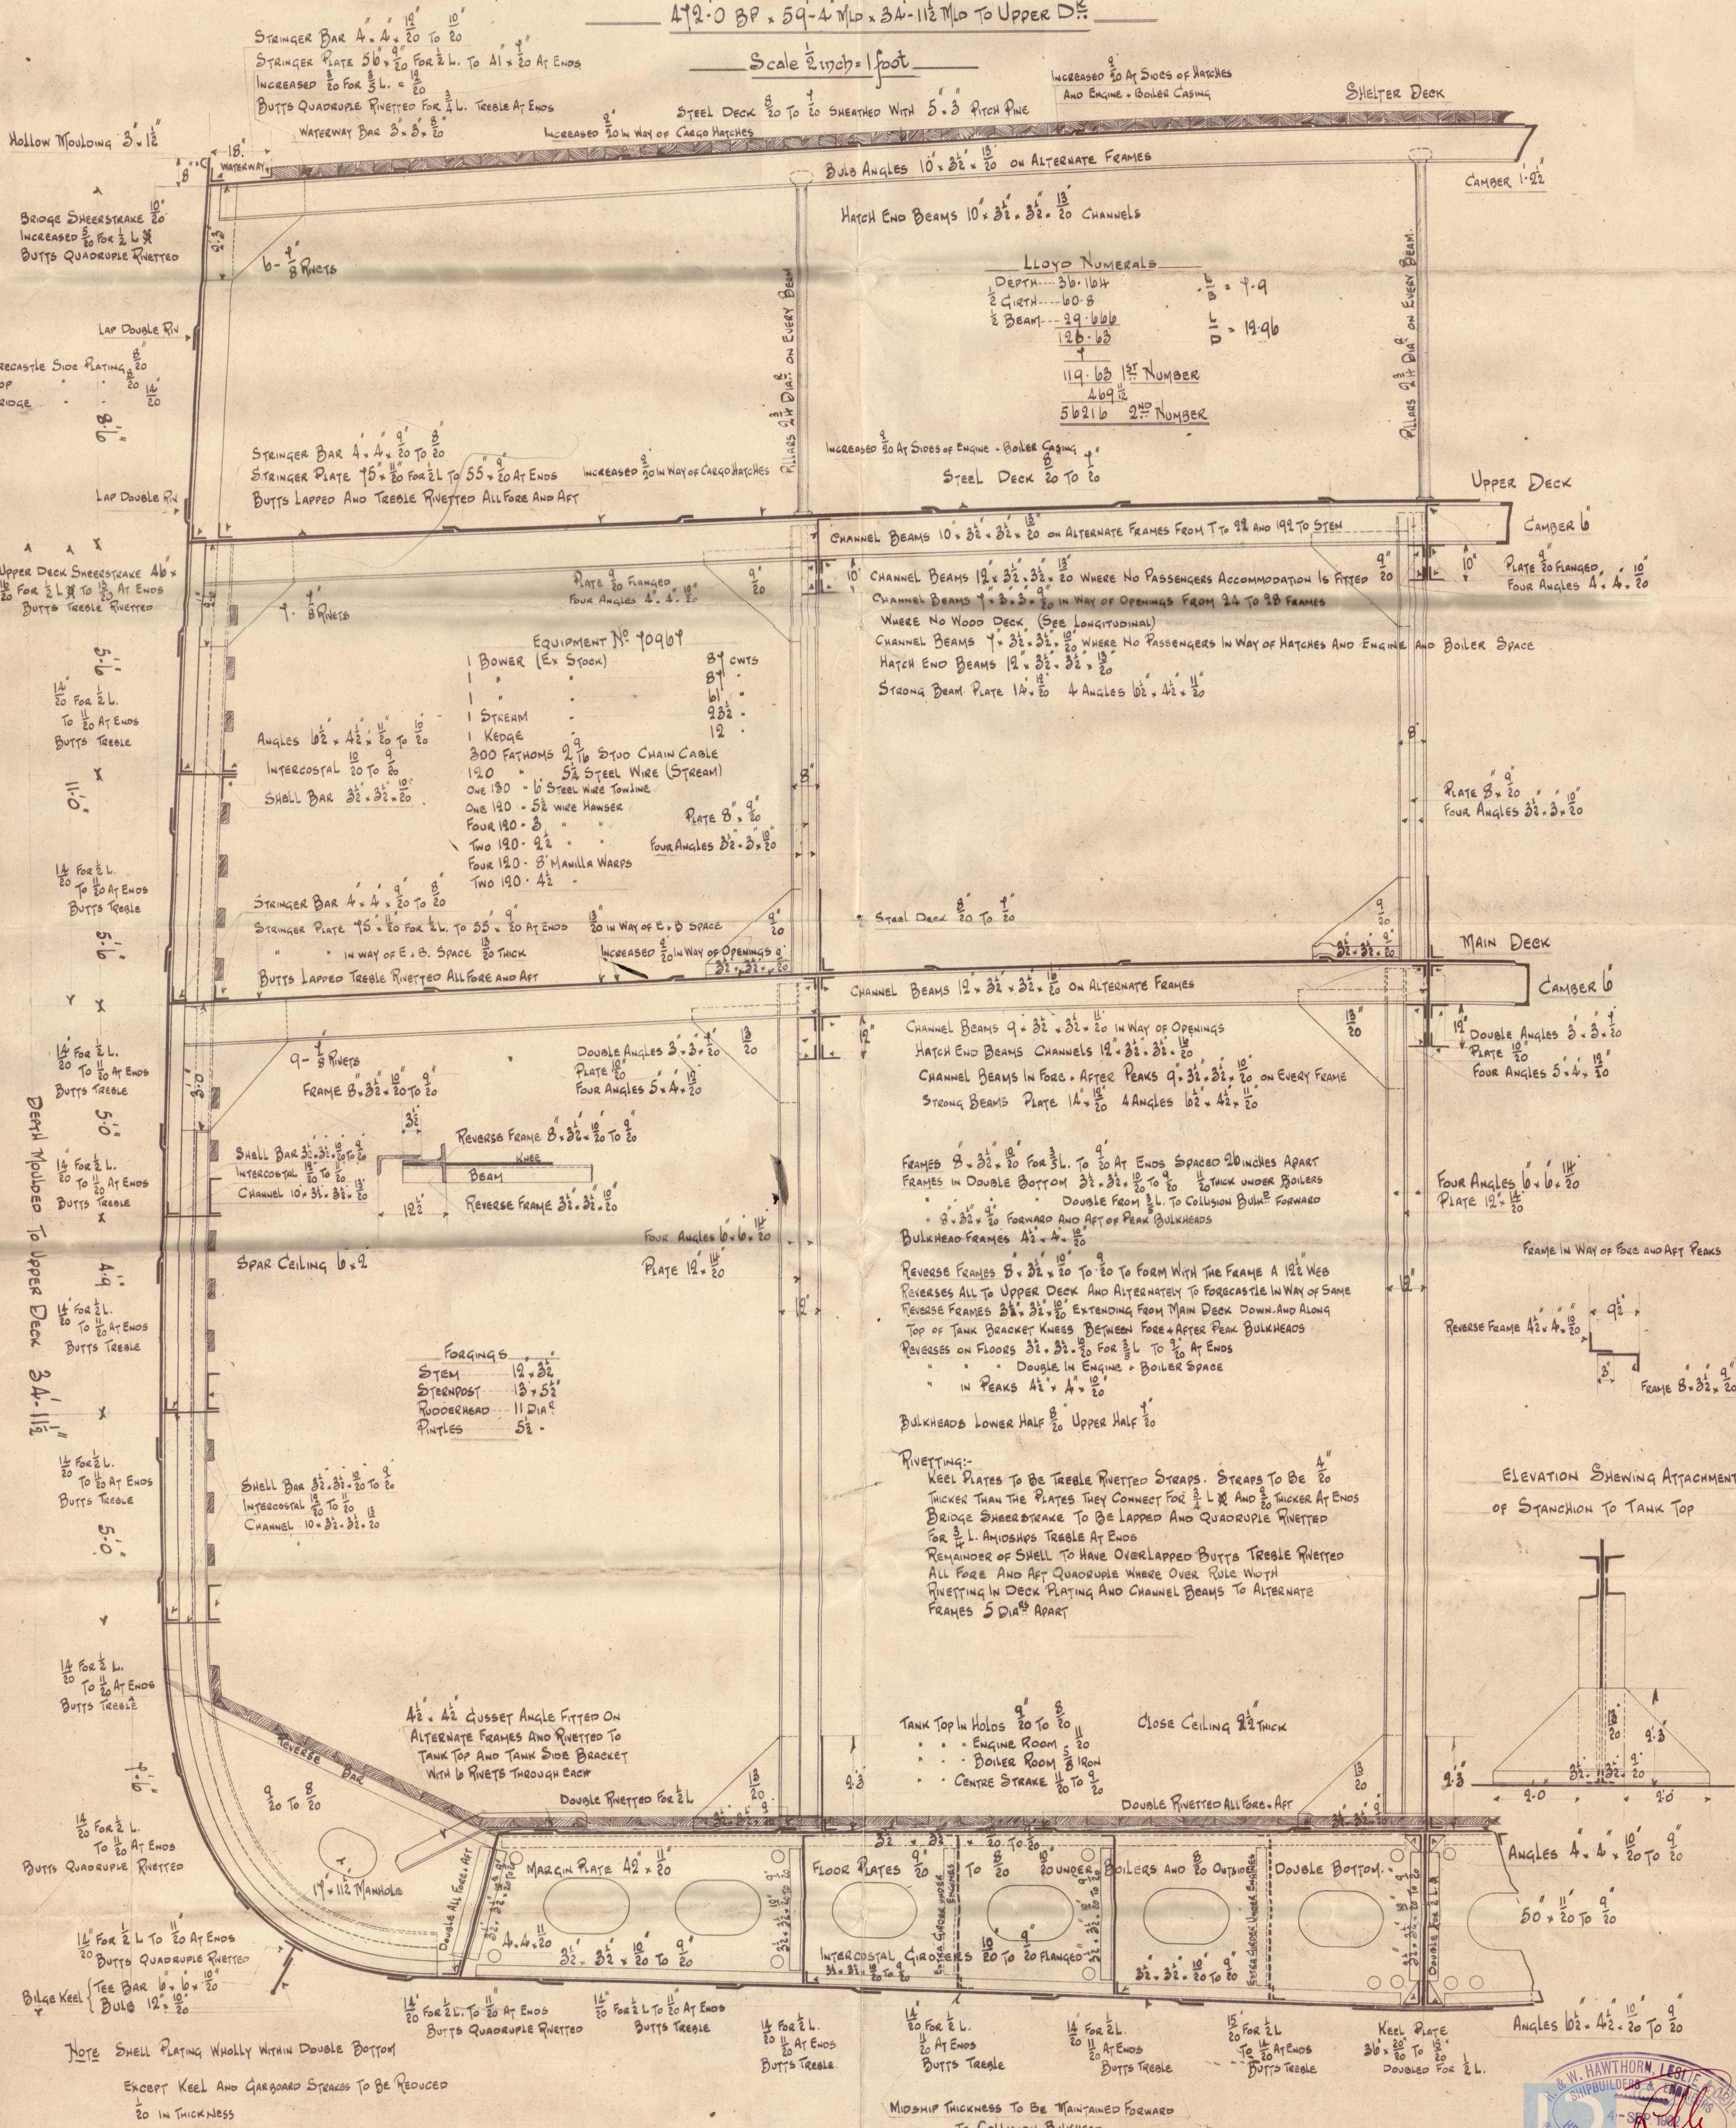

W713 - 0071

Hawthorn, Leslie & Co.
Yard No. 382.
S. S. "Turakina"
Midship Section of
Vessel as built.



Turakina

No. 44089.

RETAIN

R

© 2020
Lloyd's Register
Foundation

W713-0071