


— SCALE $\frac{1}{8} =$ ONE FOOT. —

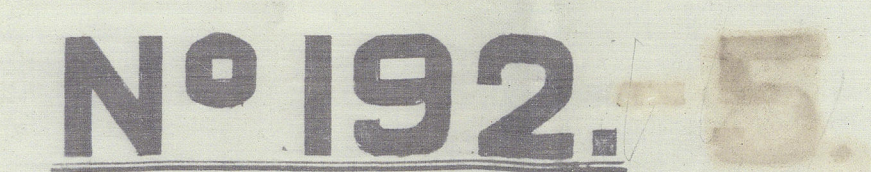

Hoyd's F

Hoyd's F

S.S. WESTWICK
PICKERSGILLS NO 192
PROFILE AND DECK PLANS
(AS FITTED)
SLD RPT NO. 26846

RETAIN



© 2021

Lloyd's Register
Foundation

W714-0090