

SKETCH SHEWING EXTRA STRENGTHENING
ON WEBS ON SHELTER DK HATCHES N^{OS} 2,3,4 & 5
FOR FREEBOARD PURPOSES.

— OF A —
SHELTER DECKED SCREW STEAMER.

- DIMENSIONS.

LENGTH ----- 405-0
BREADTH MLD ----- 52-0
DEPTH MLD ----- 26-6

- CLASS 100. A. 1. SHELTER DECK. -

SCALE $\frac{1}{2}$ " = ONE FOOT.


—Anchors & Cables.

Equipment No 34505.

1 st	Bow	Stockless	--	60	cuts
2 nd	-do-	-do-	-do-	60	-
3 rd	-do-	-do-	-do-	50 1/2	-
Stream	ex	Stock	-	16 1/2	-
ridge	-do-	-do-	-	7	-
270 fathoms	Steel	Chain	Cable	2 3/16	
40	-do-	Stream	Chain	1 1/16 or 4 3/4	Steel wire

— *Hawsers & Warps.* —

120 fathoms Towline	14 or 4 ³ / ₄	Steel wire
2-90 -- Hawser	8	
2-90 -- Harp	7	

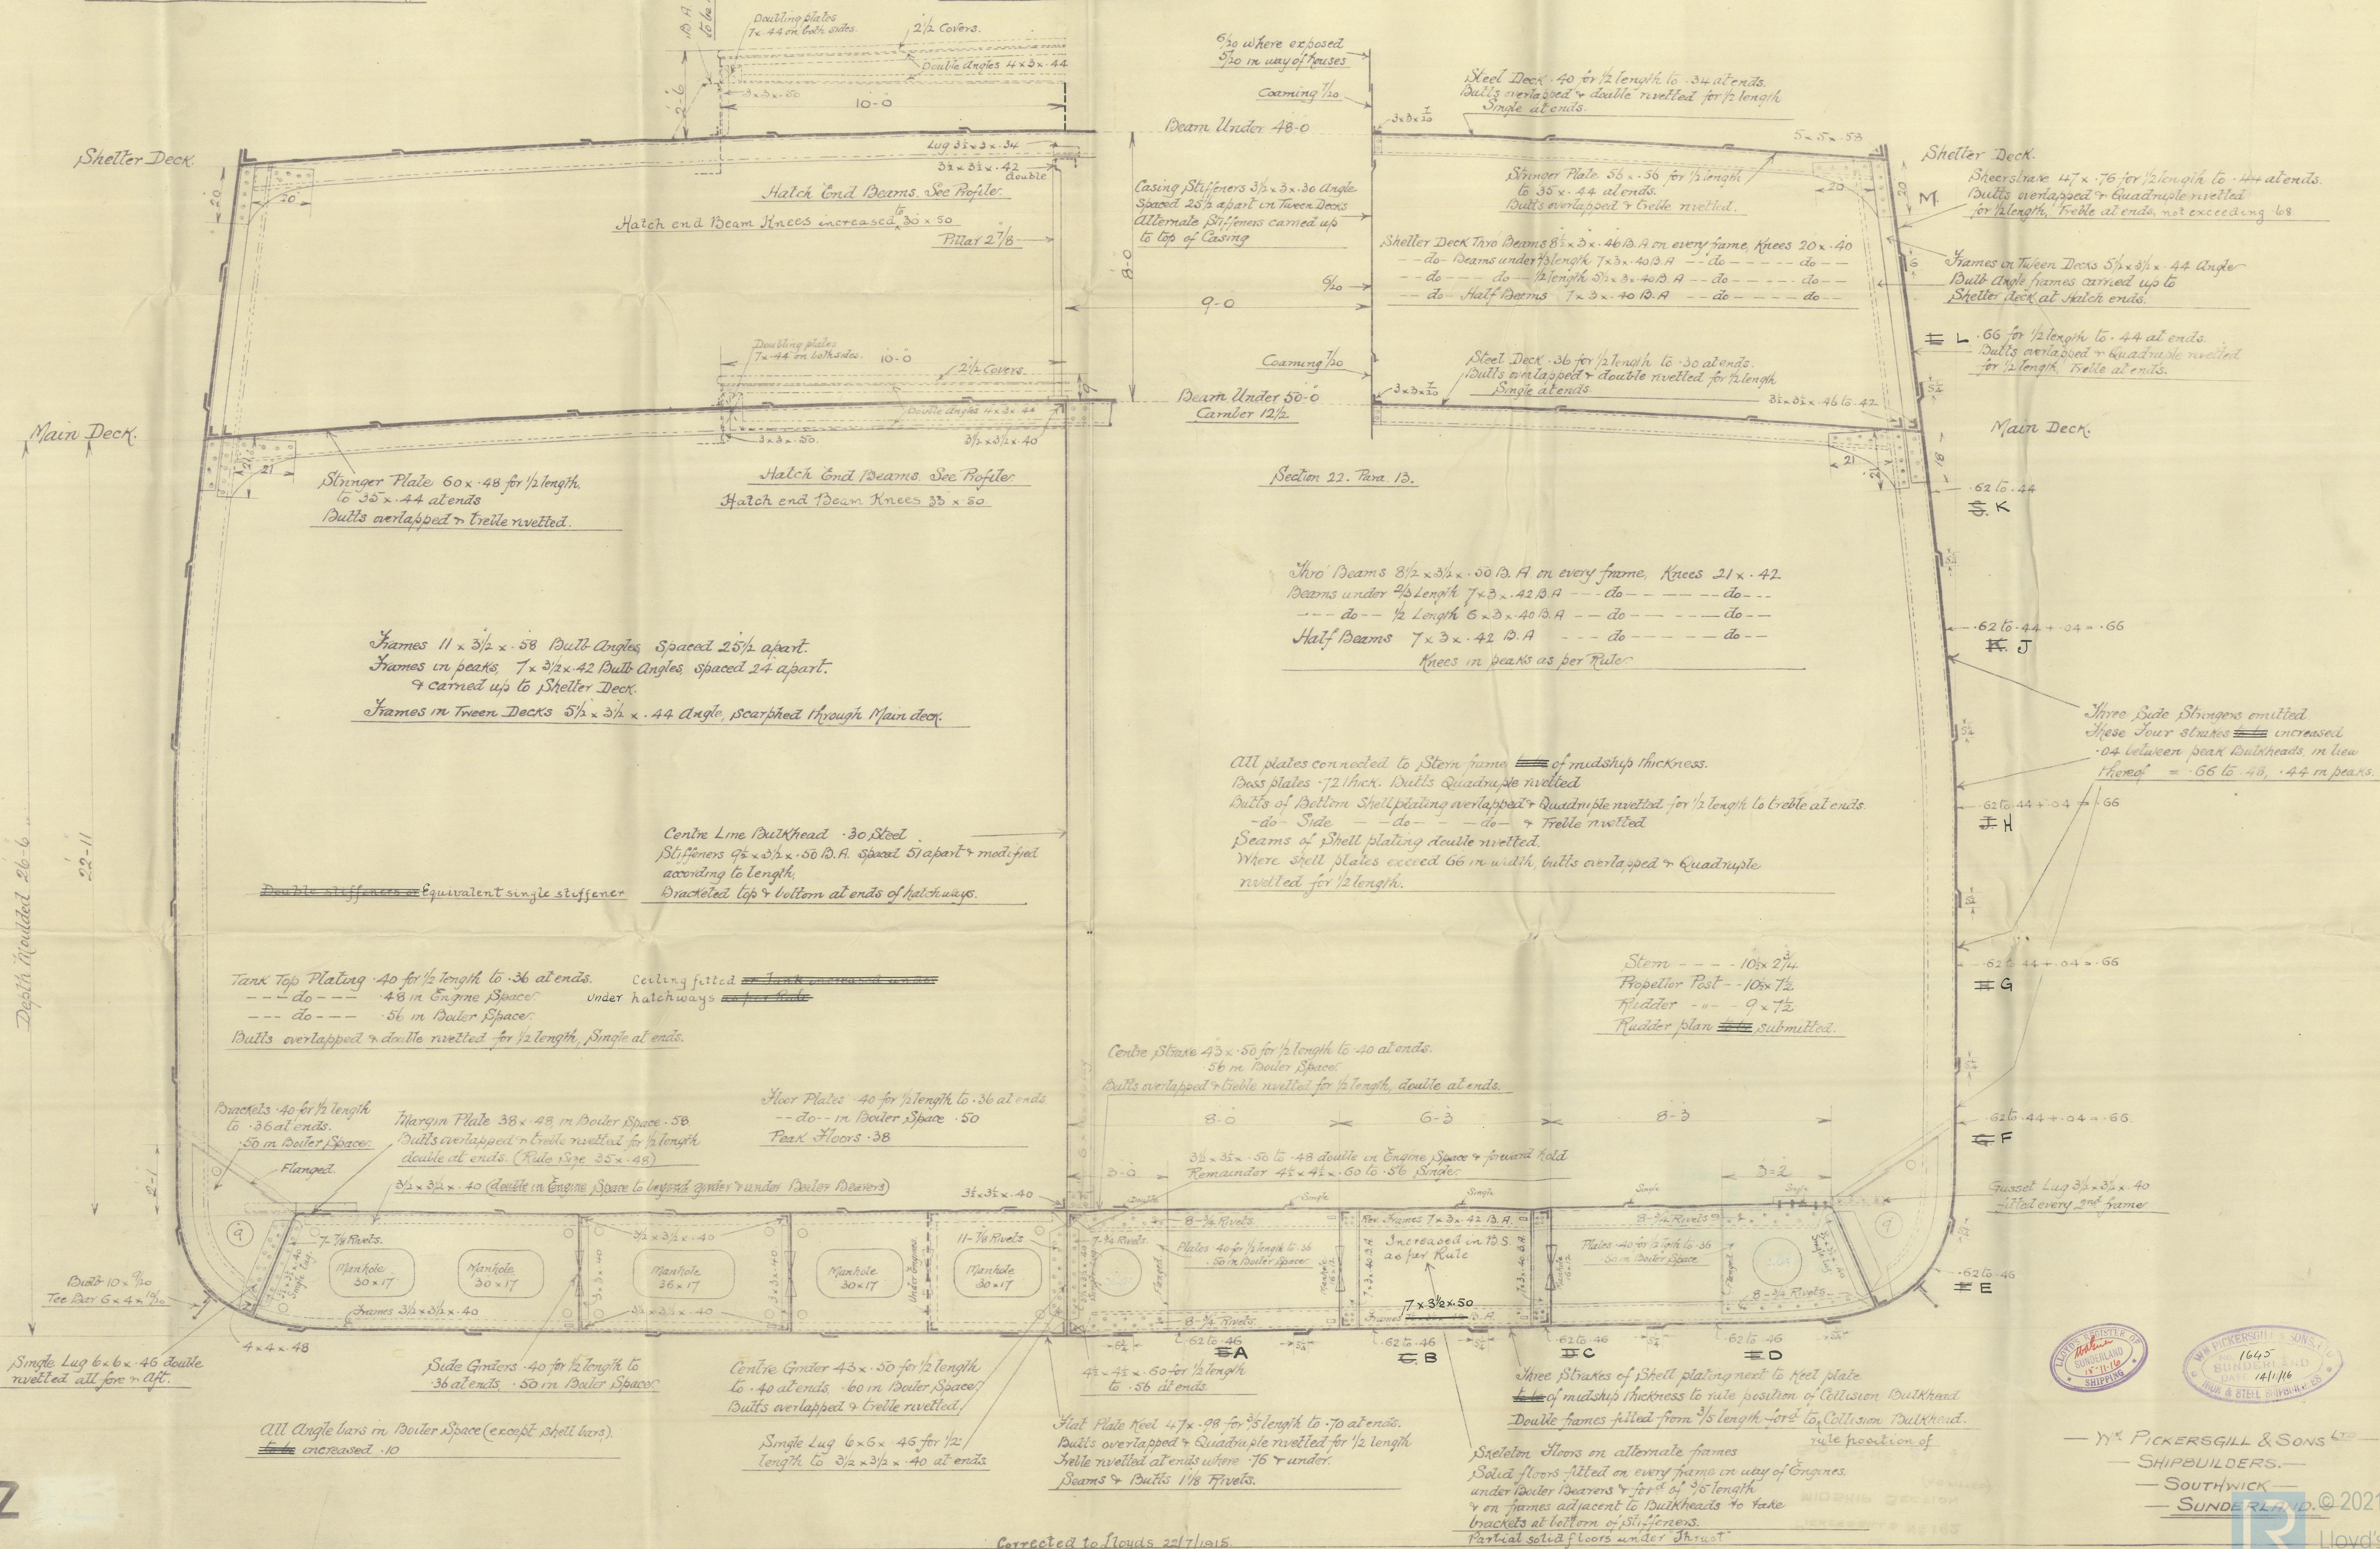

Nº 192

Corrected to Lloyds 22/7/1915

— *Wm PICKERSGILL & SONS LTD* —
— *SHIPBUILDERS.* —
— *SOUTHWICK* —
— *SUNDERLAND.* © 2021

Lloyd's Register
Foundation

S.S. WESTWICK

PICKERSGILLS N^o. 192

MIDSHIP SECTION
(AS FITTED)

SLO RPI N^o. 26846

RETAIN



© 2021

Lloyd's Register
Foundation

W714 0099