

S. S. No 96.

MIDSHIP SECTION.

STEEL SCREW TRAWLER.

DIMS: 130'-0" x 23'-0" x 13'-0" MLD.

TO CLASS 100 AI LLOYDS, FOR FISHING PURPOSES.

SCALE $\frac{1}{2}$ IN = 1 FT.

NUMERALS.

HALF GIRTH ----- 20.38

" **BREADTH** --- 11.5 ✓

DEPTH ----- 13.5

1ST N^o ----- 45.38

LENGTH ----- 128.87

2ND No. ----- 5848 .12

EQUIPMENT. N° 5848.

1 ANCHOR -- 5 3/4 CWT (8x5 STOCK) OR 7-0-21 STAINLESS


1 " --- 5 1/4 " " " OR 6-2-7"

1 " --- 3 ✓ " " "

105 FTMS 1 $\frac{1}{16}$ STUD LINK CHAIN.

60 FTHMS 6" HAWSER

60 FTHMS 5"✓ WARP.

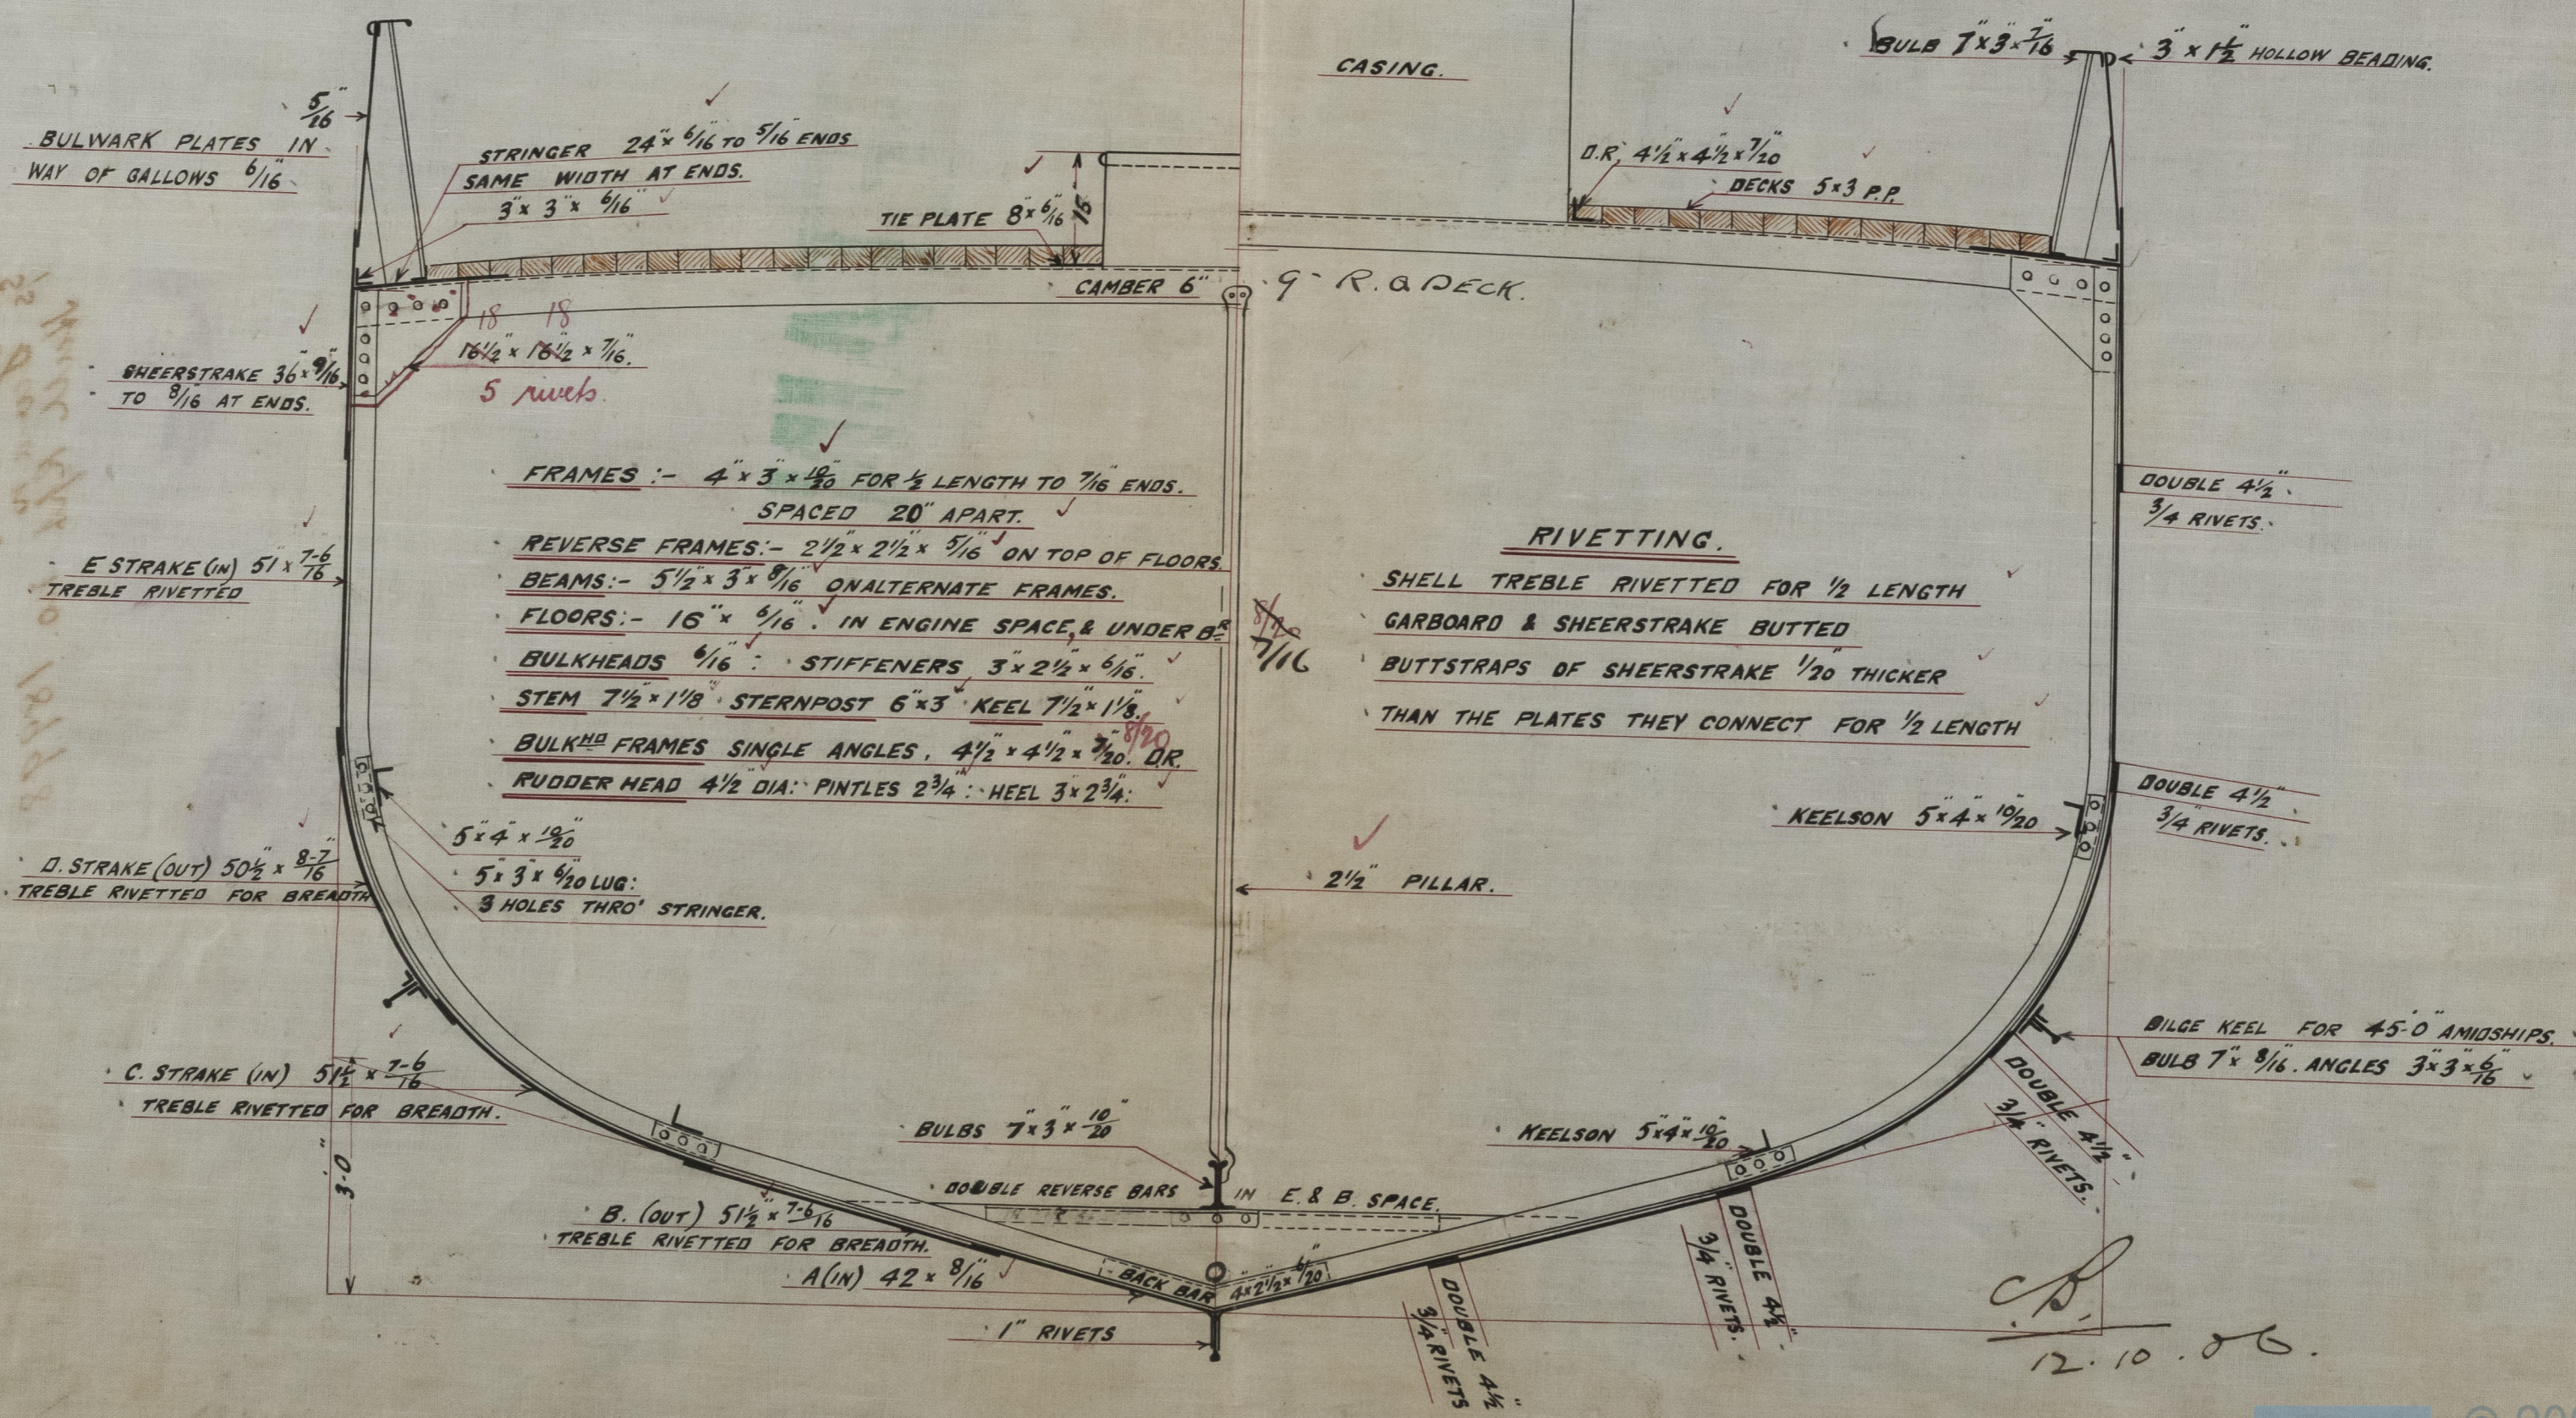

12.10.06.

Gooli S. & R. Co

No 96.

Midship Section.

S/S Swan
Hull Rpt no. 18998



RETAIN



© 2021

Lloyd's Register
Foundation

W77-0026