

MIDSHIP SECTION N<sup>o</sup> 245.

SCALE  $\frac{1}{2}" = \text{ONE FOOT.}$

TO CLASS 100.A.1. LLOYDS.

## DIMENSIONS


LENGTH B.P.	290' 0" ✓
BREADTH (EXT)	40' 9" ✓
DEPTH MLD	20' 0" ✓

POOP SCANTLINGS

BEAMS  $6\frac{1}{2} \times 3 \times 34$  BA &  $3 \times 3 \times 34$  O.A. ON ALT. FRs. ✓  
2 ROWS PILLARS  $2\frac{1}{2}$ " DIA. ✓  
SIDE PLATING  $\cdot 32$ " THICK. ✓  
STRINGER PLATE  $27 \times 32$ . ✓  
STRINGER ANGLE  $3\frac{1}{2} \times 3\frac{1}{2} \times 32$ . ✓  
TIE PLATE  $9 \times 32$ , WOOD DECK  $5 \times 3$  P.P. ✓

FORECASTLE SCANTLINGS.

BEAMS  $6\frac{1}{2} \times 3 \times 50$  BA &  $5 \times 3 \times 400$  A ON ALT. FRAMES ✓  
2 ROWS PILLARS  $2\frac{1}{2}$ " DIA ✓  
SIDE PLATING  $36$  Tr. ✓  
STRINGER PLATE  $27 \times 32$  ✓  
STRINGER ANGLE  $32 \times 32 \times 32$  ✓  
TIE PLATE  $9 \times 32$ , WOOD DECK  $5 \times 3$  PP. ✓

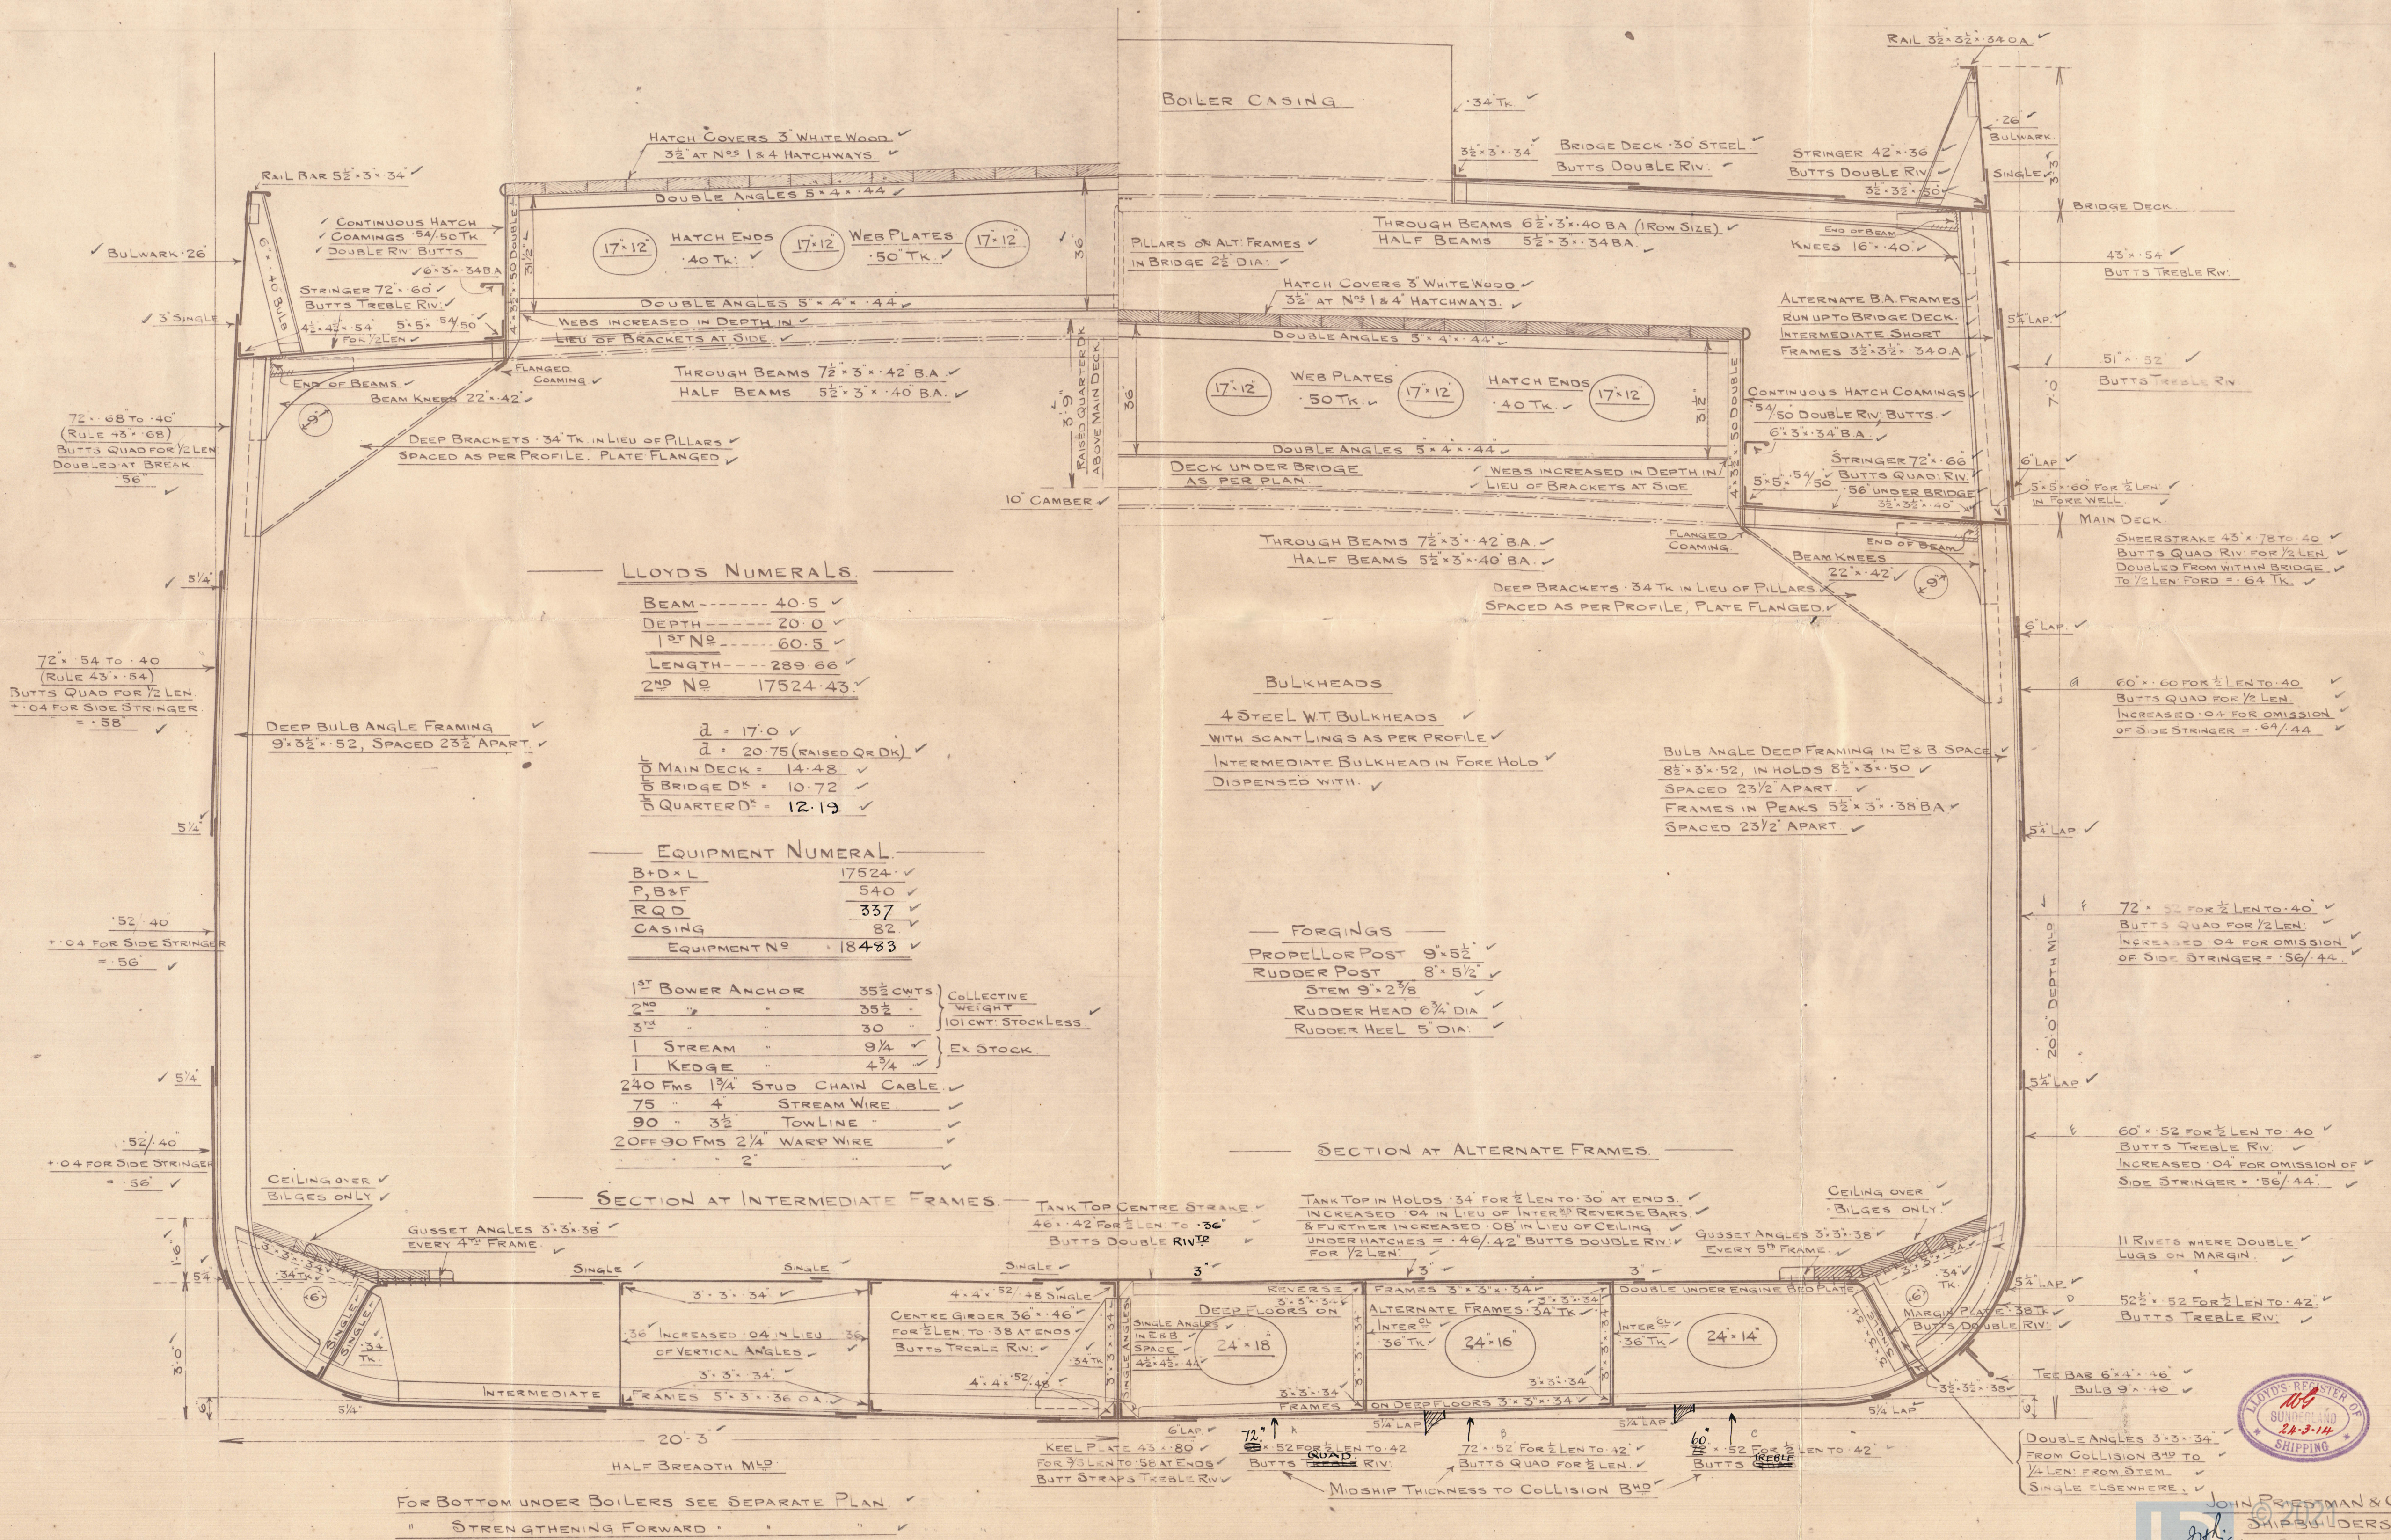

JOHN PRIESTMAN & Co  
© 2021  
SHIPBUILDERS  
SUNDERLAND.  
Lloyd's Register  
Foundation  
12718-0034



S.S. SIMOOM

SLO RPT N<sup>o</sup> 26066

MIDSHIP SECTION  
(AS FITTED)

J. PRIESTMAN + C<sup>os</sup>

N<sup>o</sup> 245.

*In detail plans, see N<sup>os</sup> 240 + 243  
(excepting double bottom under boilers)*

RETAIN



© 2021

Lloyd's Register  
Foundation

W 718-0034