

PROFILE S.S. 245.


SCALE $\frac{1}{8}'' = \text{ONE FOOT}$

DIMENSIONS

LENGTH B.P.	290'-0".✓
BREADTH EXT:	40'-9".✓
DEPTH MLD:	20'-0".✓

JOHN PRIESTMAN & CO
SHIPBUILDERS,
SUNDERLAND.

23.3.14

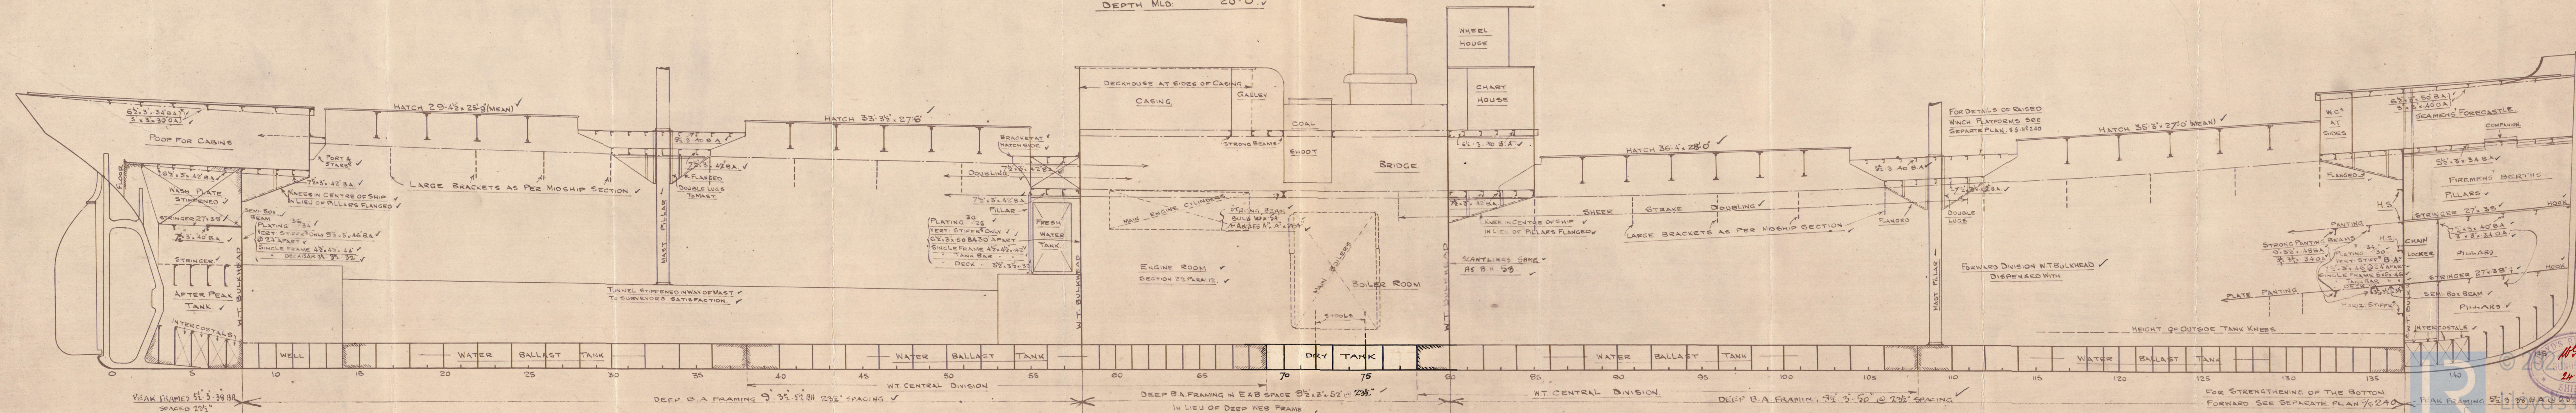

FOR STRENGTHENING OF THE BOTTOM
FORWARD SEE SEPARATE PLAN 7/240

W718-0035

S.S. "SIMOOM"

SLO RPI N^o 26066

PROFILE (AS FITTED)

J. PRIESTMAN + C^os

N^o 245

RETA...



© 2021

Lloyd's Register
Foundation

W 718-0035