

SS. N° 33.

Profile.

317' 6" x 44' 8" x 25' 6"


Scale 1/100.

1/6/06

3831

R/V

8.6.06.

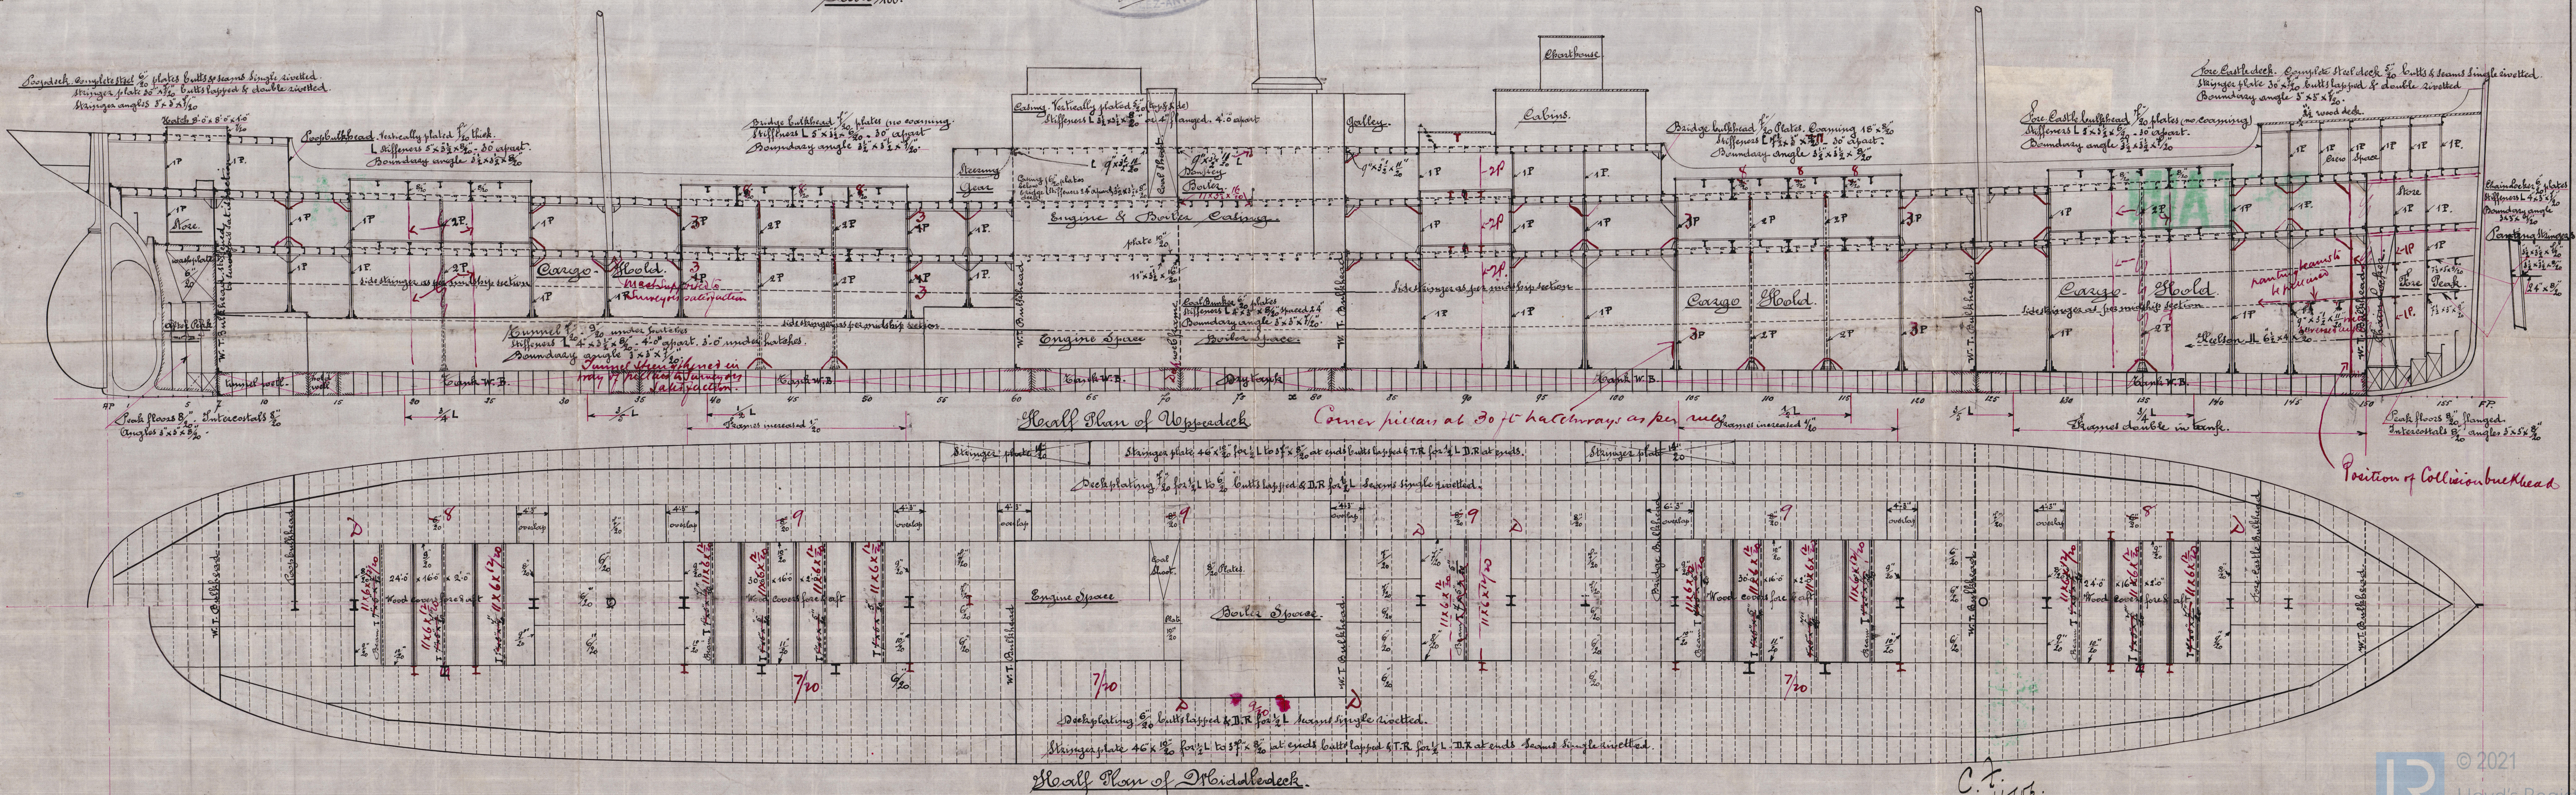

Profile

3.6.06.

