

Equipment.

Scale $\frac{1''}{24} = \frac{1''}{2} = 1 \text{ foot.}$


$$\frac{L}{D} = 12,93$$
$$\frac{L}{B} = f. 10.$$

		89,40
	x	315 50
		<hr/>
		28205
Erections		
Coops	24'-0" x 4'-0" x 1 1/2	252
Orange	86'-0" x 4'-0" x 1 1/2	905
Corr. Castle	24'-6" x 6'-9" x 1 1/2	299
Cabins	20'-0" x 4'-0"	140.
R.		<hr/>
		297948.

2 Bowser anchors Stockless 42 ^{no^{ts}} each.
1 " " 35 $\frac{1}{2}$ "
1 Steam anchor & stock 11 "
1 Hedge " " 5 $\frac{1}{4}$ "
240 fathoms stud chain cable $1\frac{14}{16}$
75 " steel wire $4\frac{1}{4}$ "
100 " hemp rope 12" or 4" steel wire.

Hawsons & Harps.

2 of 90 fathoms of 7" or steel wire 2 1/2 circ.
2 of 90 " " 6" " " 2 1/4 " ✓

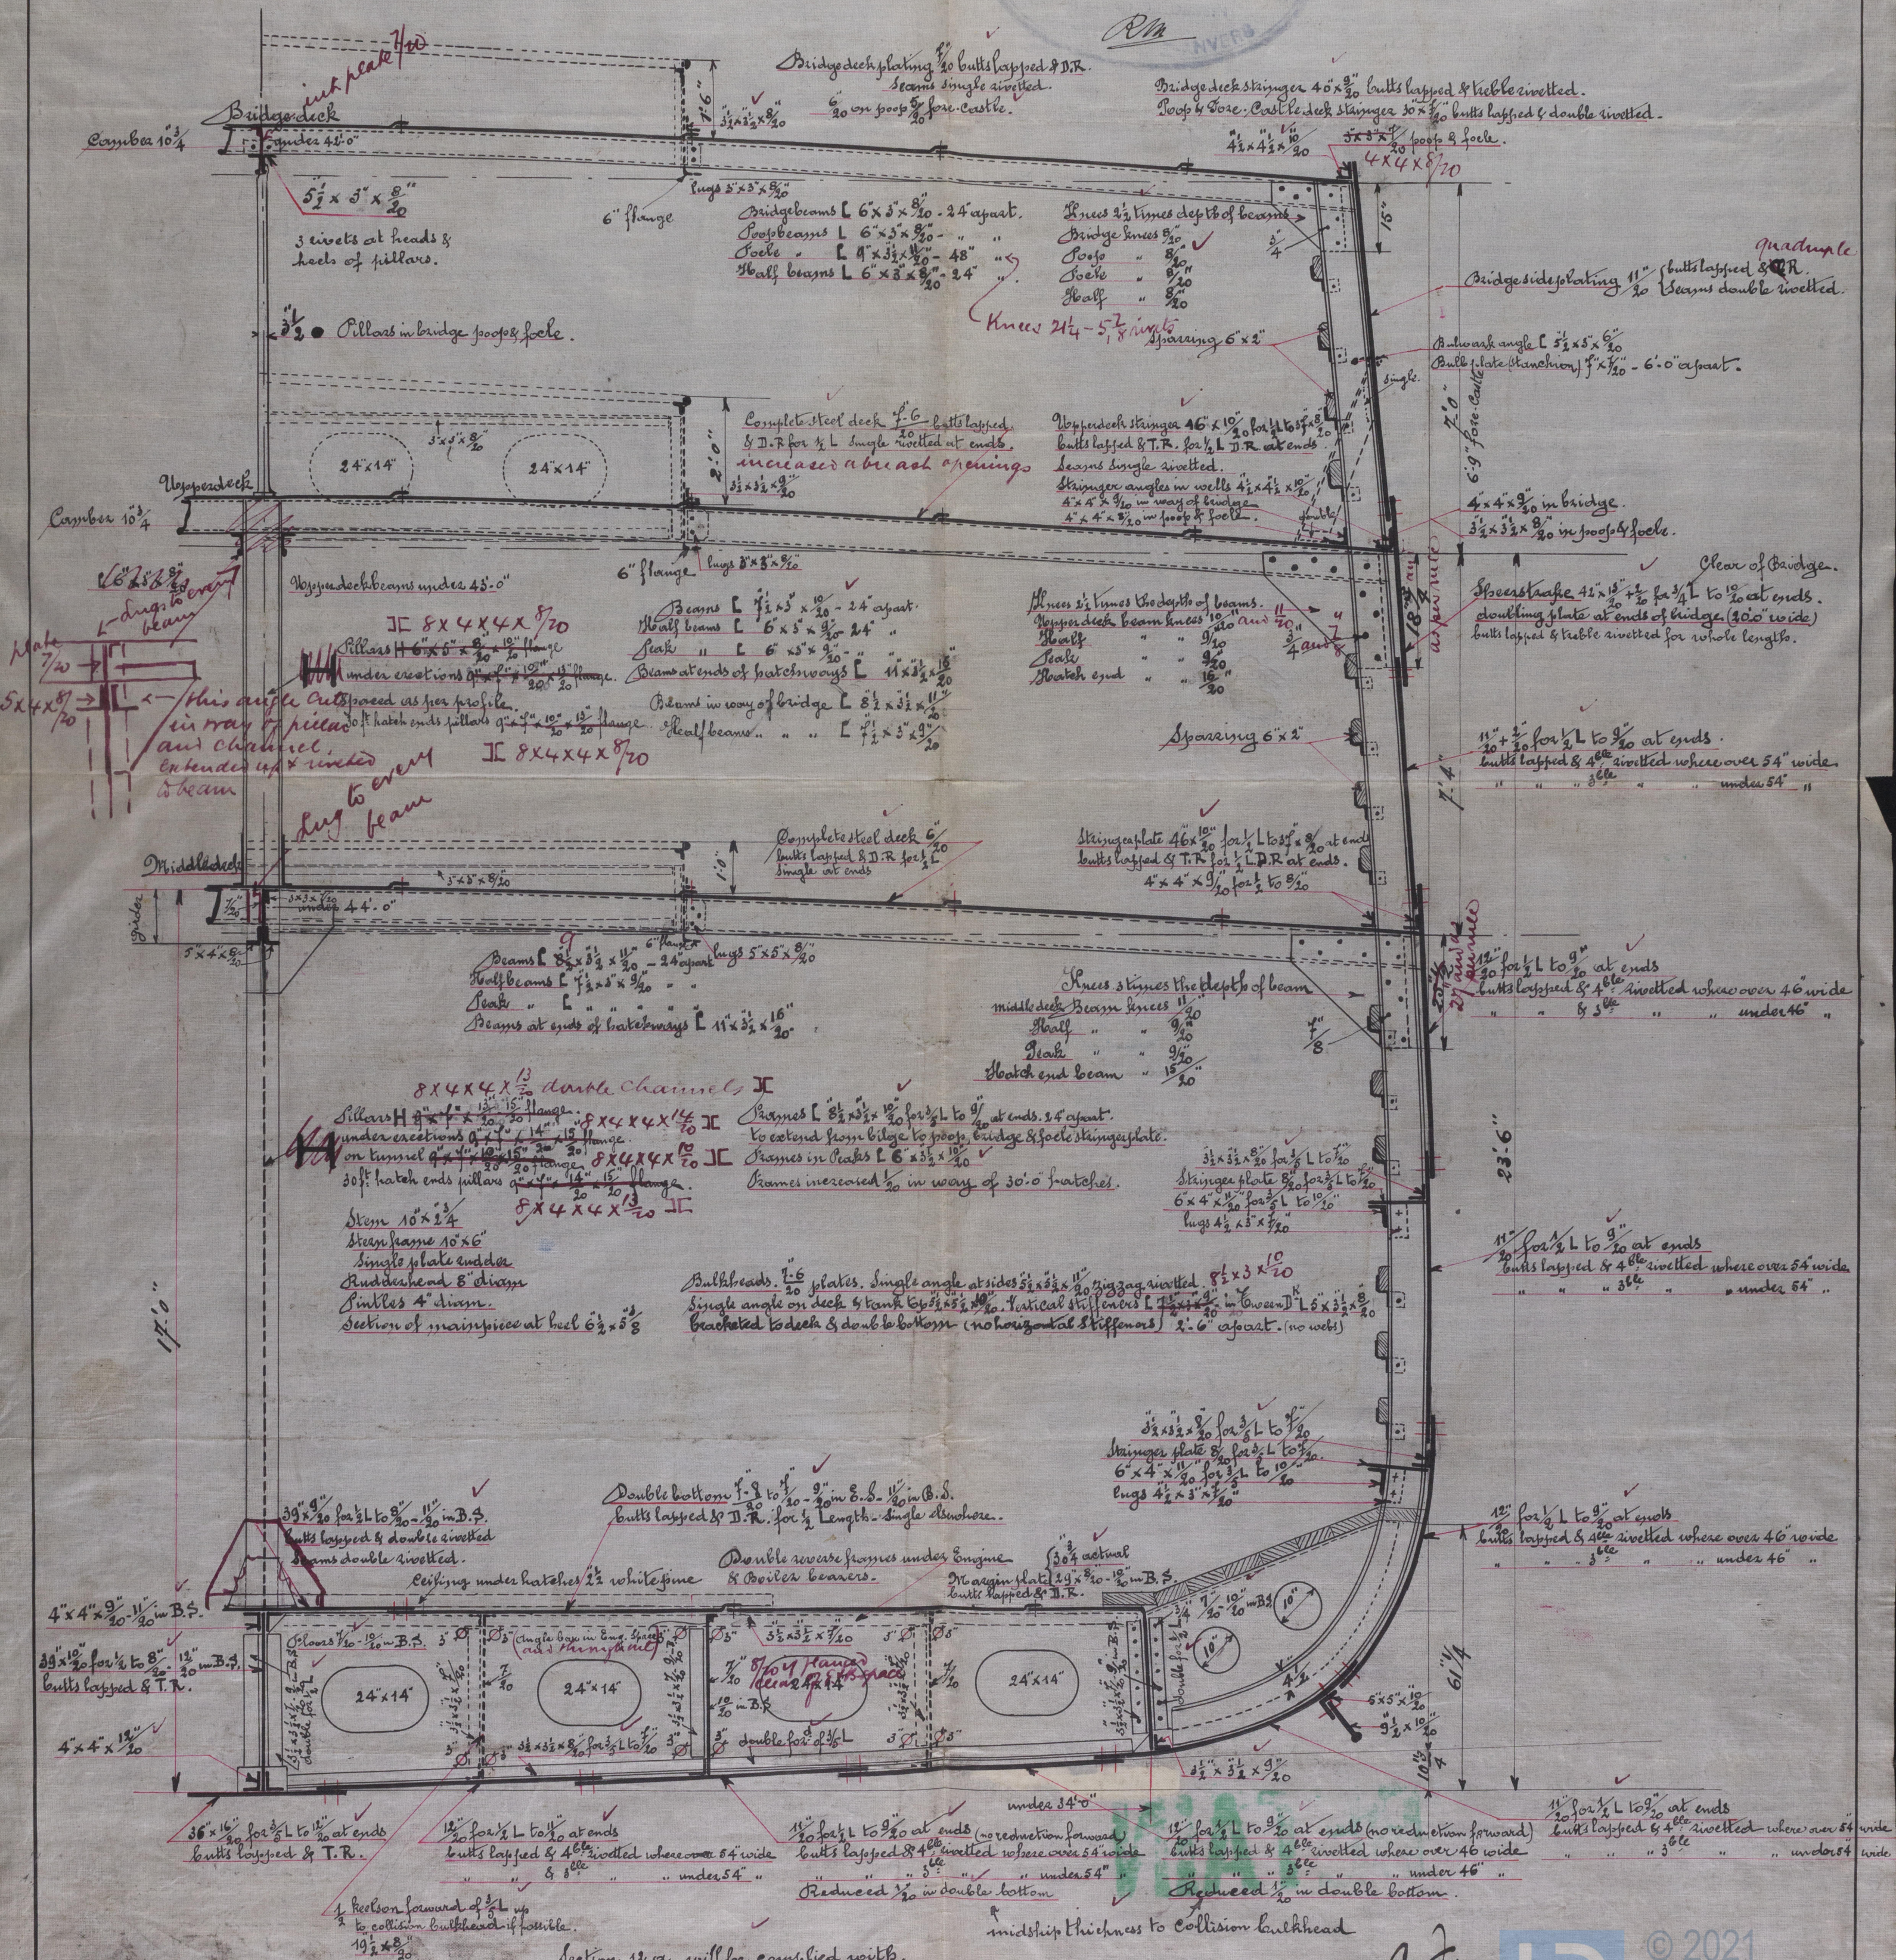


Section 12 a will be complied with.

C. 7.
716756

Lloyd's Register
Foundation

W 718-0092

Handwritten notes and calculations in blue ink, including the word "Lest" and various mathematical expressions.

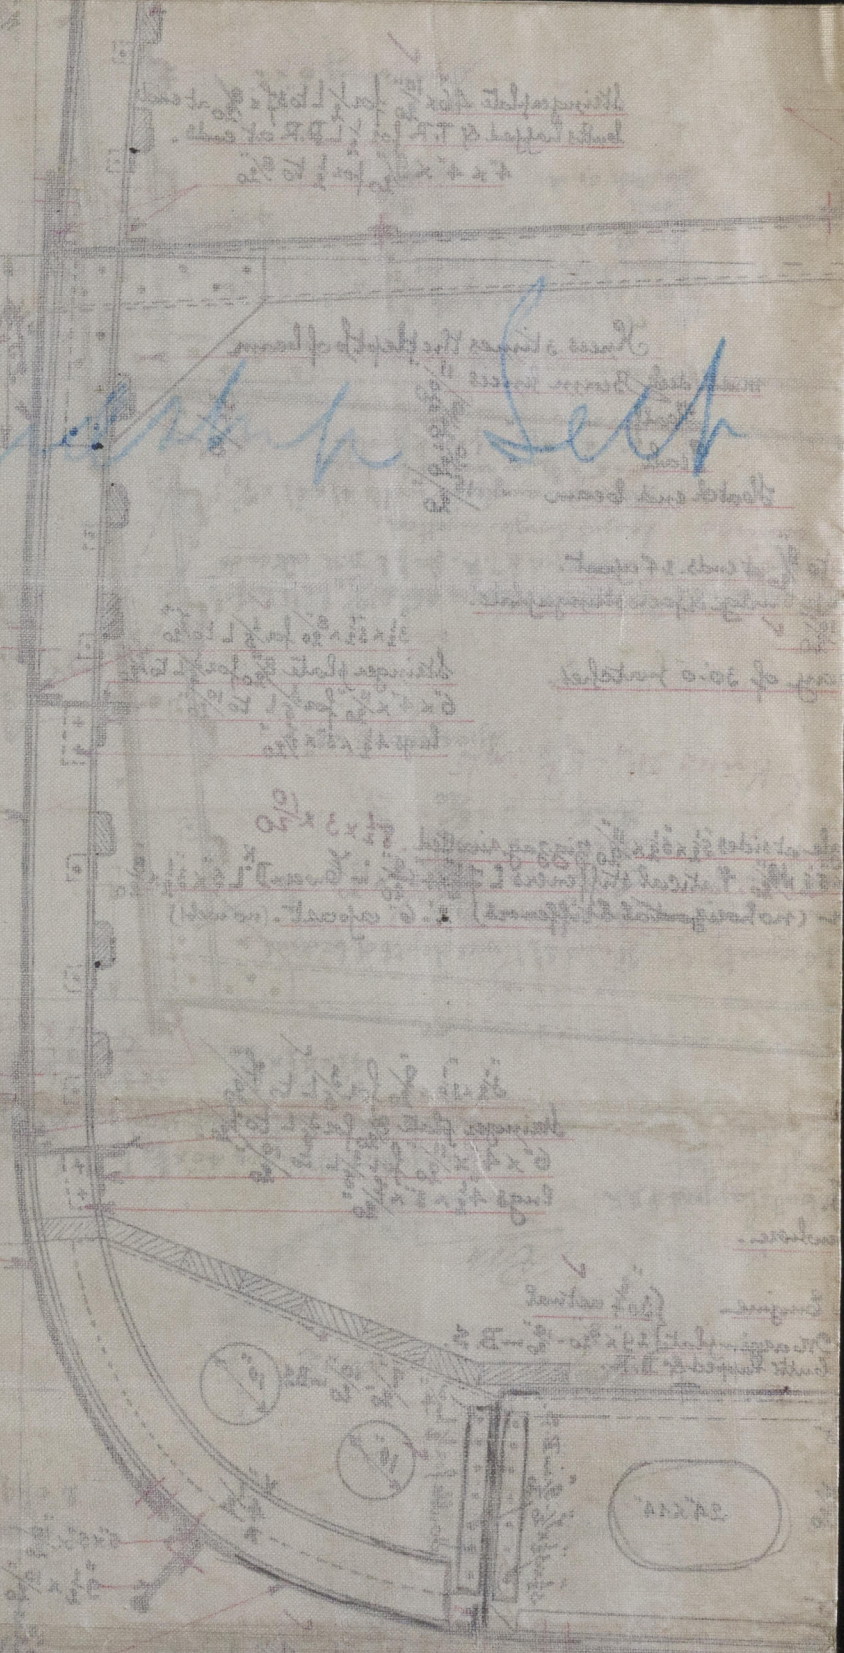

PLAN

Handwritten notes in blue ink, including the word "Lest" and various mathematical expressions.



© 2021

Lloyd's Register
Foundation