

# - NORTHUMBERLAND ENGINE WORKS. -

- TRACING 424 -

- SCHEDULE L -

- STEAM BOILER -

- SCALE 1 INCH = ONE FOOT. -

J.W.A.  
22/10/06



- WORKING PRESSURE = 180 LBS. -




- TEST PRESSURE = 360 -

- NOTE. ALL PLATES STAYS 8" TO BE OF STEEL -

- TENSILE STRENGTH OF SHELL PLATING TO BE NOT LESS -

- THAN 28 1/2 TONS PER SQUARE INCH. -

- ALL HOLES DRILLED IN PLACE AFTER PLATES ARE BENT. -

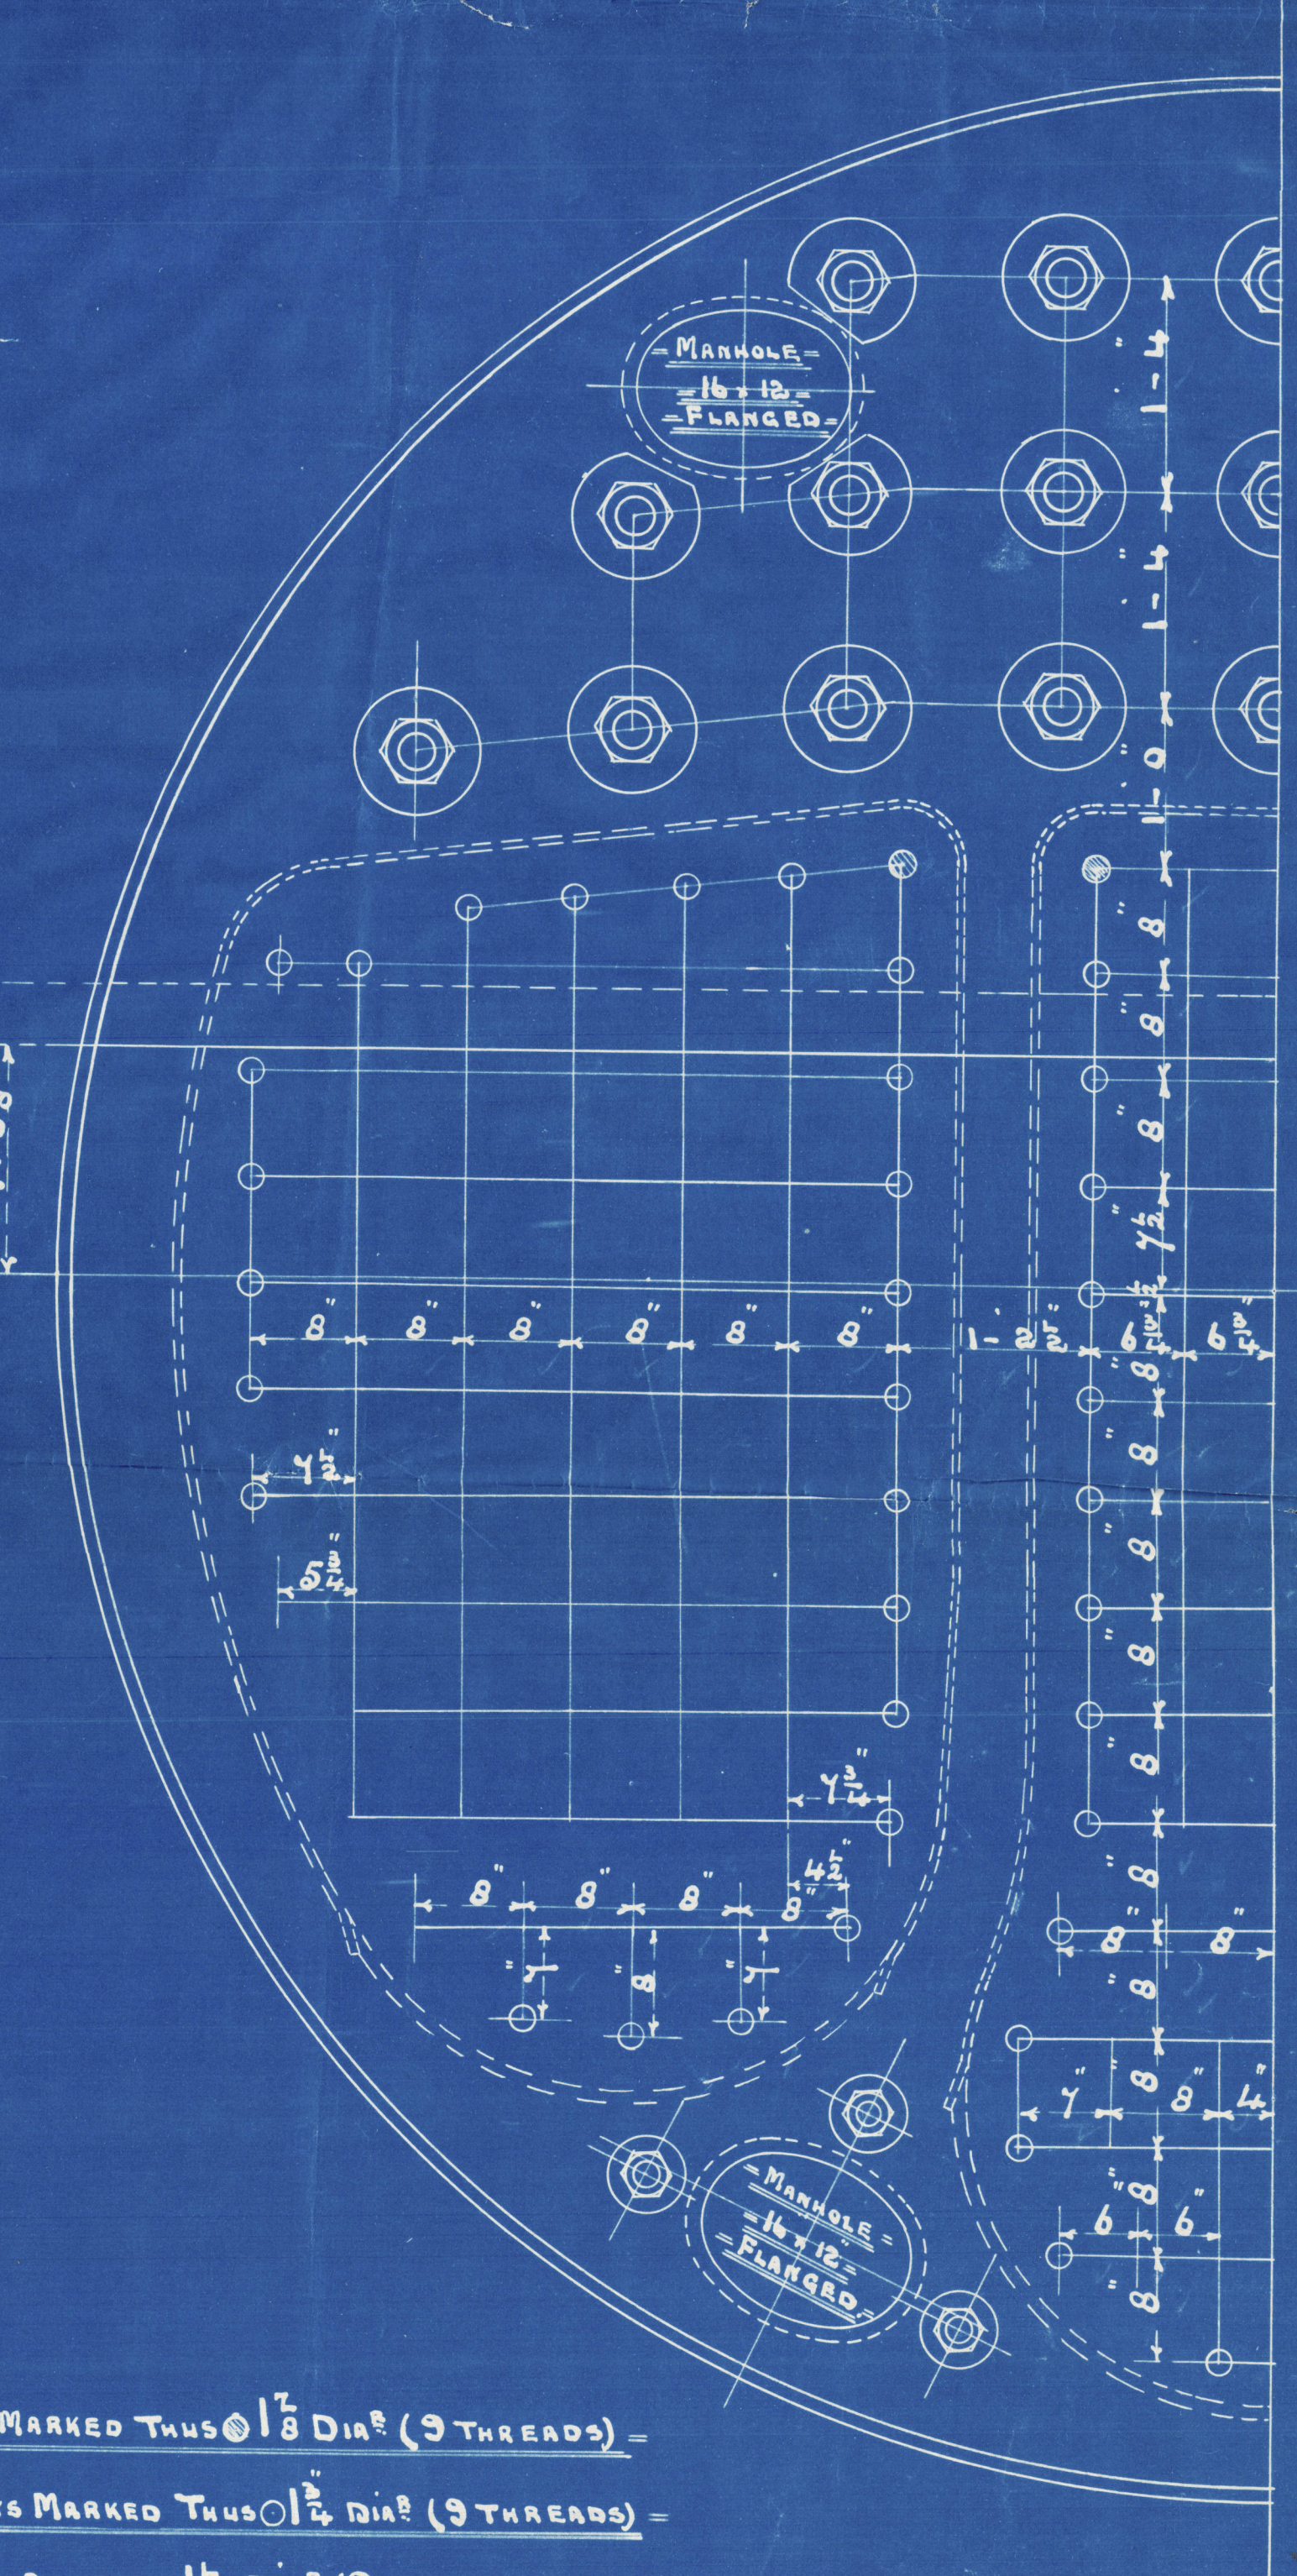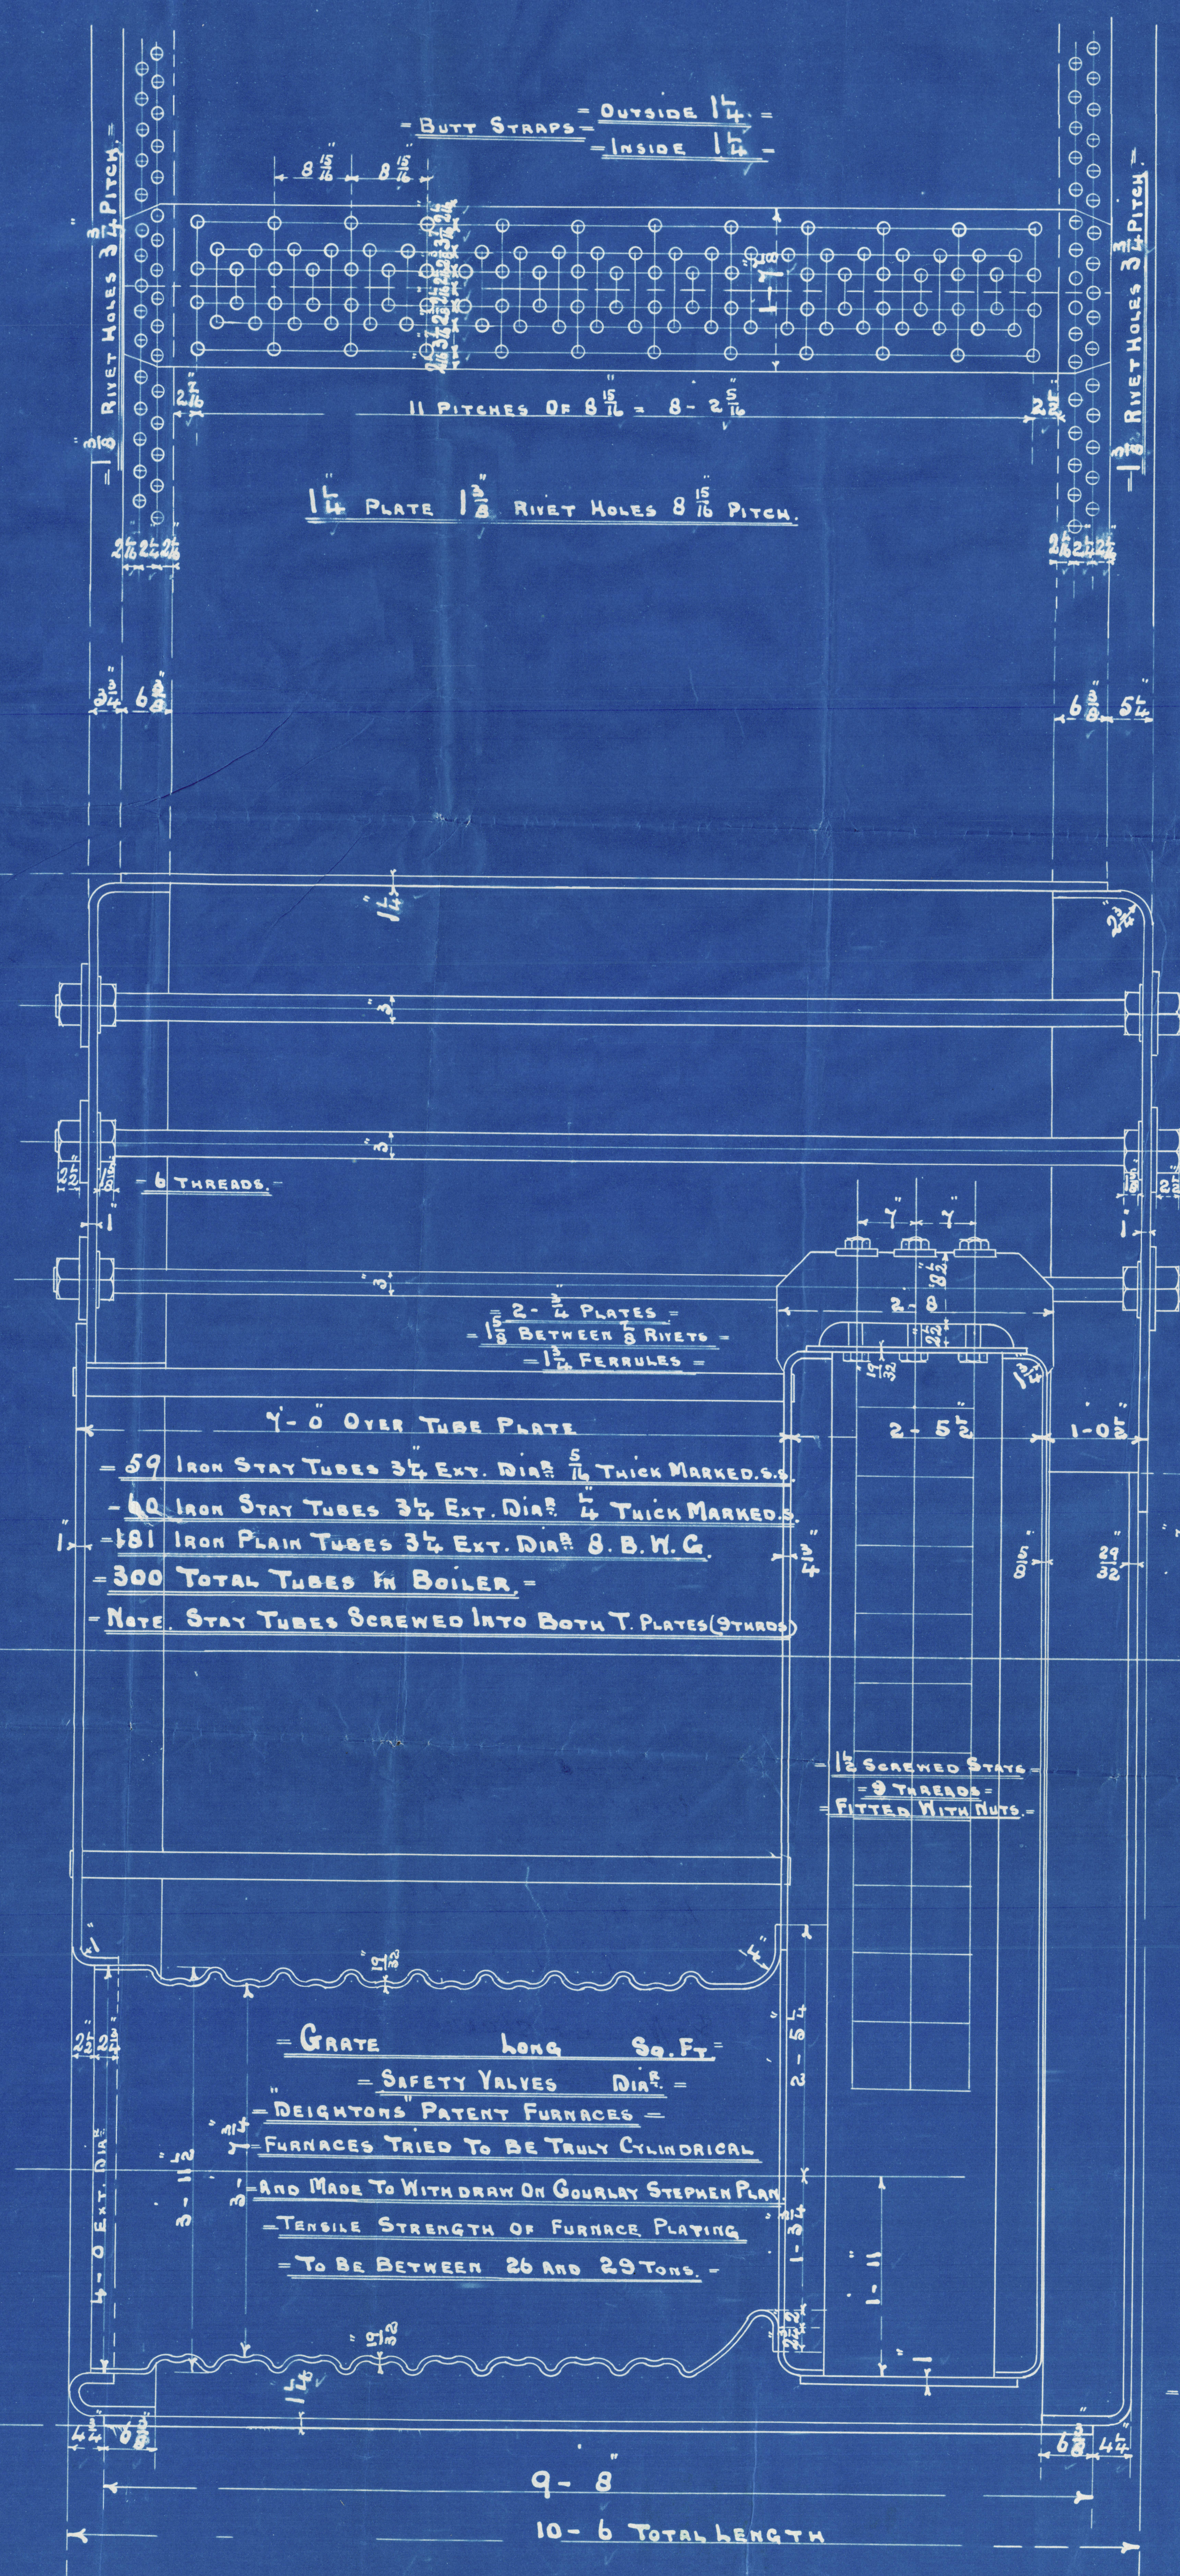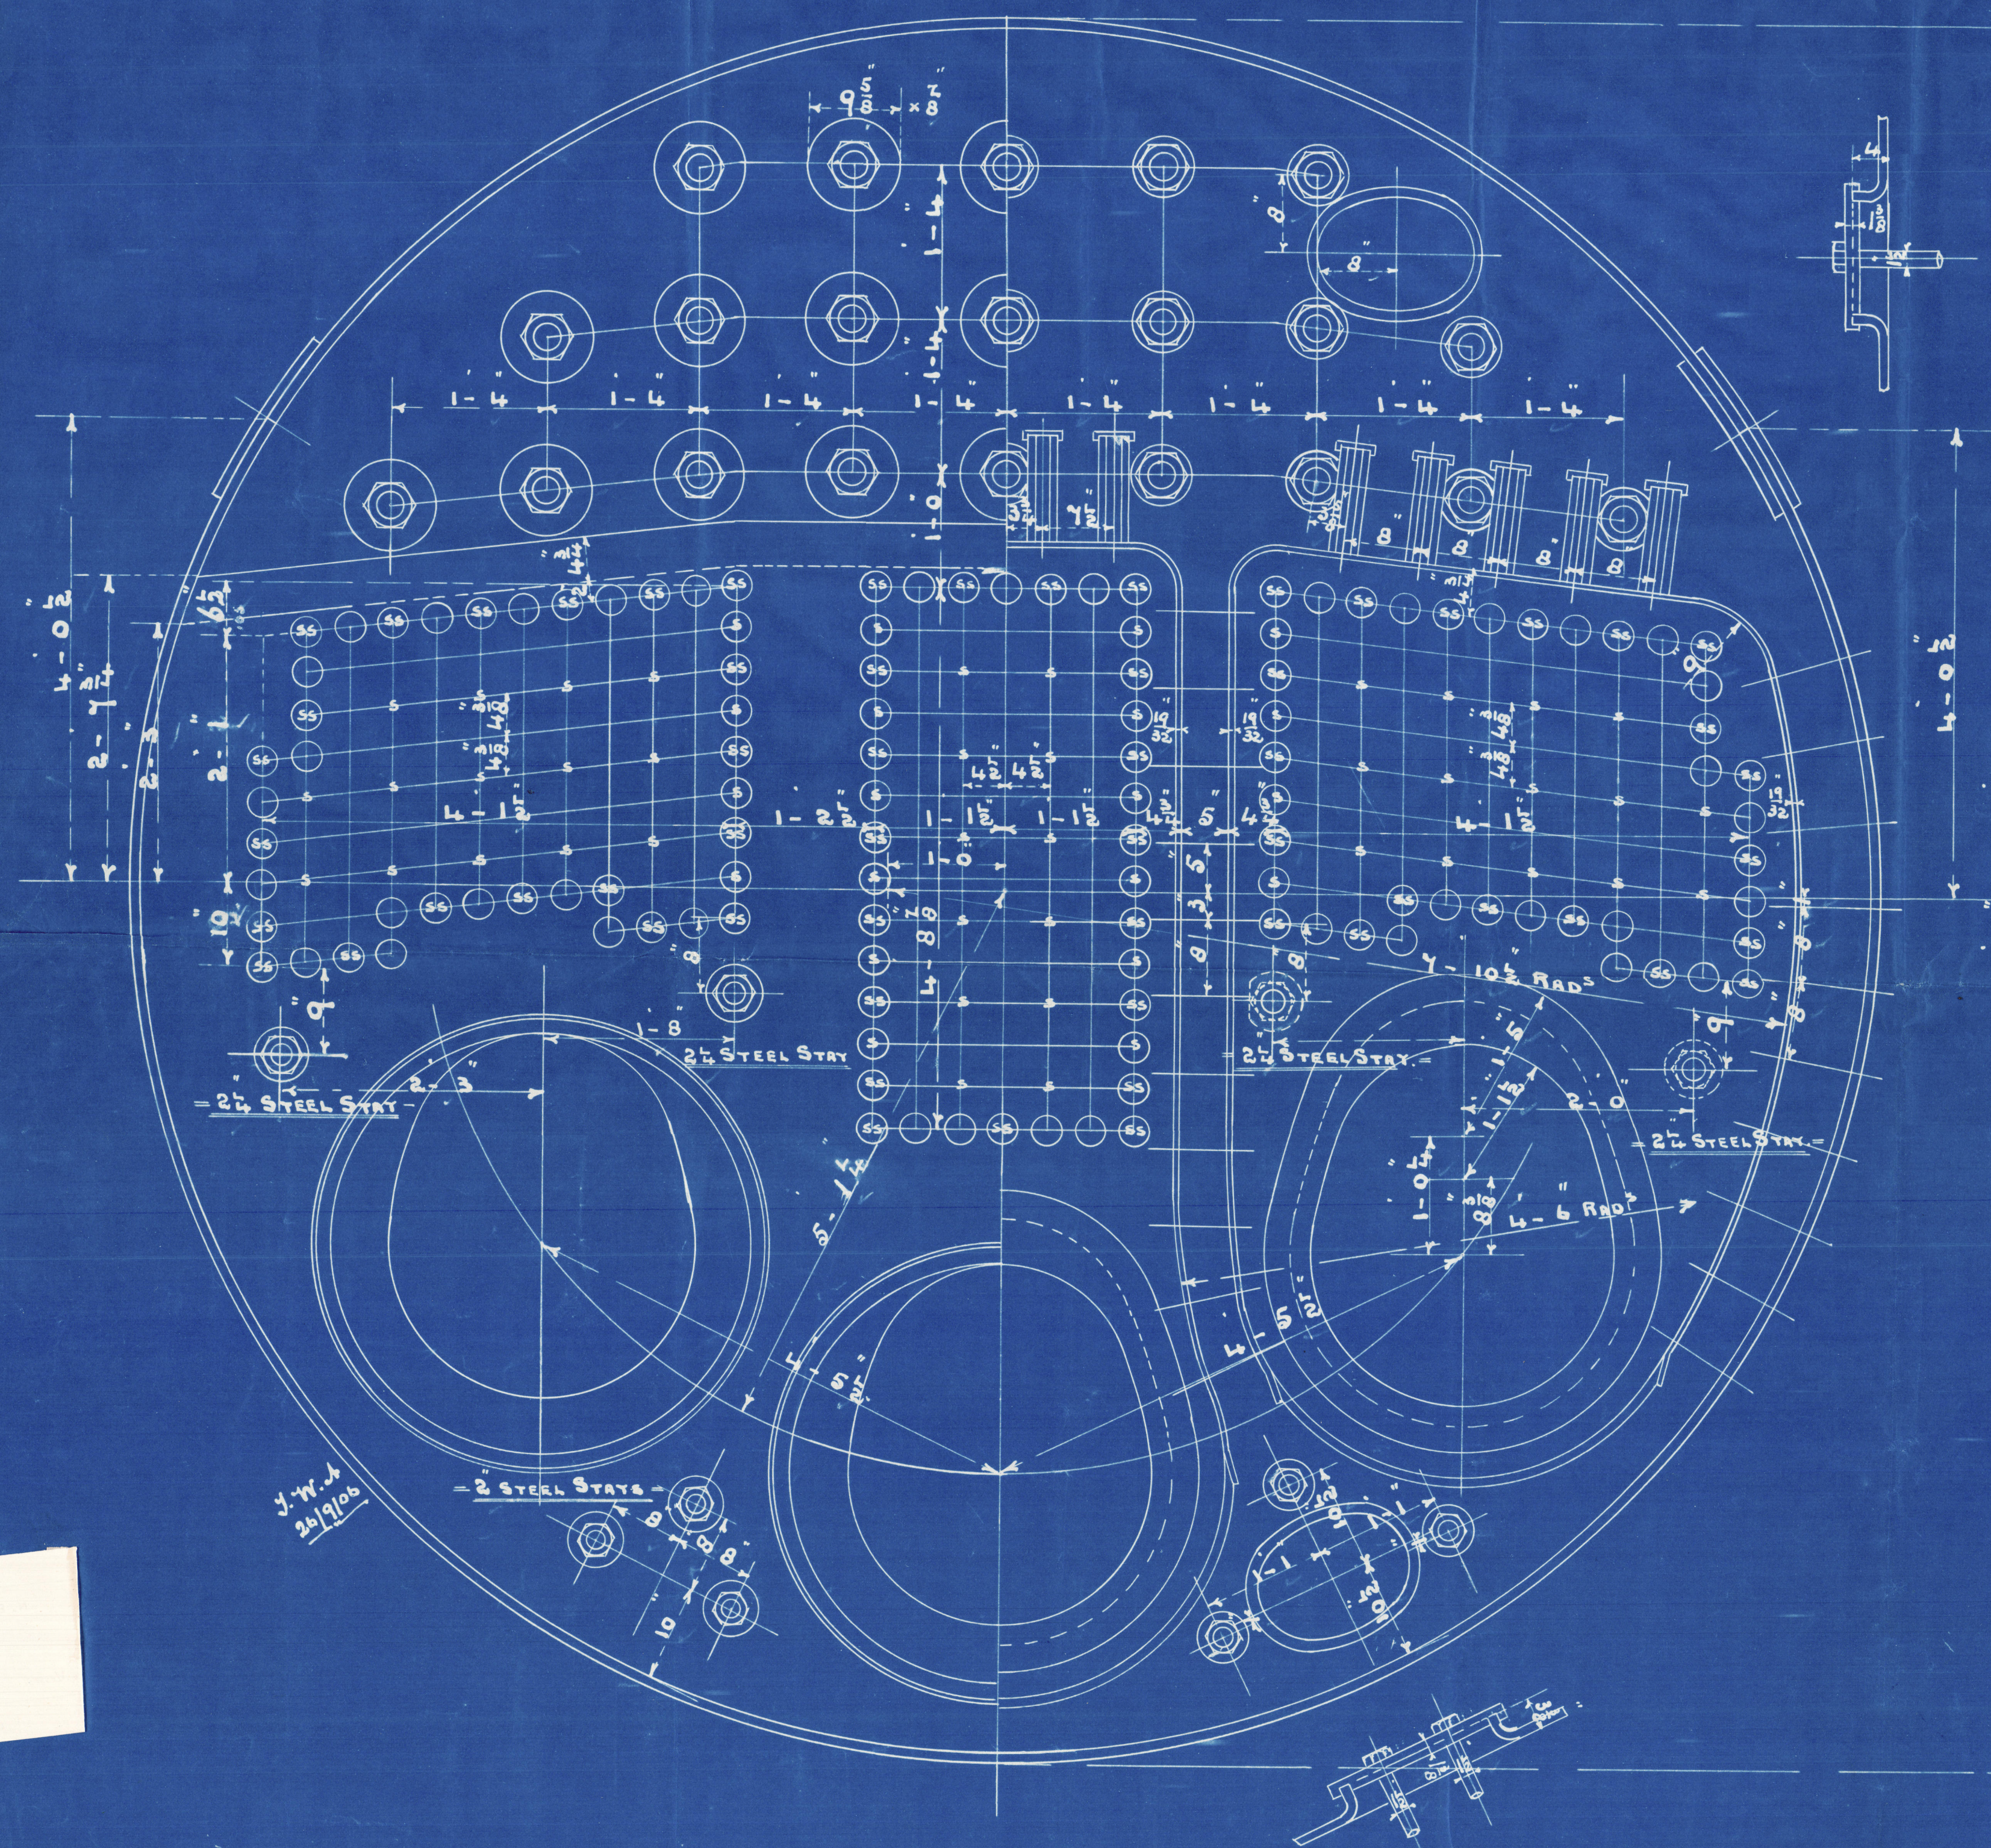

- STAYS MARKED THUS 1 1/2 DIA. (9 THREADS) -  
 - STAYS MARKED THUS 1 1/2 DIA. (9 THREADS) -  
 - ALL OTHERS 1 1/2 DIA. (9 THREADS) -  
 - NOTE. ALL STAYS SCREWED AND FITTED WITH NUTS. -

- 1. THUS -  
 - 1. OPPOSITE HAND. - CONTRACT 1725.



N. E. M. E. Co., LIMITED, WALLSEND.

ENCLOSURE

FOR

Messrs. ....

W718-0093 1/2



Amended  
Autographs to 6°

Nº 33.  $\frac{5}{8}$ .

N.E. M. Eng. & Co. Ltd

Nº 1725

180

S/S Neuenstein

Nº 7432

360

JTF 15.2.07.

Newcastle-on-Tyne.

Nº 52.639

RETAIN

© 2031  
W718-0093



Lloyd's Register  
Foundation