



14-11-22  
A.L. 12

LONGITUDINAL SECTION NO 463 T.S.S.

DIMENSIONS 469'-10" x 60'-0" x 43'-7" TO SHELTER DECK

SCALE 1/8" = ONE FOOT

Plan of deck houses to be submitted

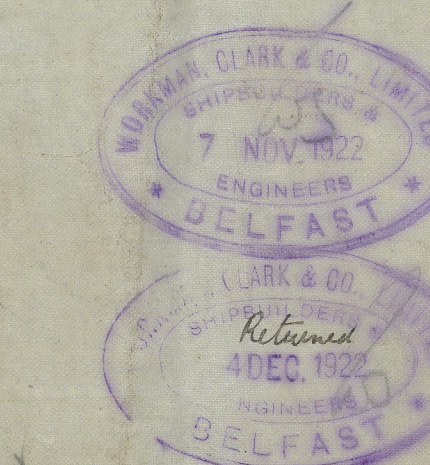 



Workman Clark & Co.

N<sup>o</sup> 463.

Profile

S<sup>d</sup> Post Willington

Blk. 9057.

W72-0040



© 2020

Lloyd's Register  
Foundation