


24.6.09.
11.8.09.
30.9.09.

Handwritten notes:
24.6.09.
11.8.09.
30.9.09.

—Longitudinal Section No 289 J.S.S.—
—Dimensions 477'0" x 60'9" x 34'1" to Upper Deck.—
—To class 100 A.I. Lloyds Three Decks.—
—Scale 1/8" = 1 Foot.—

 

0 2 4 

C.B.
24.6.09

14 FEB 1910
25 JAN 1910
18 JUN 1909

Workman Clark.

N^o 289

Profile

Rangation
Del by 32.


8
3100 3 50' - 35' x 7' 1/2"






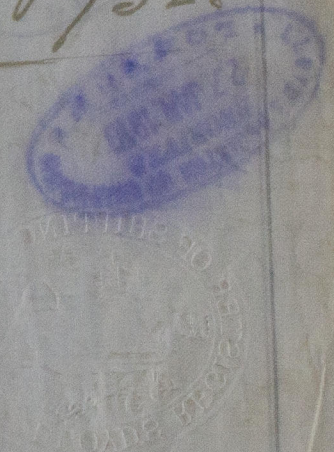

© 2020

Lloyd's Register
Foundation

289

0054
Lloyd's Register
Foundation