


24.6.09
11.8.09


No 289 TSS
ARRANGEMENT OF BEAMS & PLATING OF SHELTER, UPPER AND 2ND DECK.
SCALE $\frac{1}{8}$ = 1 FOOT

DECK PLATING BUTTS - DOUBLE RIVETED FOR $\frac{1}{2}$ LENGTH ^{under}
RIVETING: - TREBLE - MARKED ^{over} - 16. 7 over.
- AT ENDS SINGLE WITH UNDER - 14.



SHELTER DECK

 

UPPER DECK

 

2ND DECK

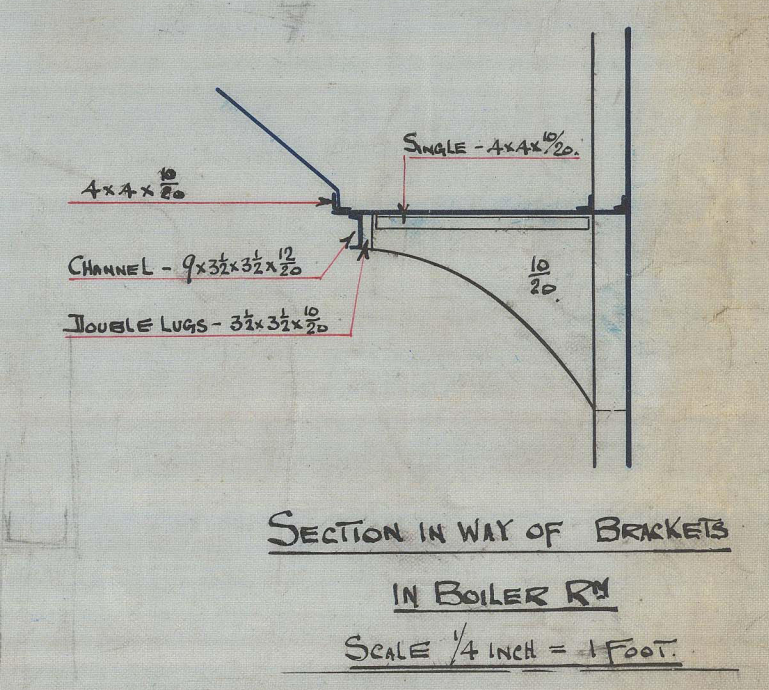 

C.B.
24.6.09

For
approved
J.P.M.
24.6.09



Deck Plans.

Rangatira
Rel 6732.

W720-0055

Lloyd's Register
Foundation