

13690

146/09

HEATING SURFACE
420 TUBES 3" O.D. X 22' EXT DIA = 2200
4 FURNACES " X 40" MEAN = 126
1st AND SIDES OF FIREBOXES = 175
FIREBOX BACKS = 68
BACK TUBE RATES = 49
FRONT " " = 40
TOTAL H.S. IN ONE BOILER = 2718
" " " IN 5 BOILERS = 13590
FIVE = 13590

GRATE SURFACE
4 FURNACES 38" INT DIA X 5' 3" BAR = 66.66
TOTAL G.S. IN 5 BOILERS = 333.33
FIVE = 333.33

H.S. = 4077 T.S. = 33
G.S. = 4077 T.S. = 33

STEAM SPACE IN ONE BOILER FROM 9" ABOVE THE FIREBOX TOP = 4.23
HEIGHT OF WATER (FEET) = 28.75
DRAUGHT AREA THROUGH THE TUBES = 9.7

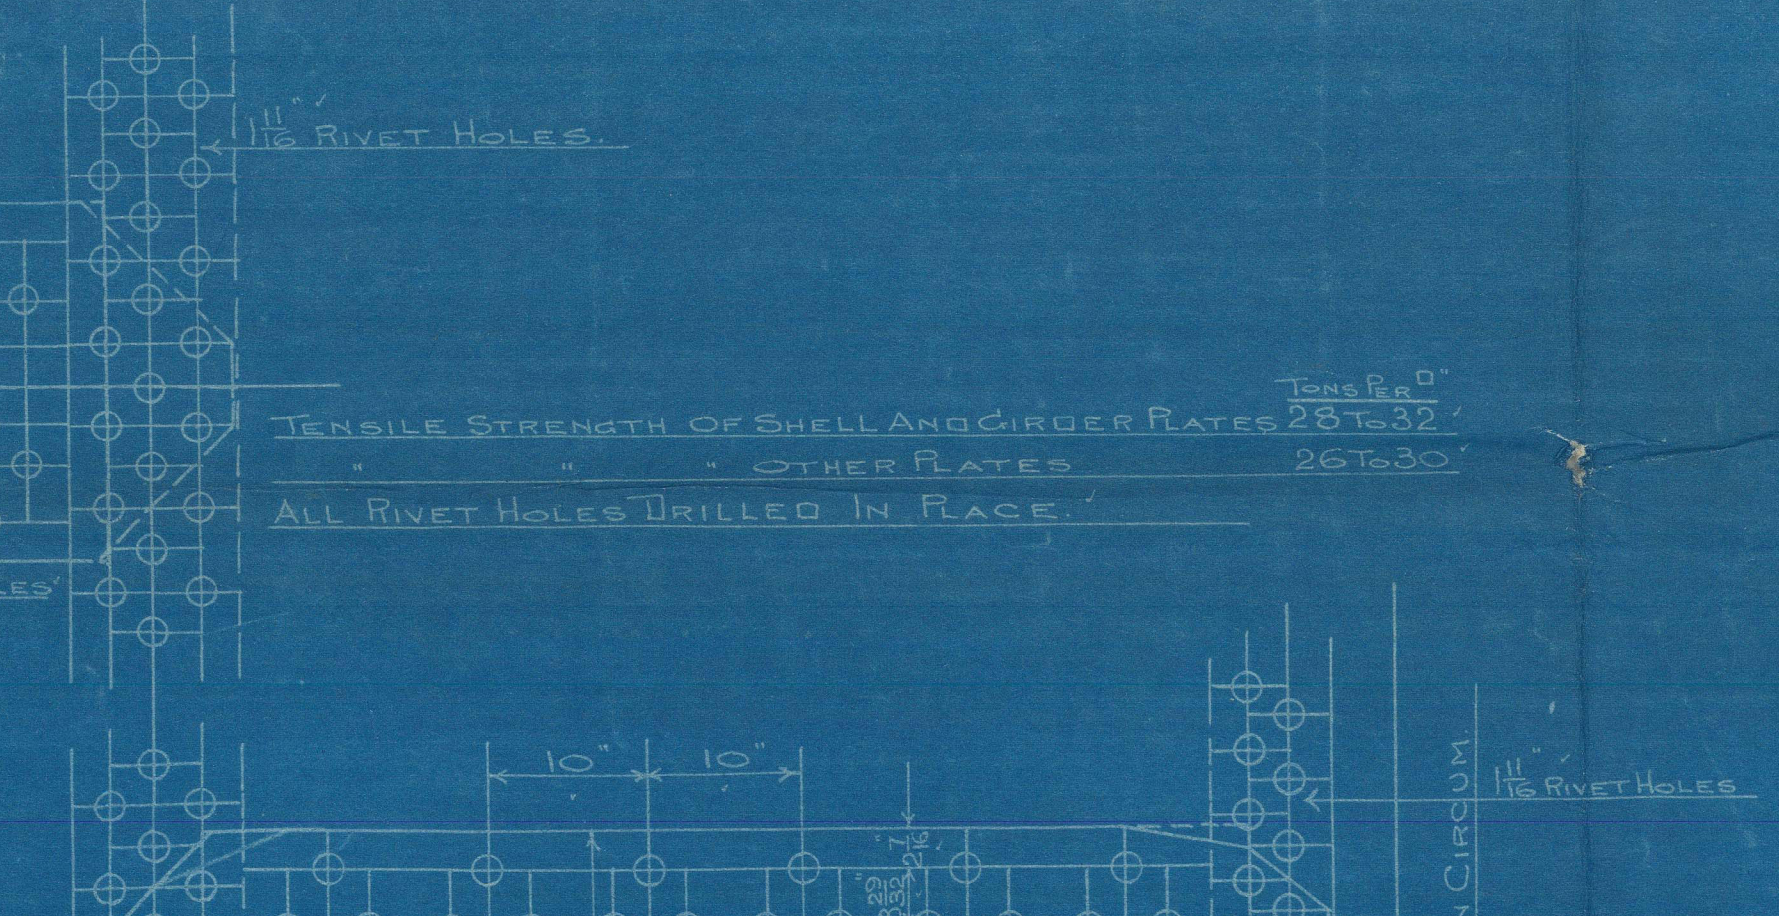
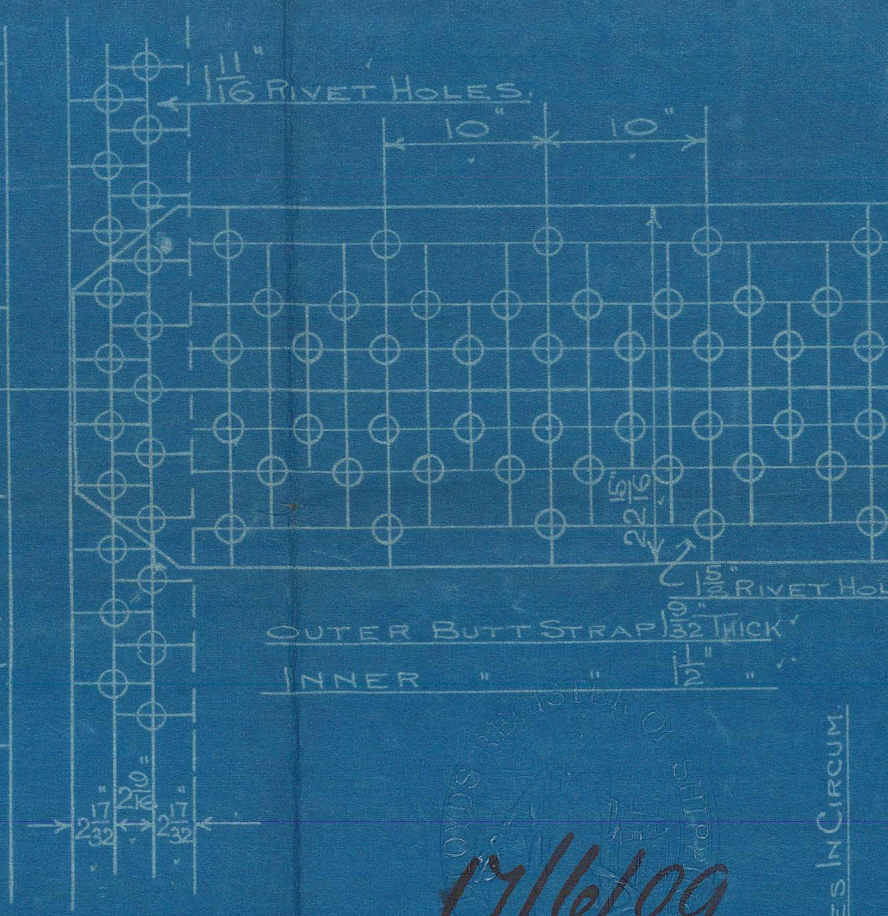
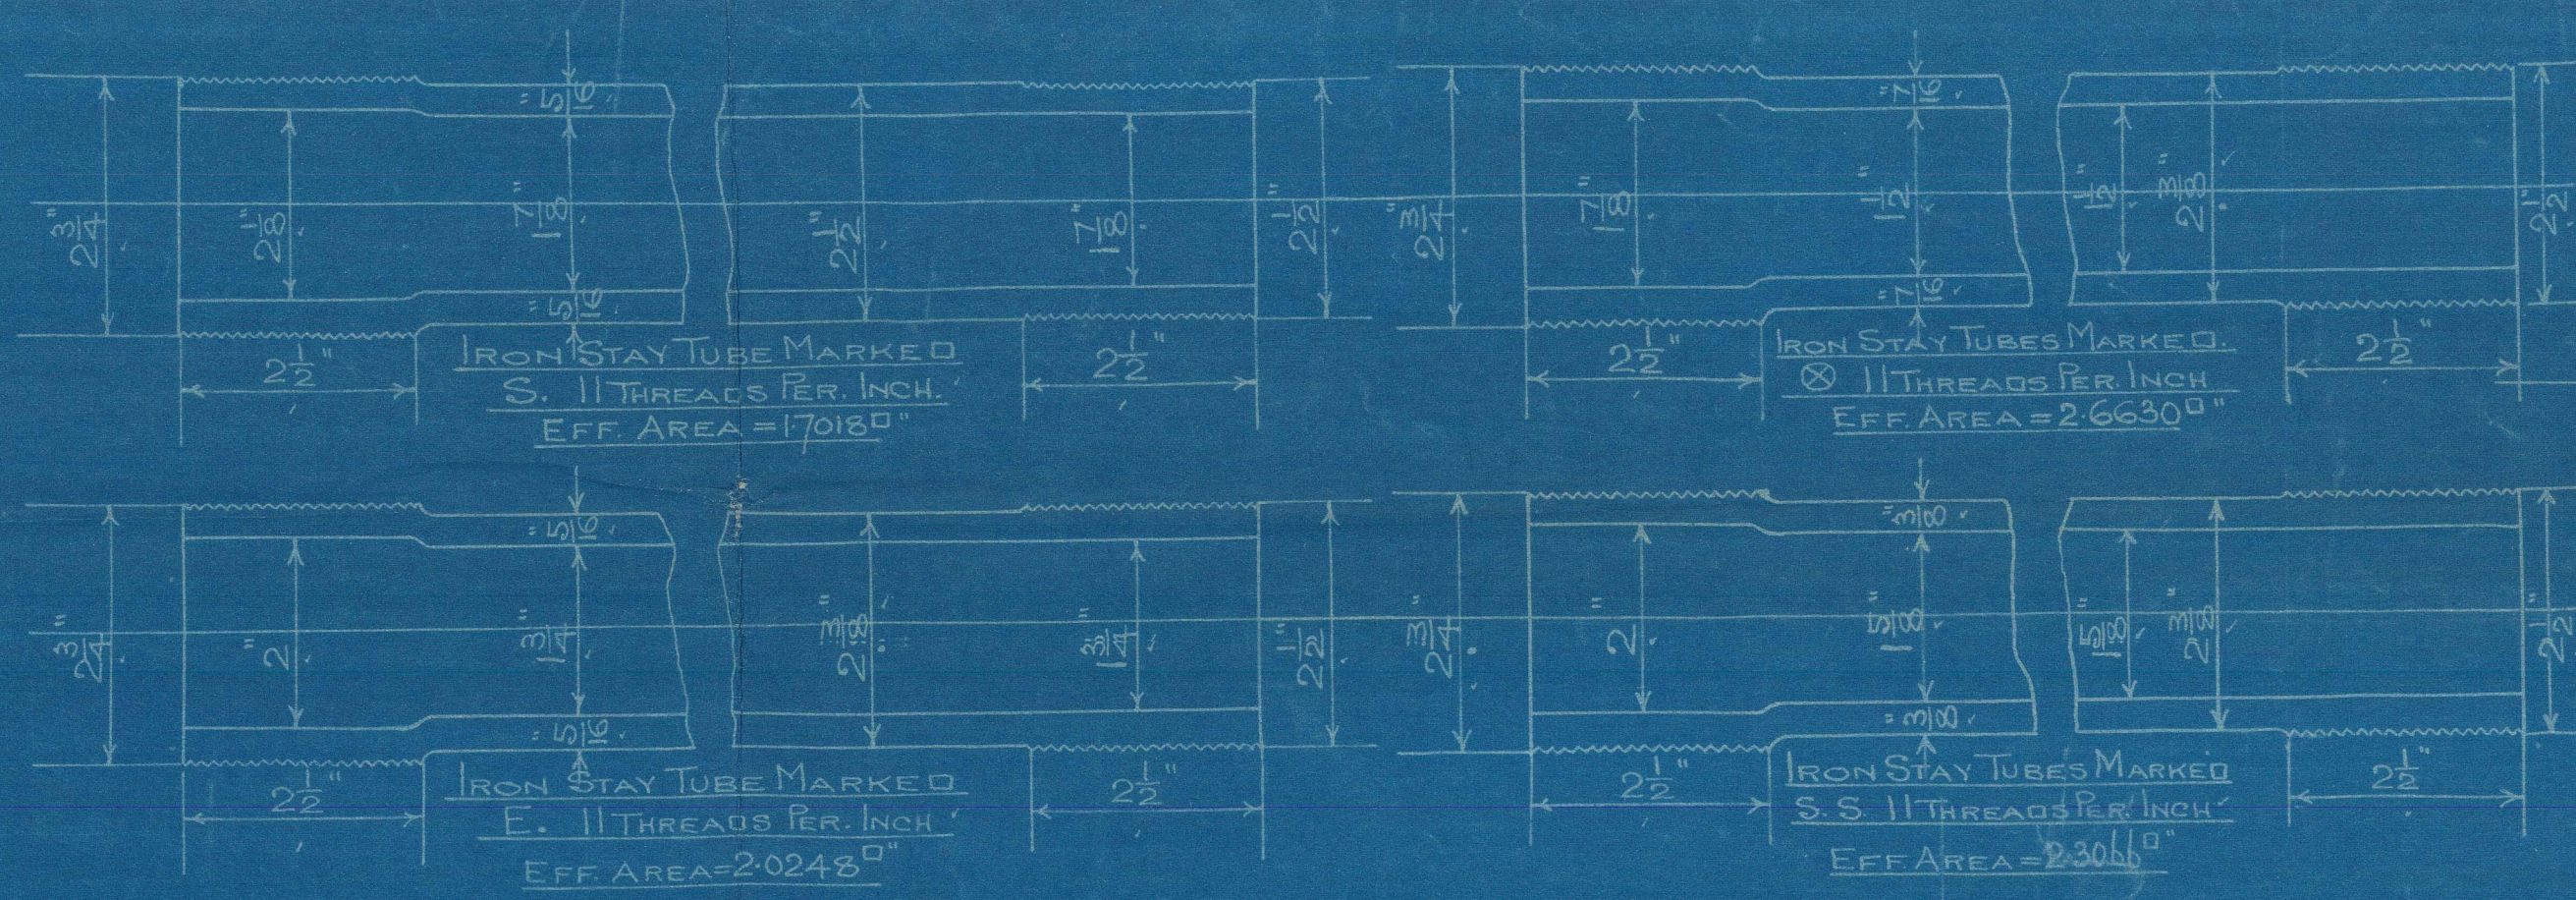


PLATE LIST No 277					PLATE LIST CONT No 277				
No	DESCRIPTION	LENGTH	WIDTH	THICKNESS	No	DESCRIPTION	LENGTH	WIDTH	THICKNESS
1	A SHELL	27'-9"	7'-0"	1/2"	1	G COVER BACK TUBE	10'-0"	2'-0"	1/2"
2	B " "	27'-9"	7'-0"	1/2"	2	H " "	12'-0"	1'-0"	1/2"
3	C " "	27'-9"	7'-0"	1/2"	3	S COVER FIREBOX BACK	10'-0"	2'-0"	1/2"
4	D " "	27'-9"	7'-0"	1/2"	4	T " "	12'-0"	1'-0"	1/2"

1	STAY BAR LIST - STEEL			
2	STEAM SPACE STAYS	12'-0"	3/8"	1/2"
3	" " " "	12'-0"	3/8"	1/2"
4	" " " "	12'-0"	3/8"	1/2"
W720-0056 (1 of 2)

For Enclosure to

Lloyd's

Registered
Foundation

FRONT

TOTAL H. S. IN C

Belfast
Workman Clark & Co
L.S. 289

Main Barrels
L.S. "Pangloss"
16 21 1909
L.L. 6732.

RETAIN



© 2020

Lloyd's Register
Foundation
(2 of 2)