

S.S. WAR KNIGHT


Union Iron Works's

No 132

Alameda: Cal.

Midship Section
of vessel as built.

San Jo: Report No. 2525.

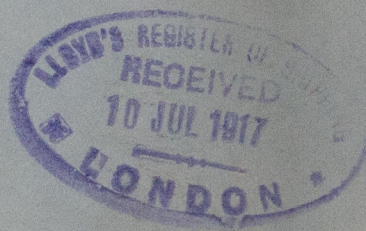

W721 - 0127



© 2020

Lloyd's Register
Foundation