


MARINE ENGINES NO 1740

MESSRS. S. R. RAYLTON DIXON & CO. LTD. 55, N. 571.

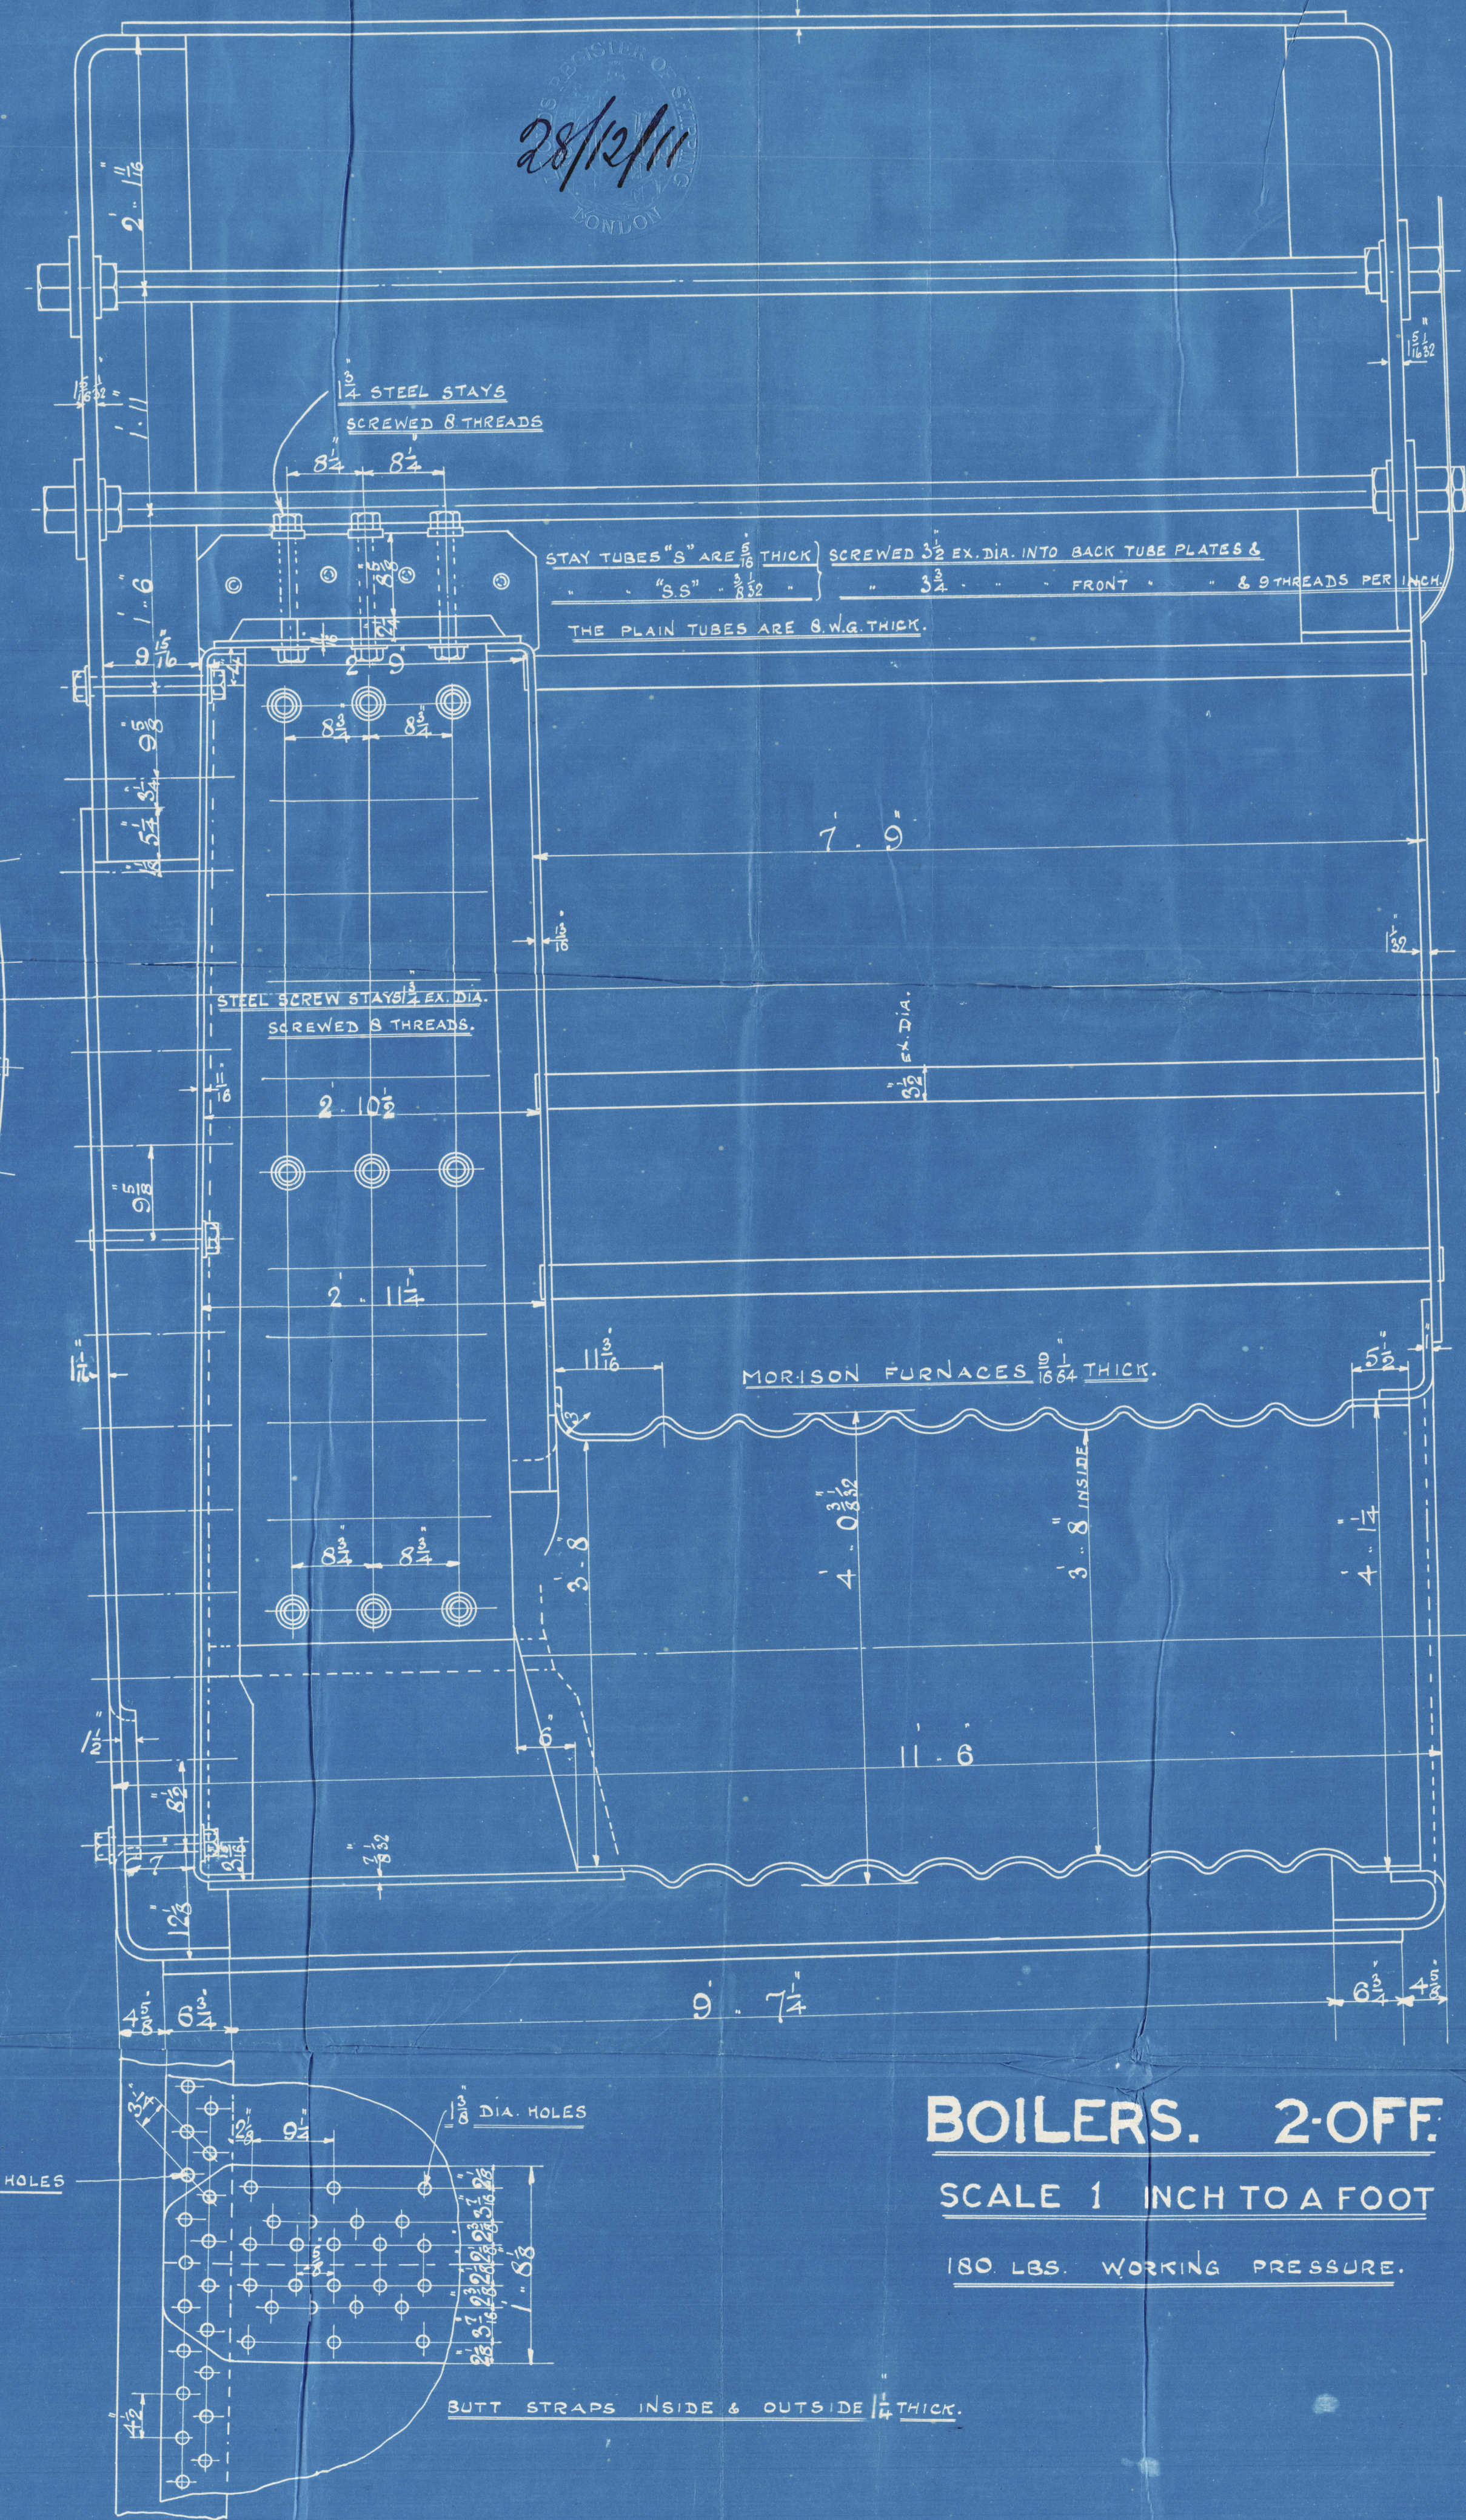

BOILERS. 2-OFF.

SCALE 1 INCH TO A FOOT

180 LBS. WORKING PRESSURE.

TOTAL HEATING SURFACE IN TWO BOILERS. 5983 SQ. FEET.

GRATE

THE MINIMUM TENSILE STRENGTH OF SHELL AND GIRDER PLATES IS TAKEN AT 28 TONS PER SQ. INCH.

APR 28 1911

BLAIR & COY., LTD.
 ENGINEERS,
 22 DEC 11
 STOCKTON-ON-TEES.

B.2859

1775

Dec. 22nd

1911

From BLAIR & CO., Ltd.,
STOCKTON-ON-TEES.

To Messrs Lloyds Engineer Surveyors
© Middlebro


Boilers

Engines No 1740.

B2859

W722-0106 1/2

Thames Boilers
Messrs Blair & Co Ltd
No 1740

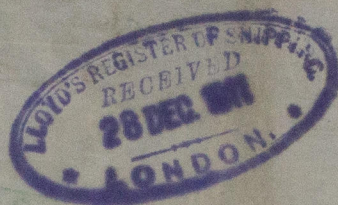


for
Messrs Sir Raylton Dixon & Co
S.S. No 571

Working Press 180 lbs

No.	4878
LLOYD'S TEST	
360 lbs.	
20.5.12 - WM	

S. S. Warley Pickering
Rept. Report 7500

Duplicate of No 1680
Indt Rpt No 6452

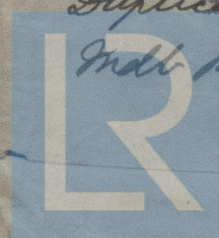

Lloyd's Register
Foundation