
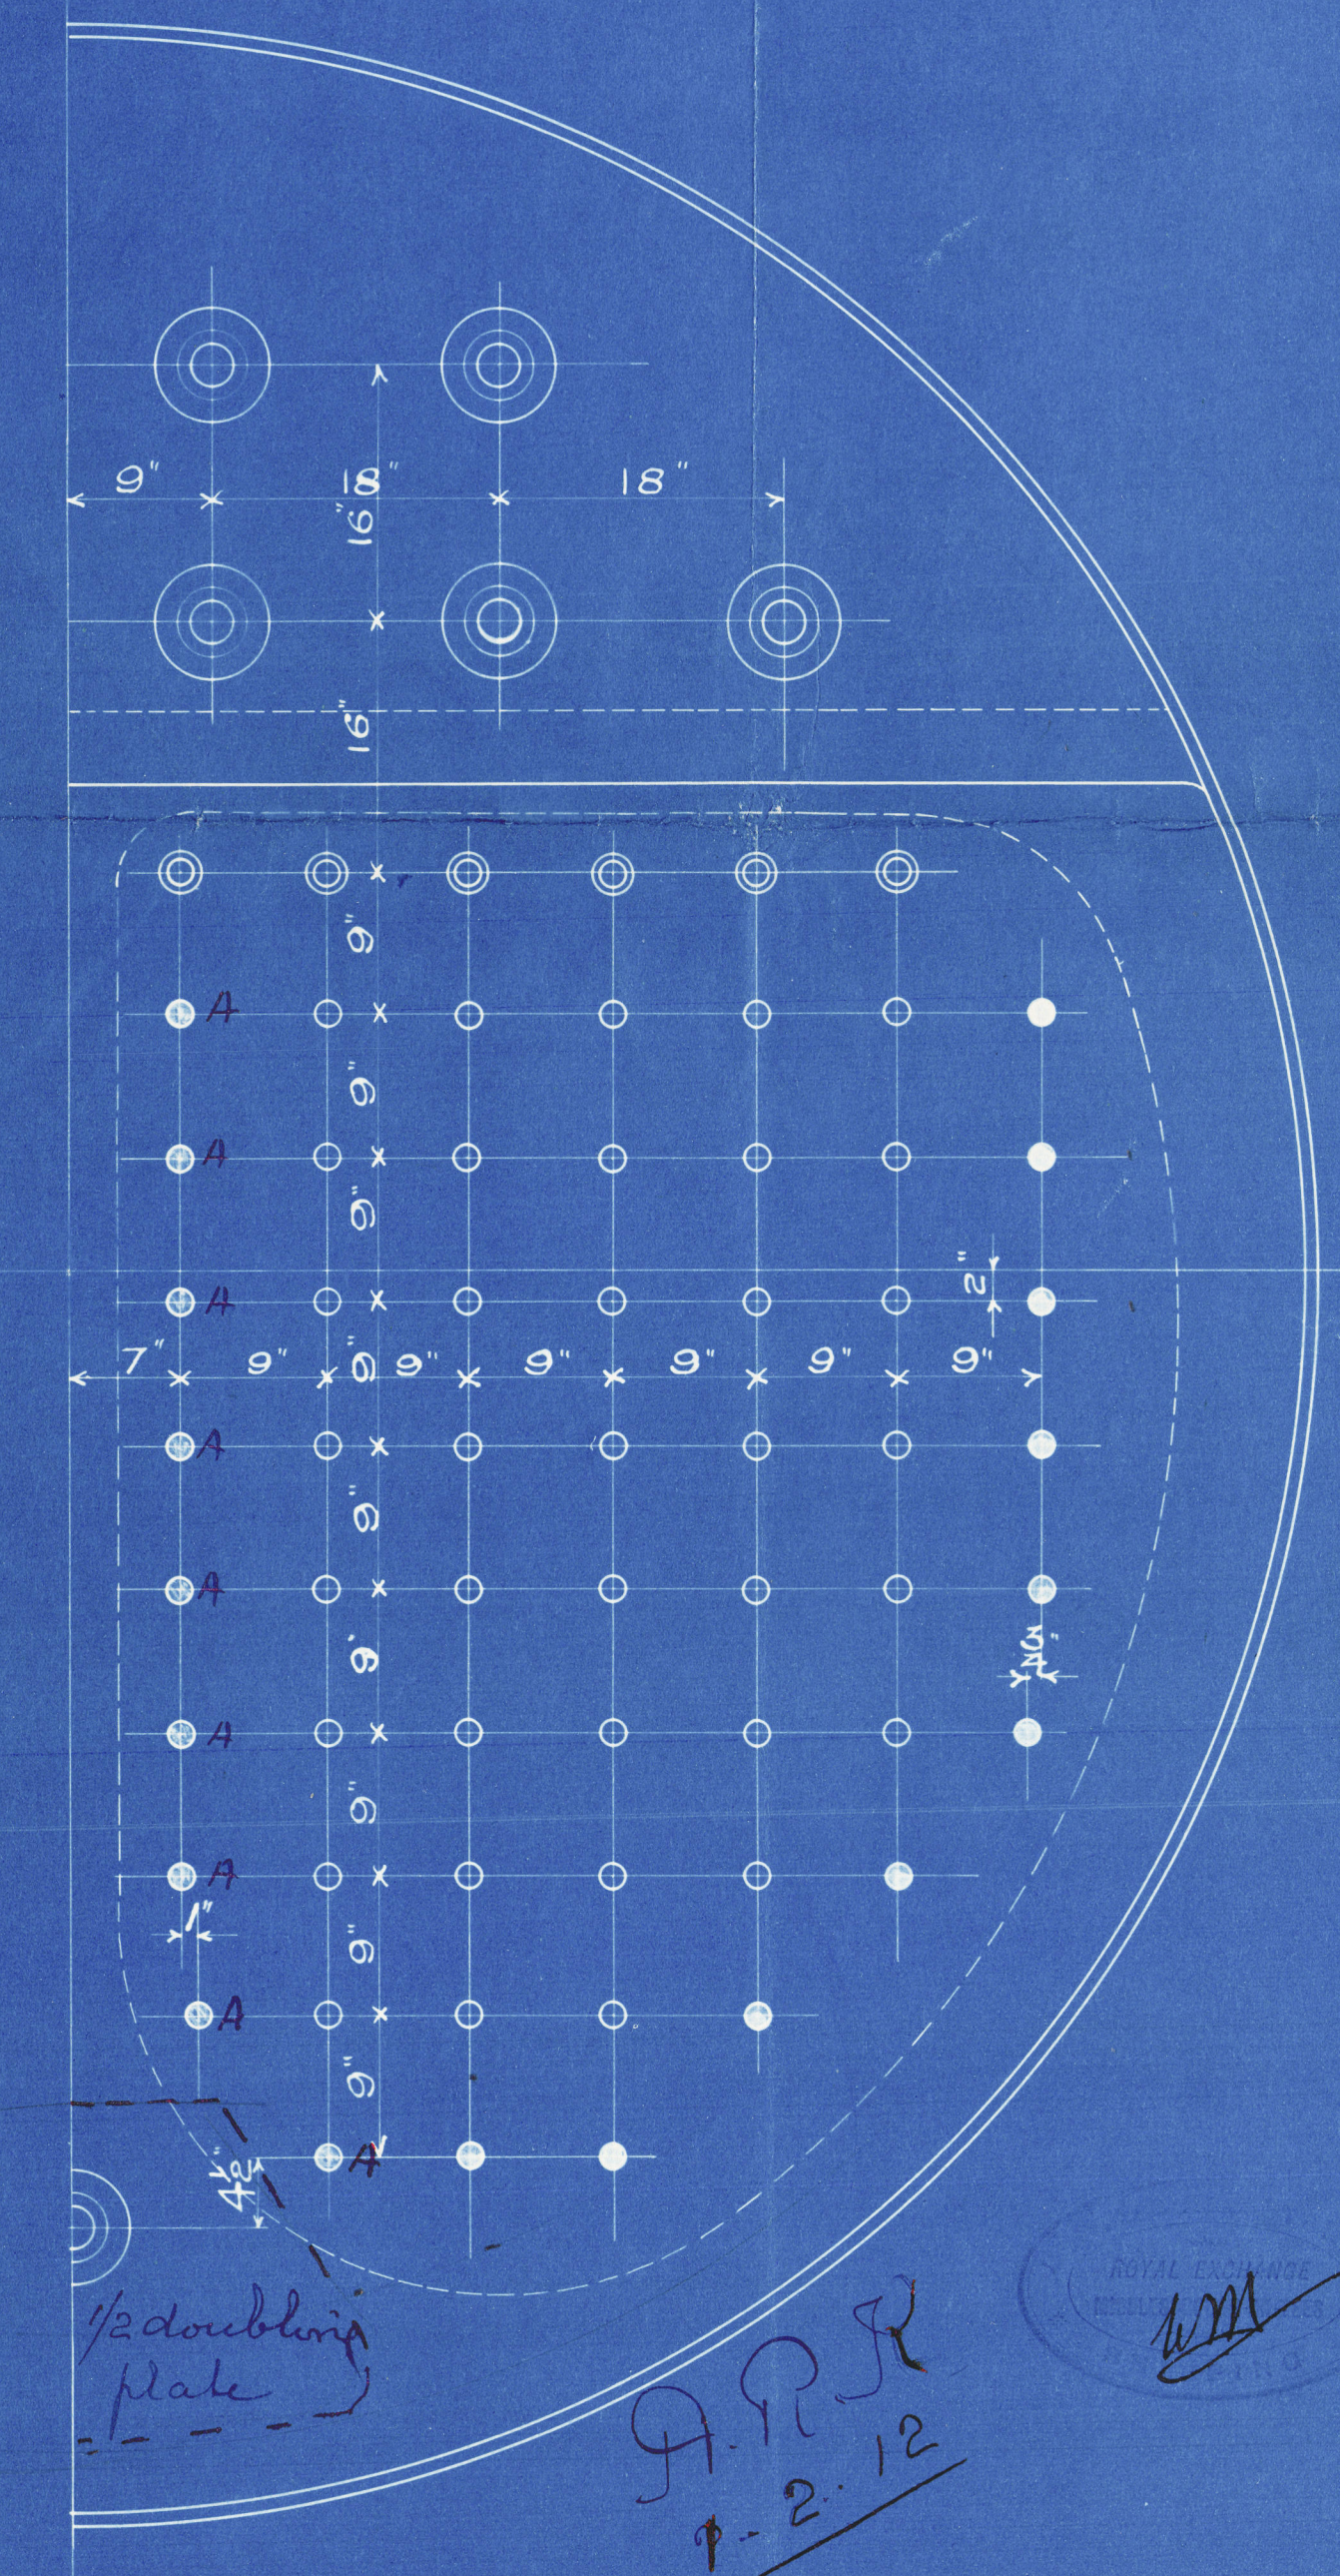
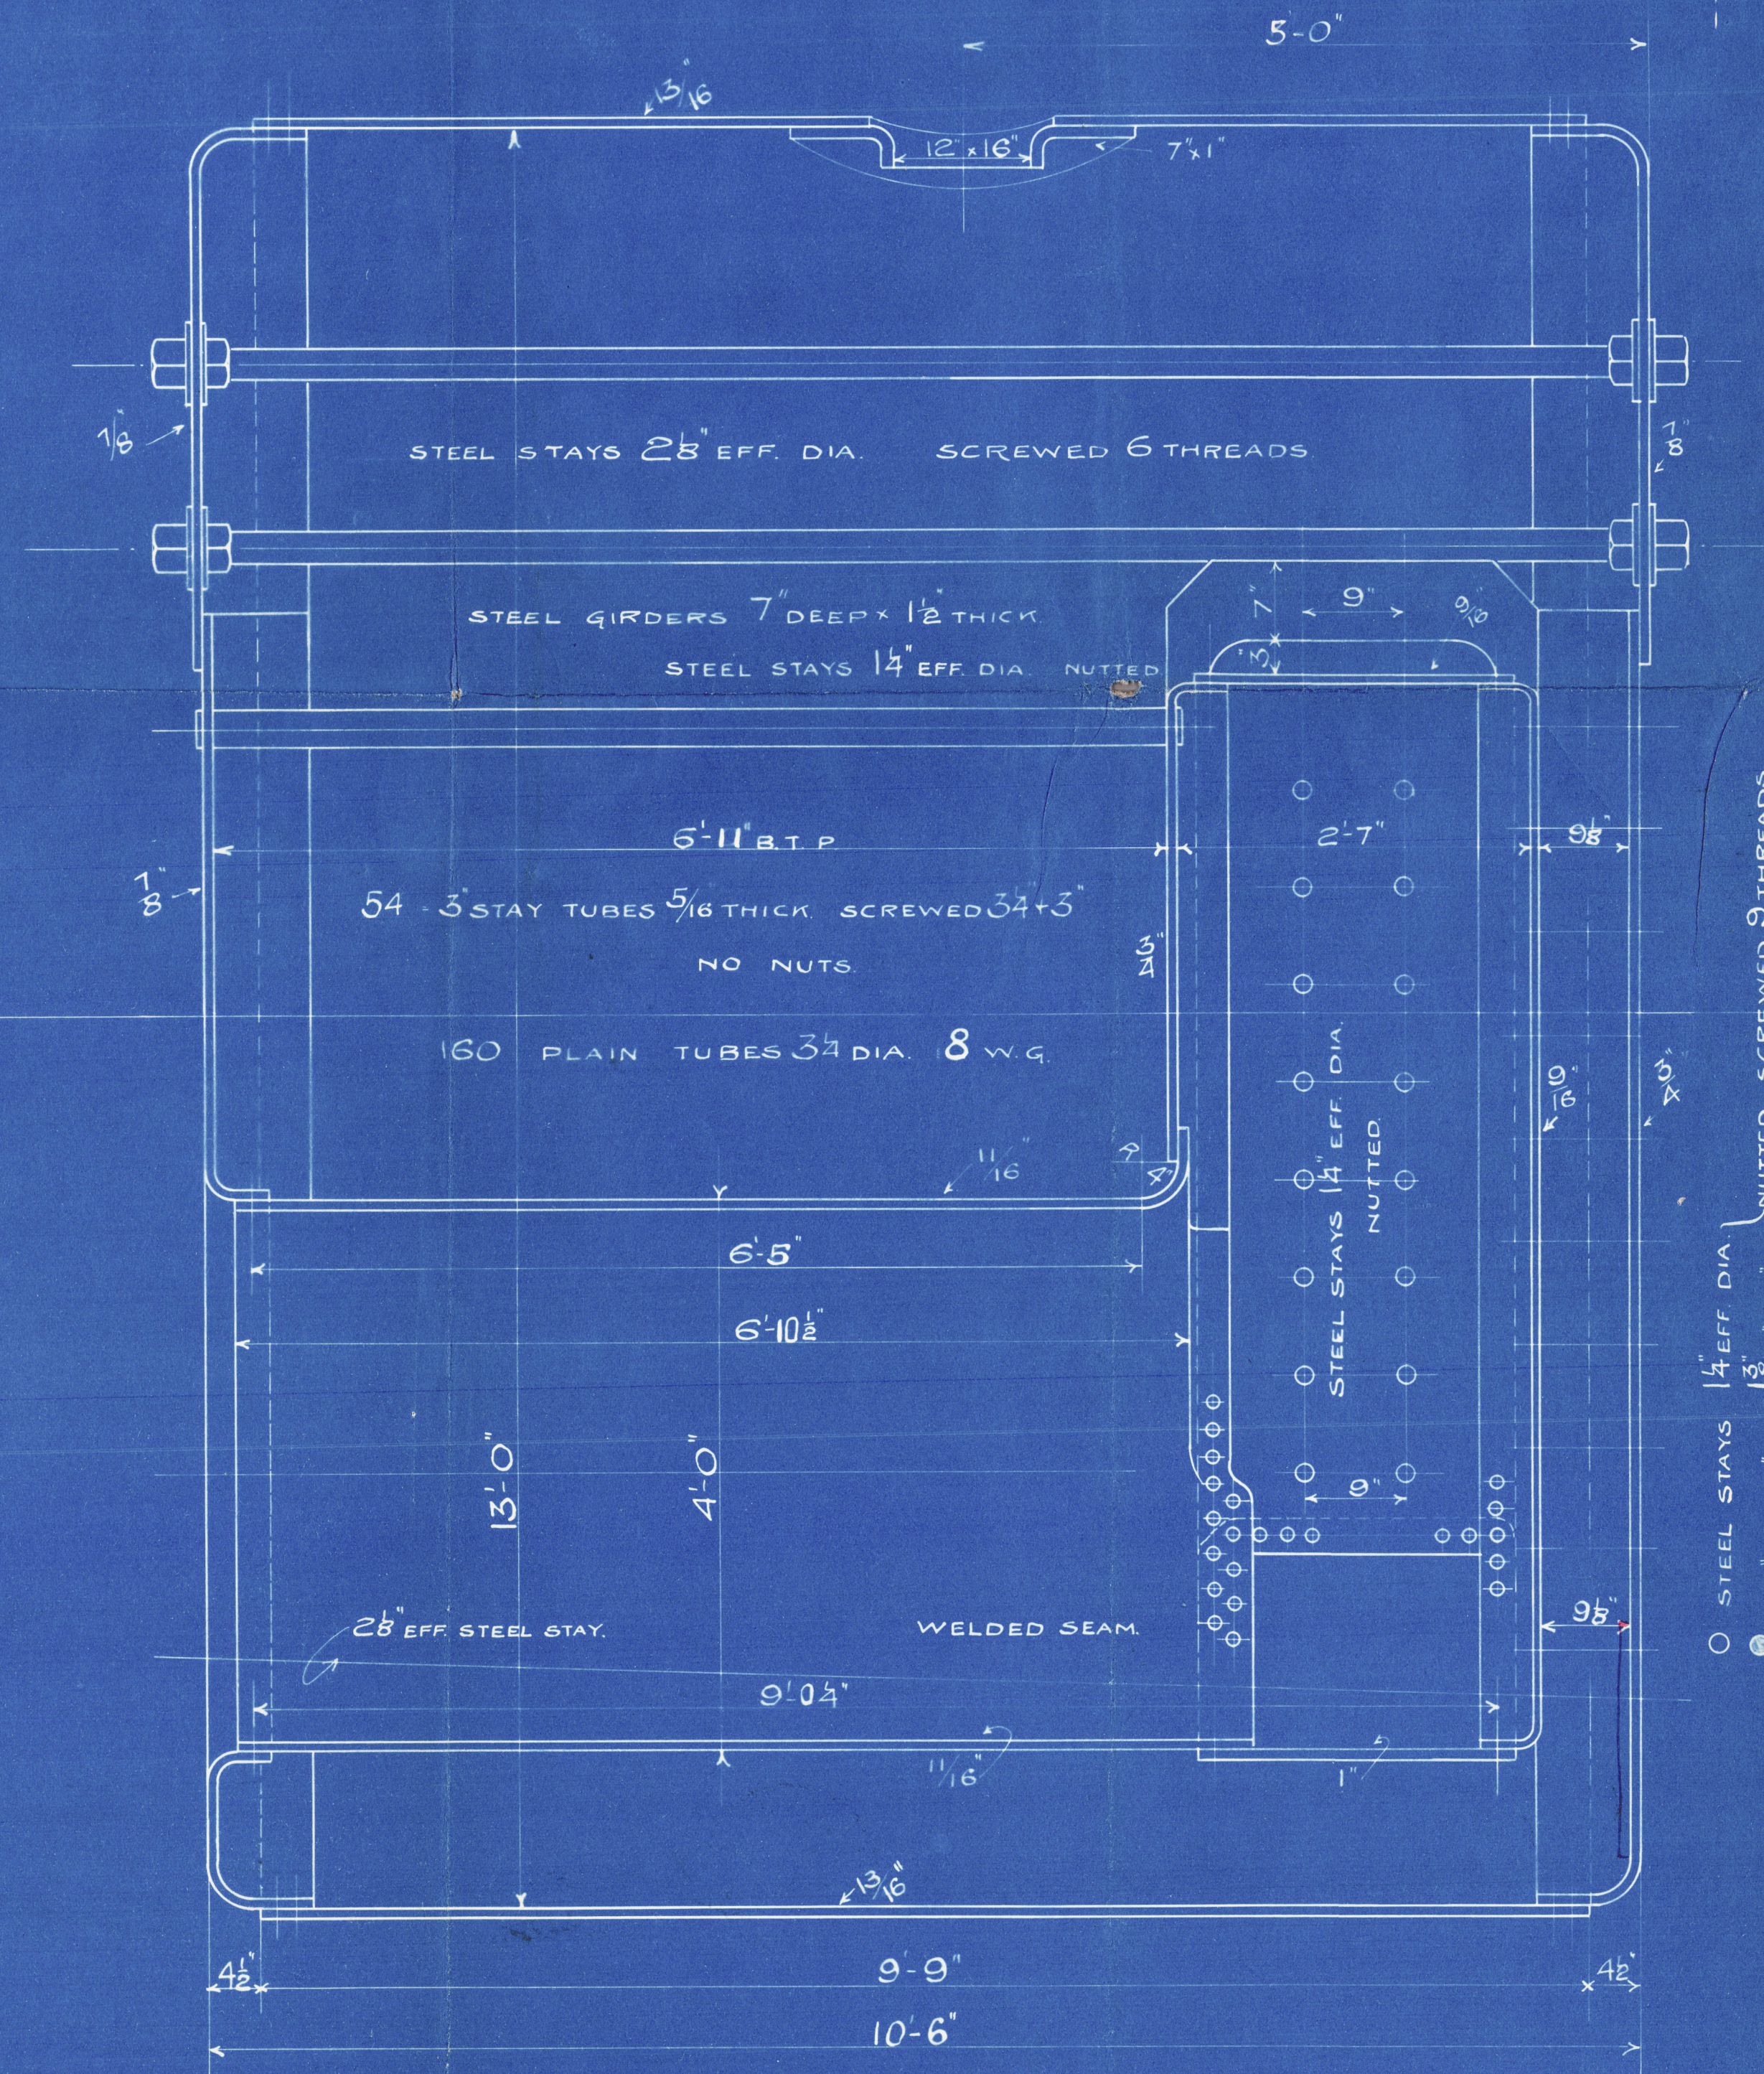
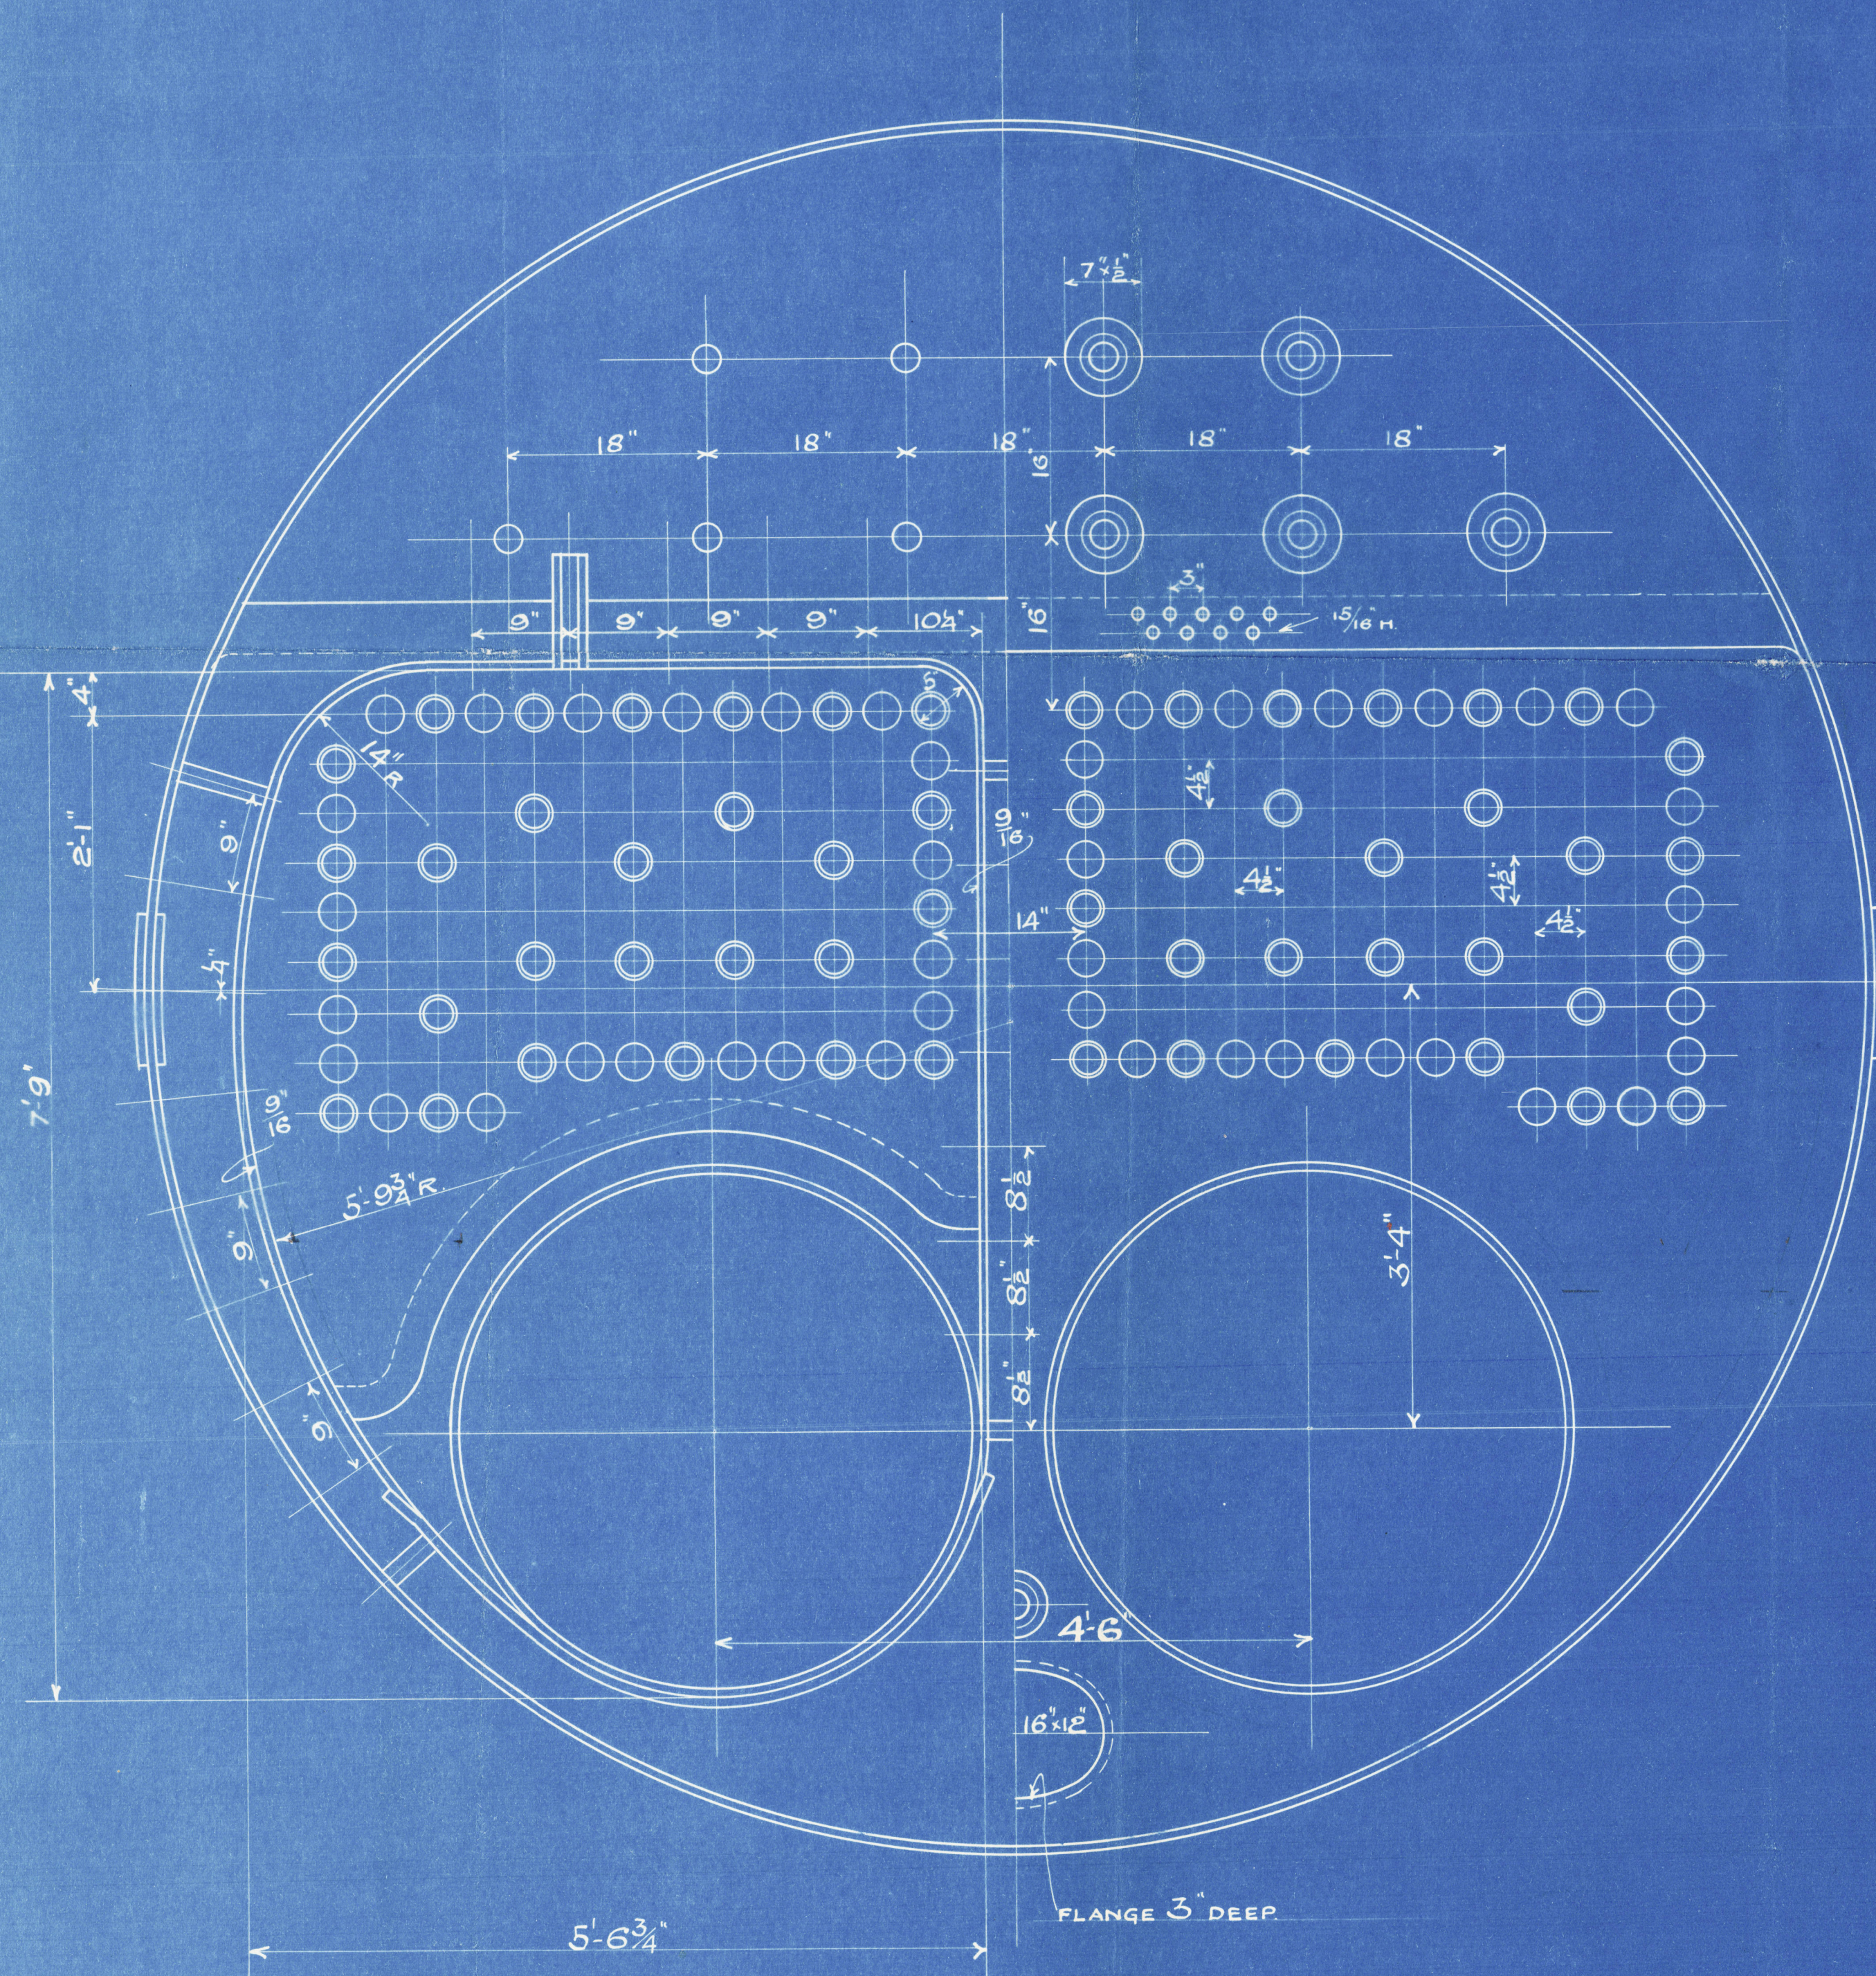


STEEL BOILER 13'-0" DIA 10'-6" LONG 120 LBS W.P.

LLOYDS
4422

RILEY BROS. (BOILERMAKERS) LTD.
STOCKTON ON TEES.

1/2/12

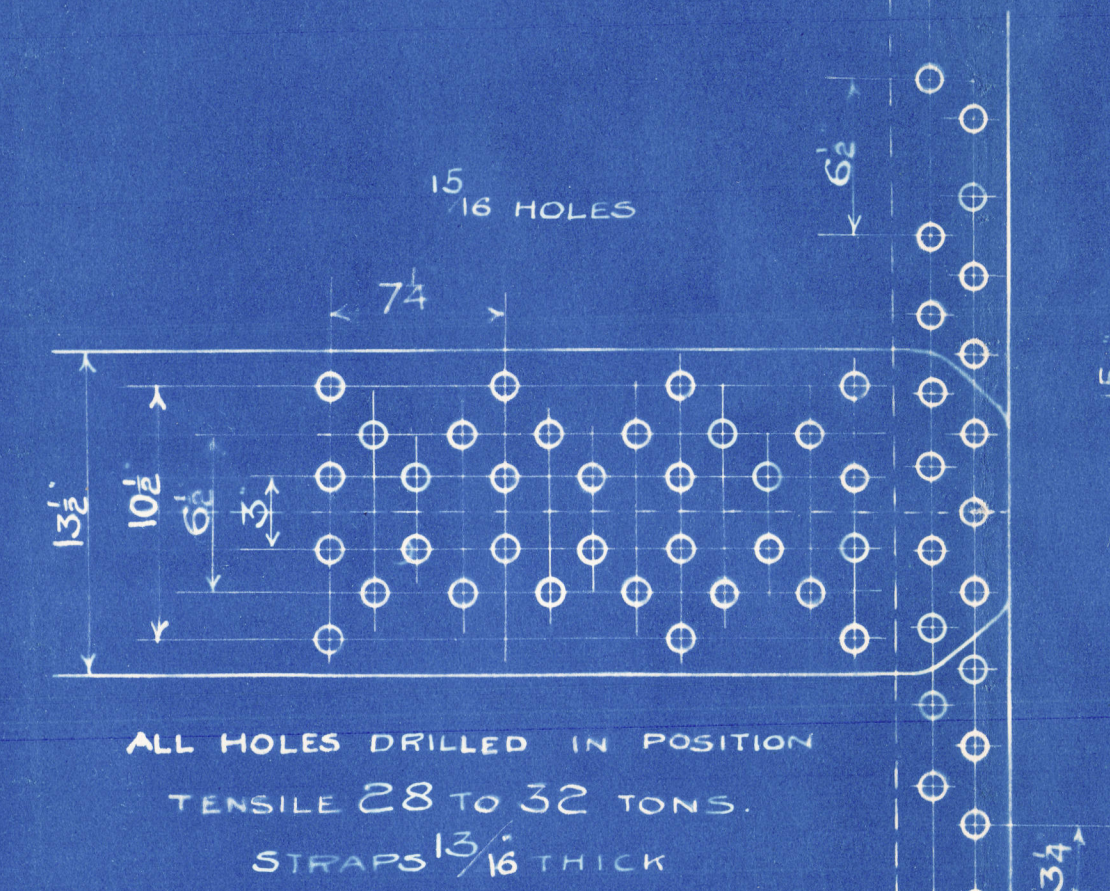

HEATING SURFACE : 1580 sq ft
GRATE AREA (5-6 BAR) 422 sq ft

A.P.R.
1-2-12

ROYAL LLOYD'S REGISTER

Thoson Wiley Bros Ltd
Boiler No 4422
for

Thoson Sir Raylton Dixon & Co
S.S. No 571

Working Press 120 lbs
Mdb. Report 7438



No.	4200
LLOYD'S TEST	
240 lbs	
27.6.12 - WM	



© 2020

Lloyd's Register
Foundation

W722-0107