

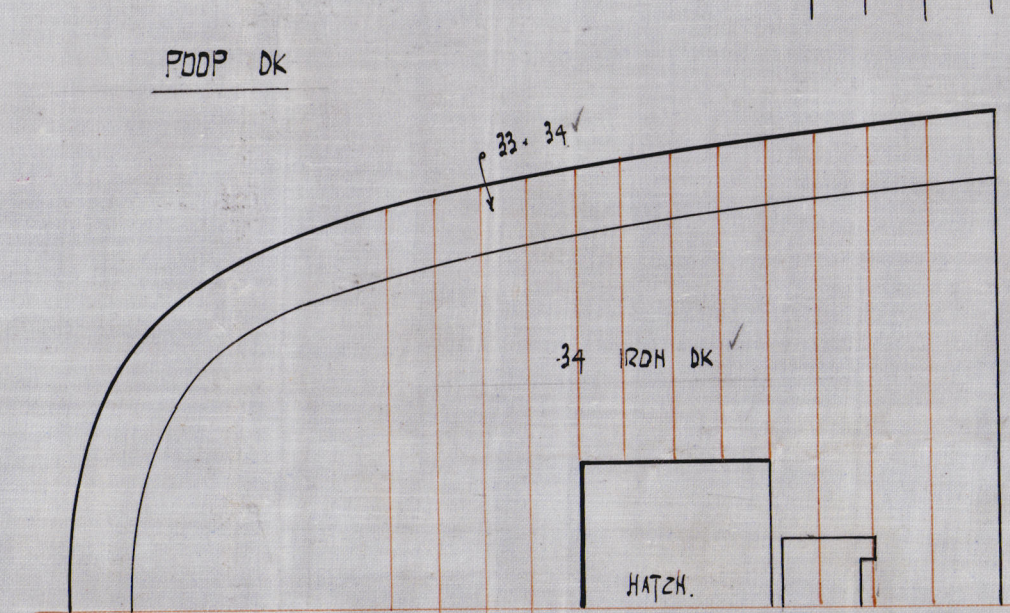





26.10.11
16.11.11
23.11.11
18.12.11
11.1.12
31512

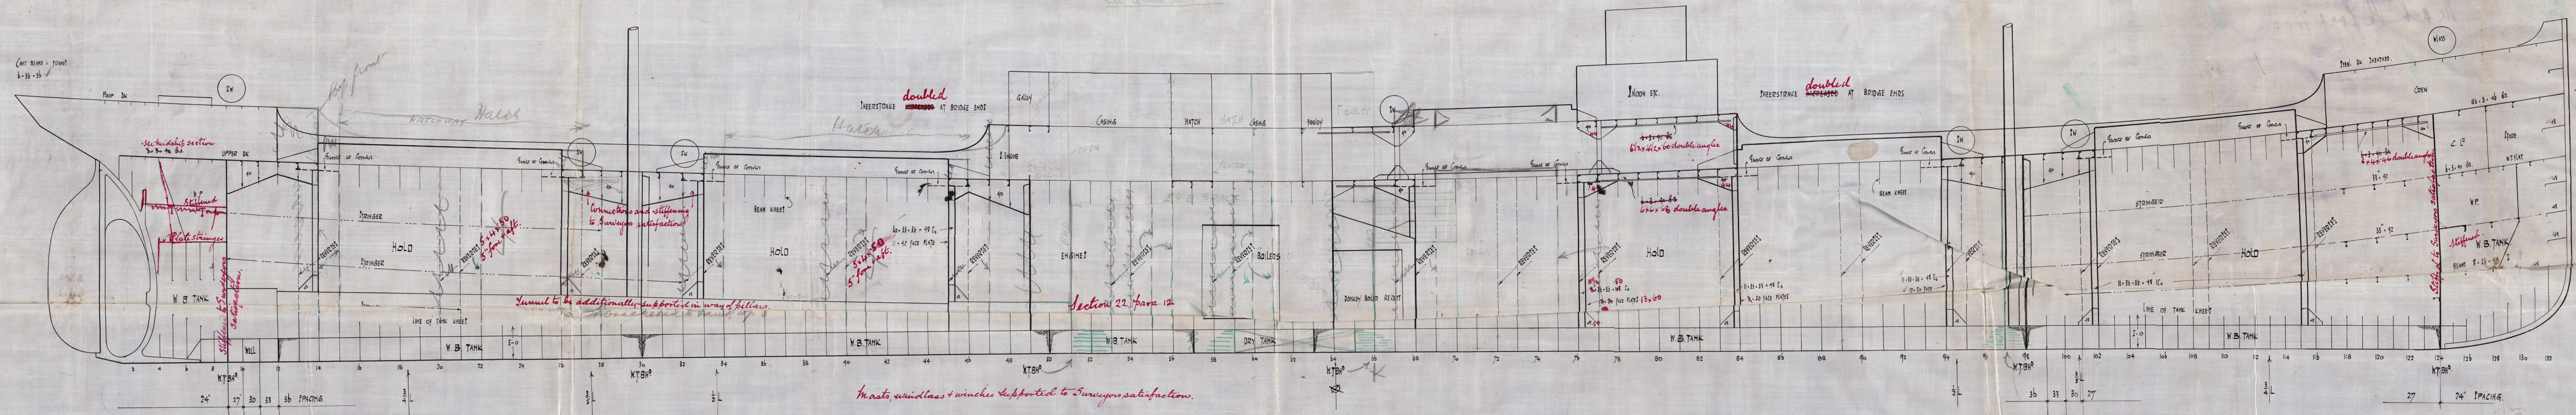

EXPLODED DECKS TO BE INCREASED 10% FOR IRON TEE SPECIFICATION

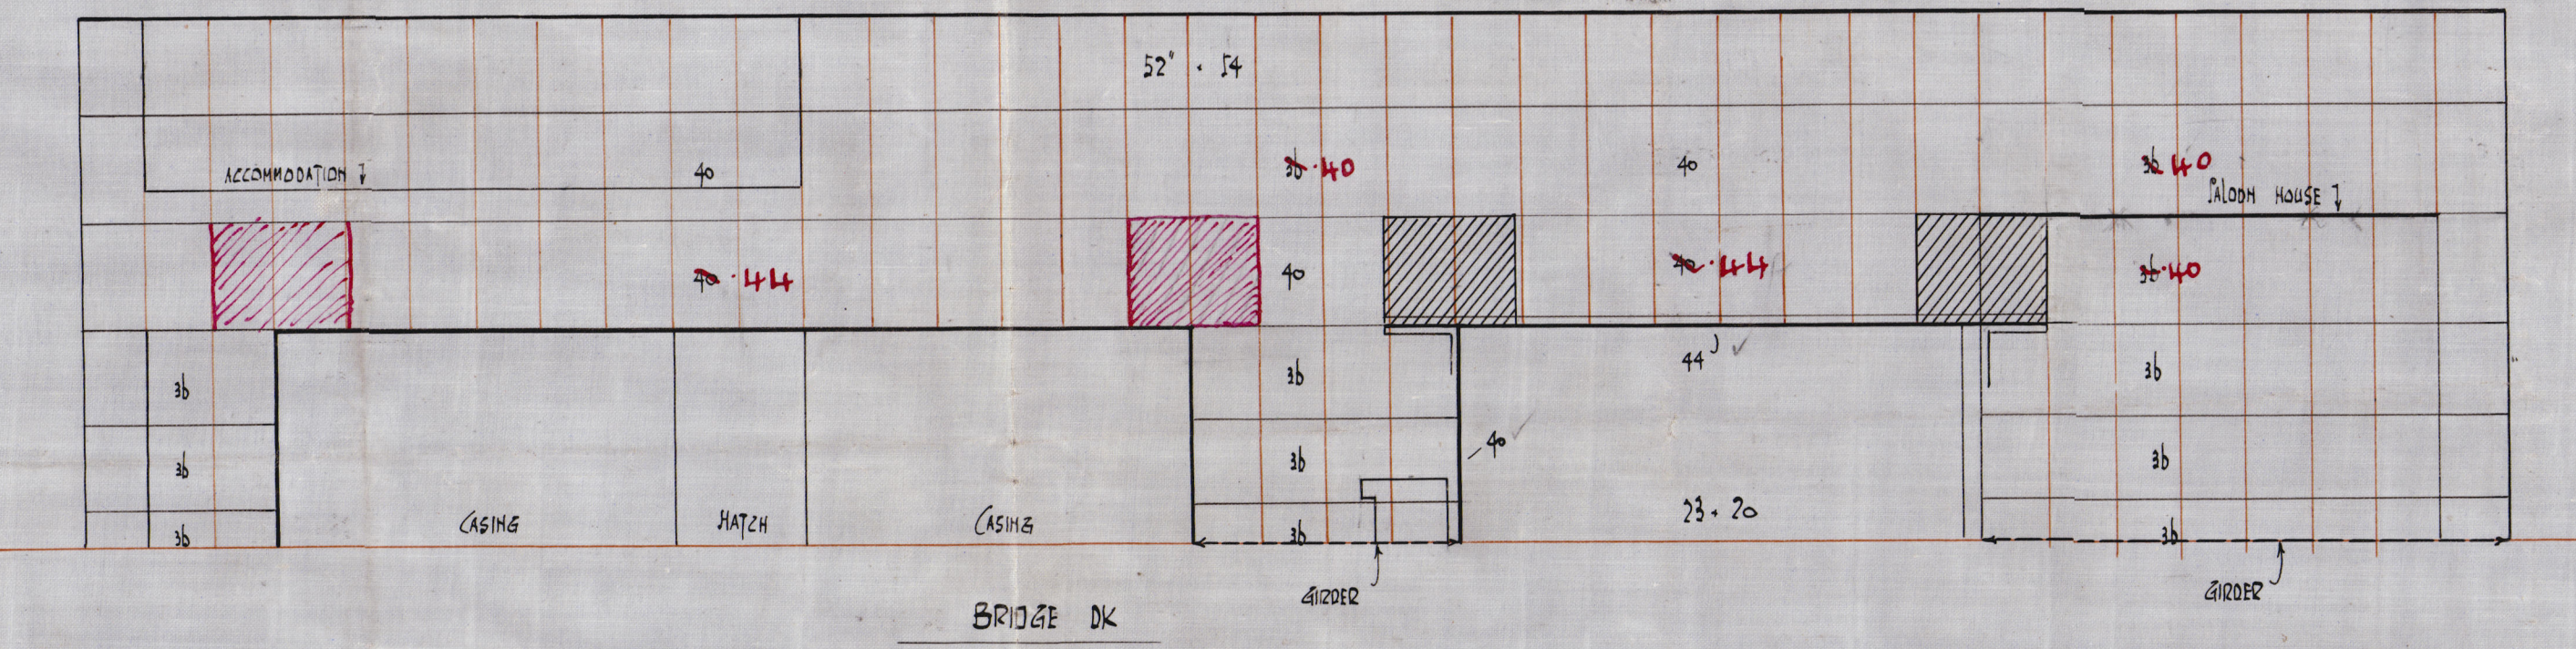

No 571 S S
PROFILE + DECK PLANS
305 x 50-10 x 28-4 1/2
TO CLASS 100 A LLOYDS
1/8" = 1 FT

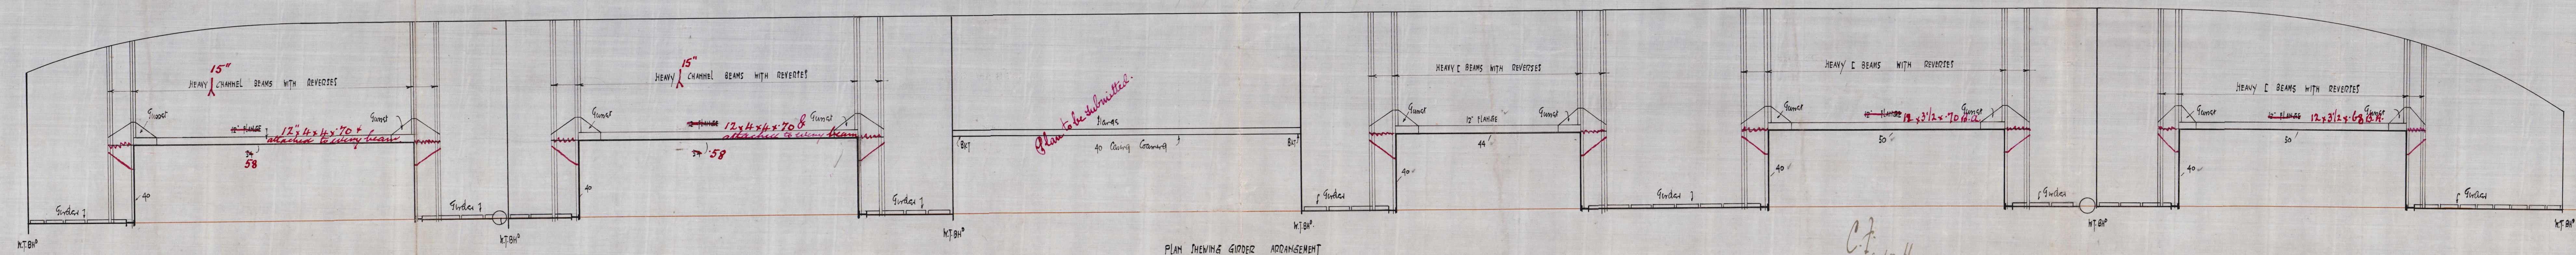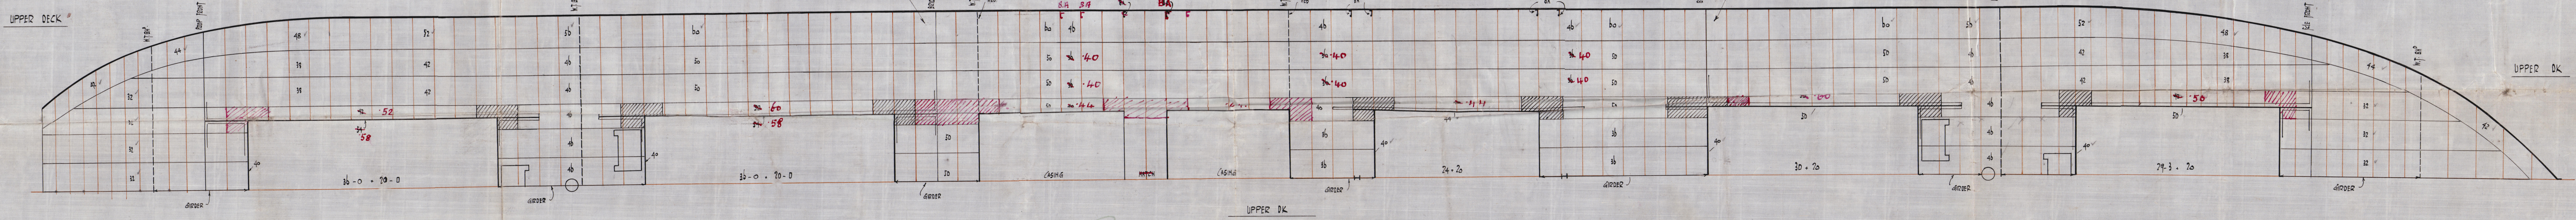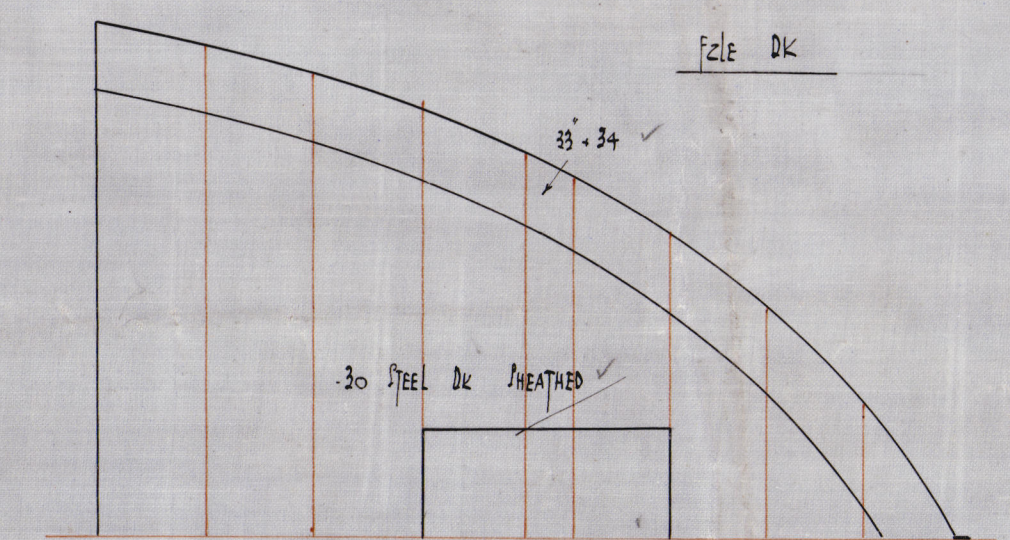

Sir Raylton Dixon & Co
No. 571

Profile & Deck Plans.

"Warley Pickering"

Mar. Report 7000



© 2020

Lloyd's Register
Foundation

W. 722-0108