

BREADTH

DEPTH

50.84 ✓

28.37 ✓

79.21 ✓

364.71 ✓

28890 ✓


L/D

12.86 ✓

10.03 ✓

26.10.11
16.11.11
23.11.11
18.12.11
11.1.12
31.5.12

RULE		EQUIPMENT	
NUMERAL	79 21 + 364 71		288 90
POOP	26 32 2		10 60
BRIDGE	41 40 + 8 + 3 3		10 32
101	108 3		10 32
	36 + 39 36 33		8 76
HOUSES	49 5		20 4
	72		30 13
2 BOXED	ANCHORT	56 4	CNTS EACH
1		47 3	MOCKET
1	TROEM	15	BY MOCK
1	KEEDGE	6 6	
270	FATHOM	2 6	STUD CHAIN
90		4 6	STEEL WIRE
170		4	
4 90		7	HAMTERT
			NAPPY

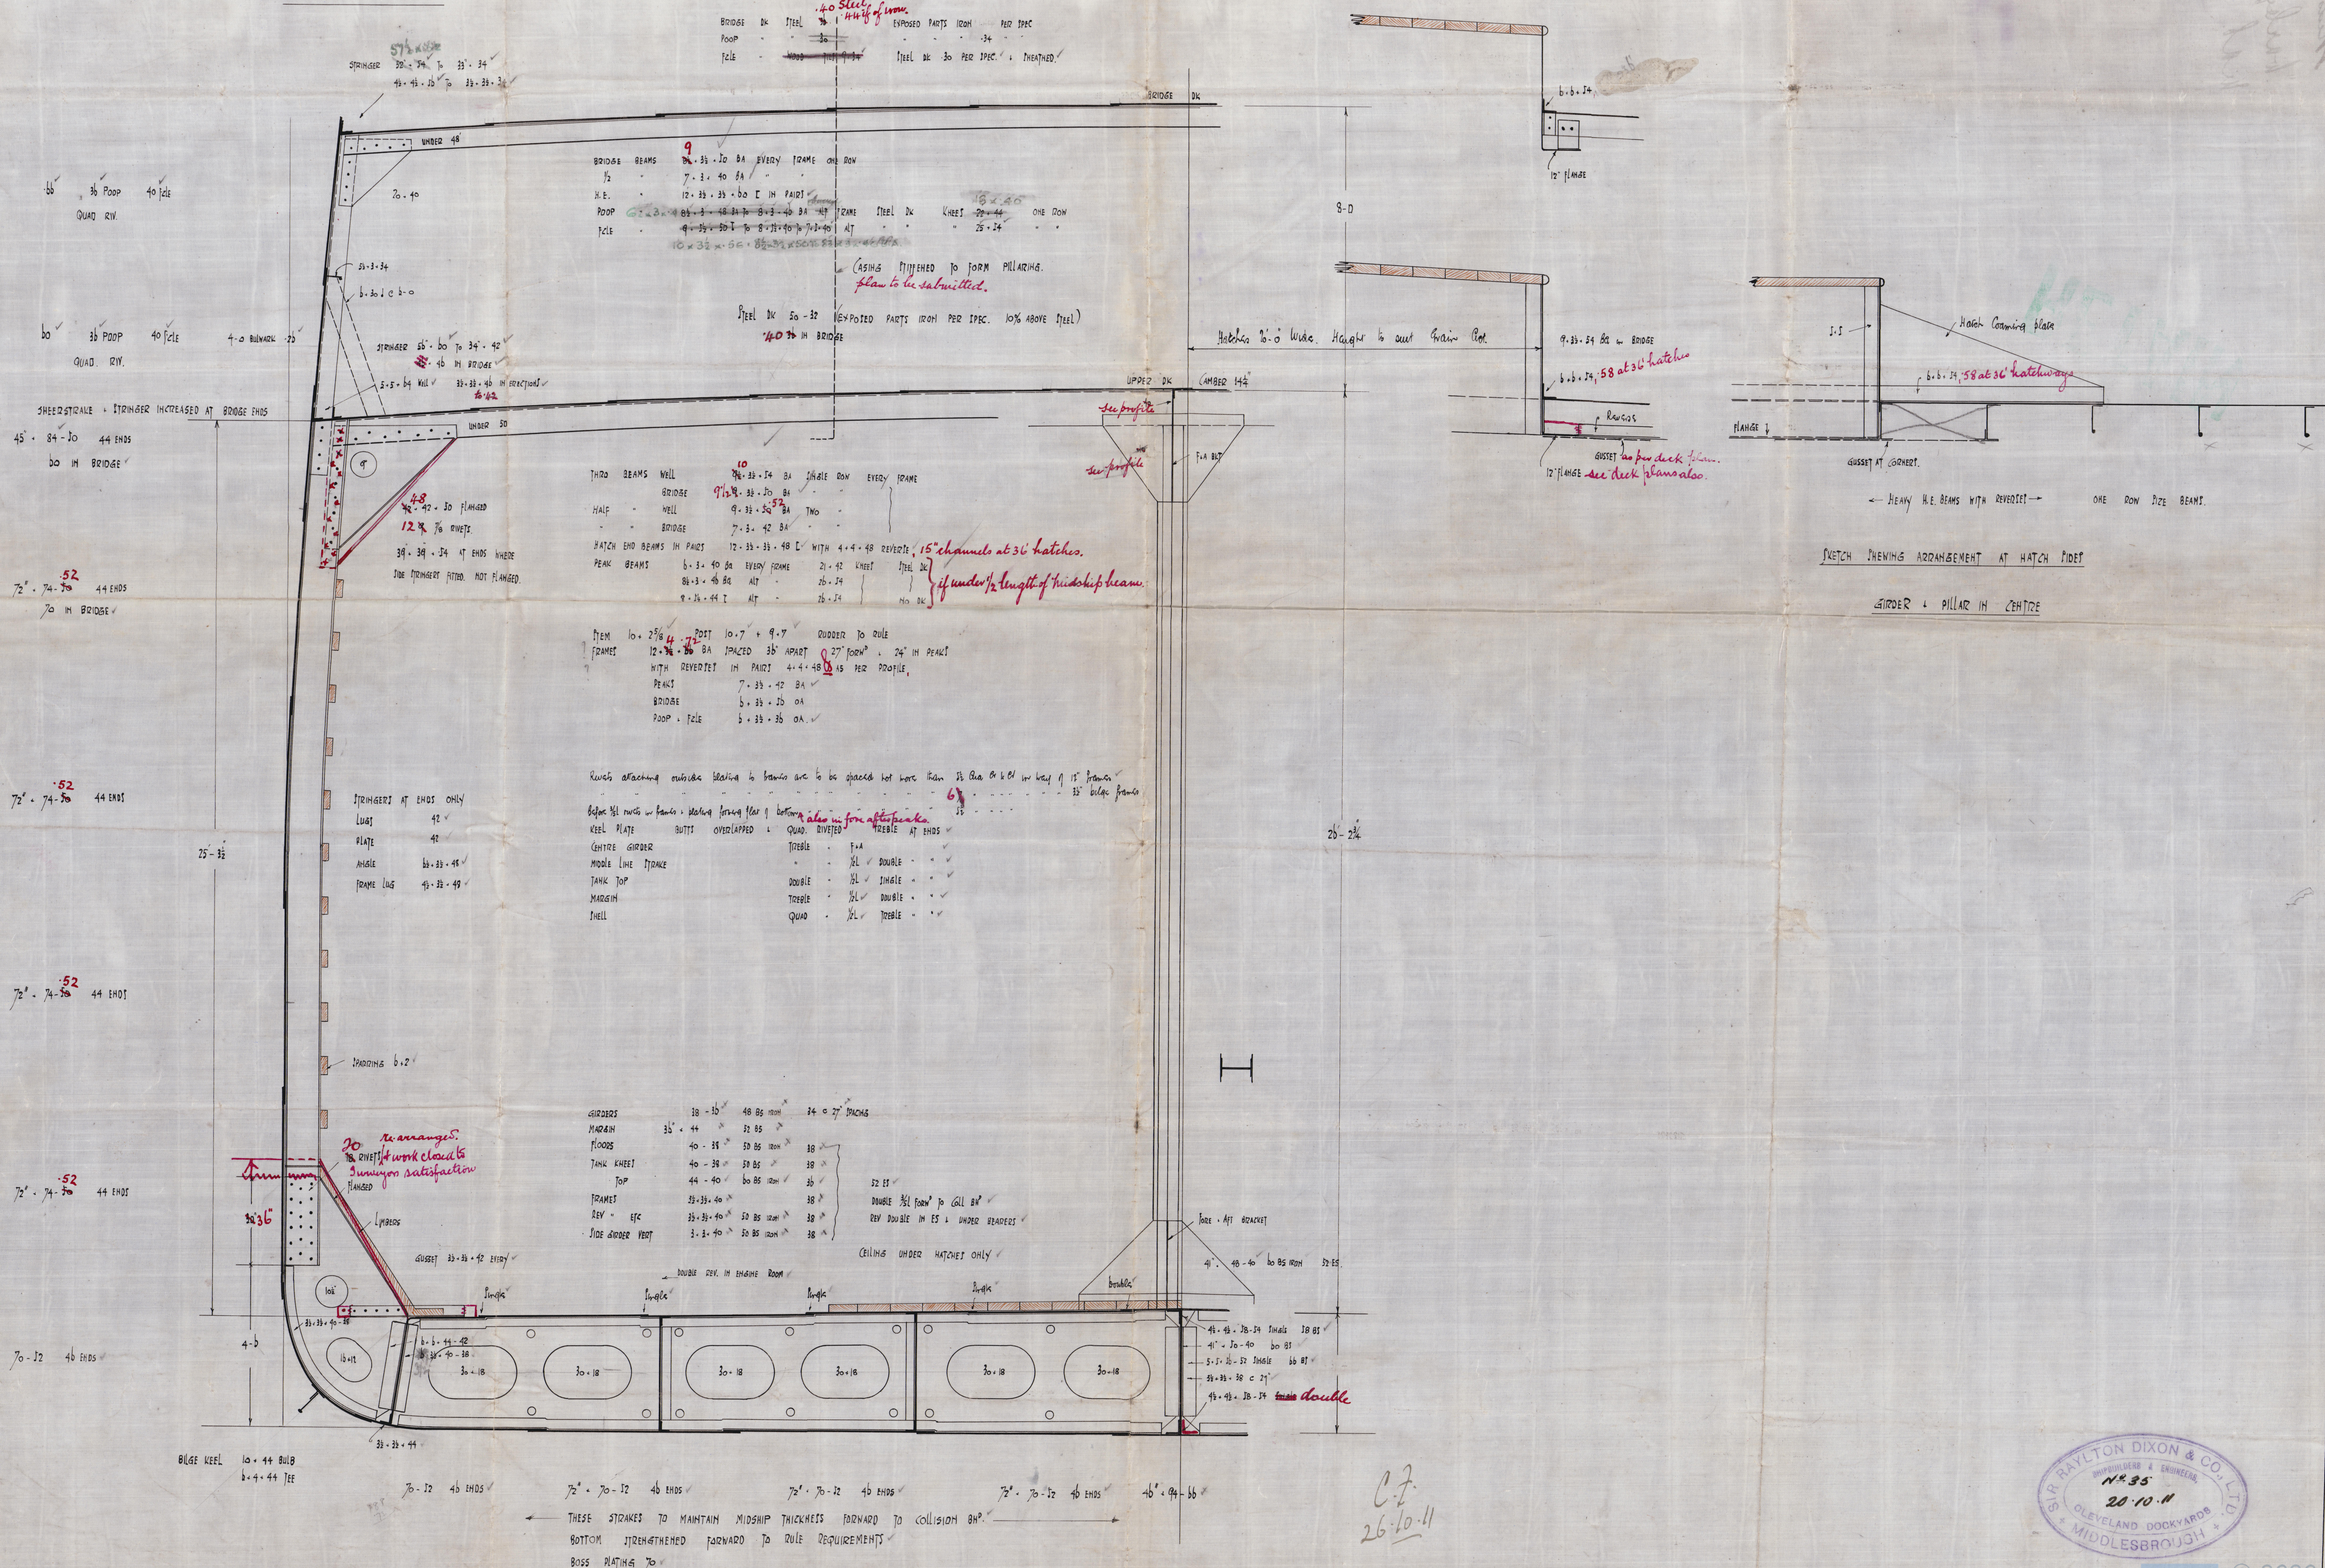

Sir Raylton Dixon & Co.
S.S. No. 571

Midship Section:
"Barby Pickering"
Mab. Report 7500

RECEIVED

RECEIVED

RECEIVED
11 DEC 1916



© 2020

Lloyd's Register
Foundation

W 722-8-1009