

MIDSHIP SECTION

STEEL SCREW TRAWLER.

Nº 392

16.10.06

DIMENSIONS. 125'-0" x 22'-0" x 12'-6" DEPTH MOULDED.

SCALE 1/2" = ONE FOOT.

TO CLASS 100.A.1. AT LLOYDS. FOR FISHING PURPOSES.

ENGINE & BOILER CASING AS PREVIOUSLY APPROVED

DECK PLATED IN WAY OF E & B CASING.

BULB STAYS 6" x 5/16"

TIE PLATE 8" x 5/16"

WOOD DECK 5" x 3" P.P.

STRINGER 50" x 5/16"

LLOYDS NUMBERS


1/2 BREADTH	10.95
1/2 GIRTH	19.80
DEPTH	12.95
	43.70 1 ST N°
	123.75 RULE LENGTH
	54078750 2 ND N°

PROPORTIONS


DEPTHS TO LENGTH	9.5
BREADTHS "	5.6

EQUIPMENT.

1 ST BOWER	5 1/2 CWTs EX STOCK
2 ND "	5 "
3 RD "	2 3/4 "
105 FATHOMS	1 1/6 " CABLE
60 "	6 " HAWER
60 "	4 1/2 " WARP

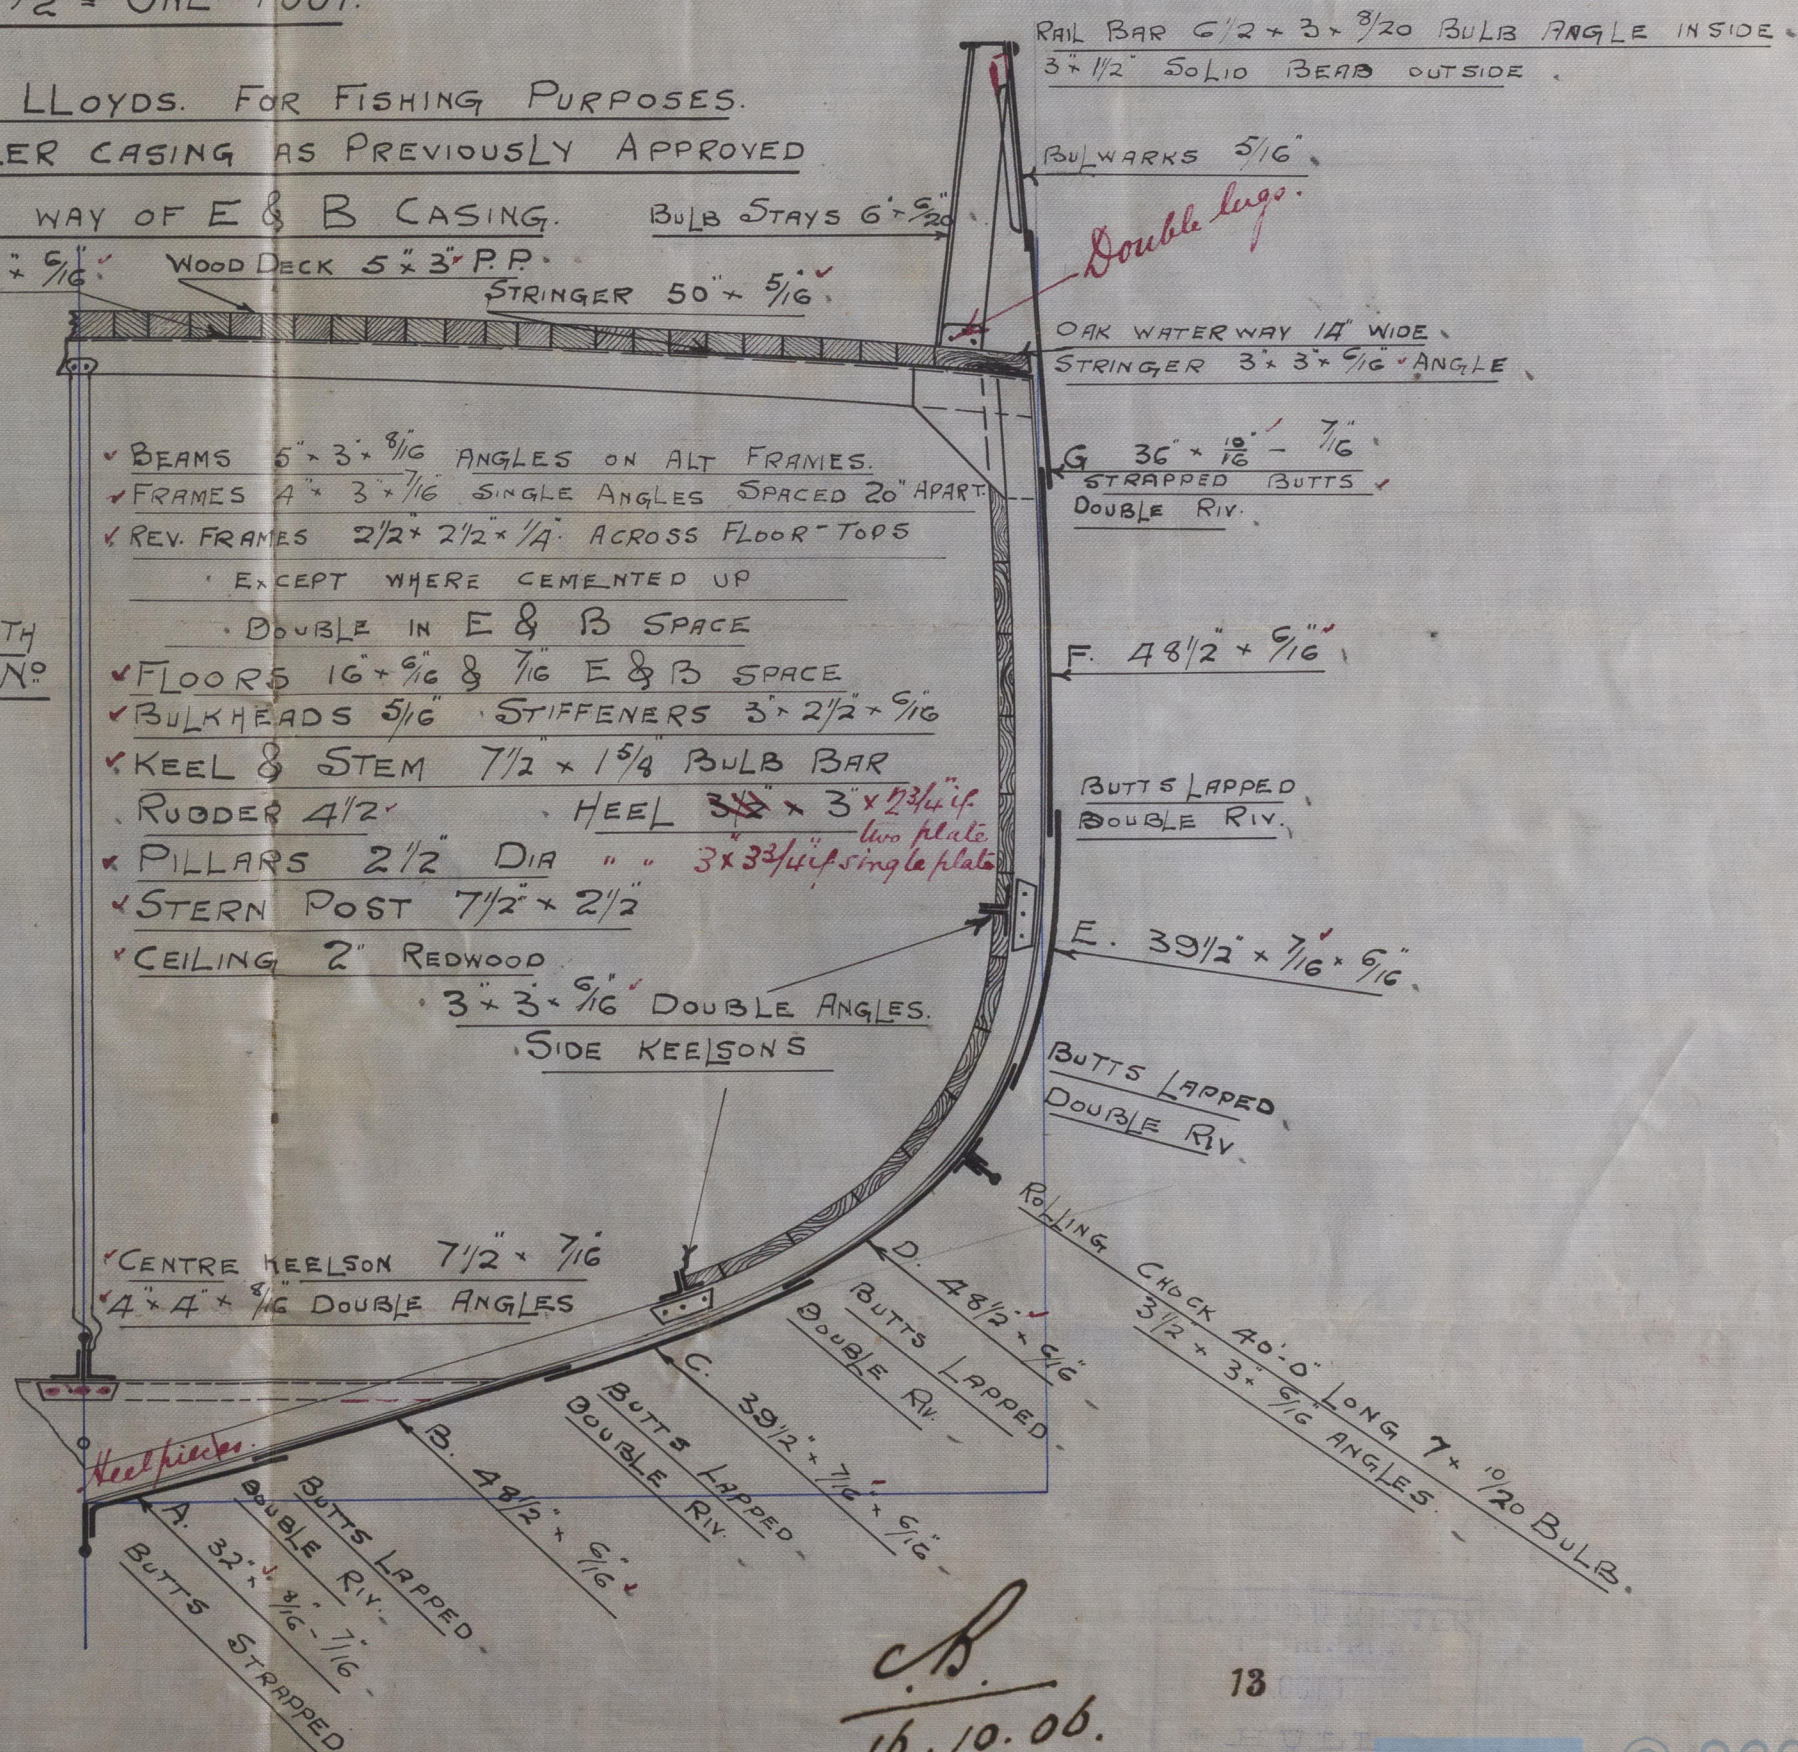

C.B.
16.10.06.

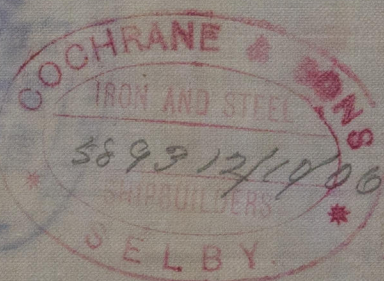

13



© 2020
Lloyd's Register
F007224119

Midship Section

By Messrs
Cochrane & Sons

No 392

11
s/s Washington

Hull Report No:



RETAIN



© 2020

Lloyd's Register
Foundation

W 722-0119

MIDSHIP

STEEL SCREW

No 39







15 22

43.10.11.16

15.80

2.0

2.0

