





16.10.06

PROFILE & DECK PLAN.

S. S. N° 392

SCALE 1/4" = ONE FOOT.

DIMS LEN 120' 8" BEAM 22' 0" DEPTH OF HOLD

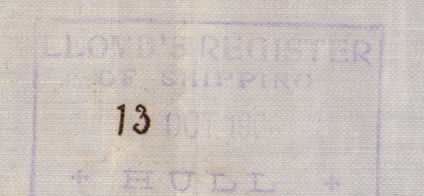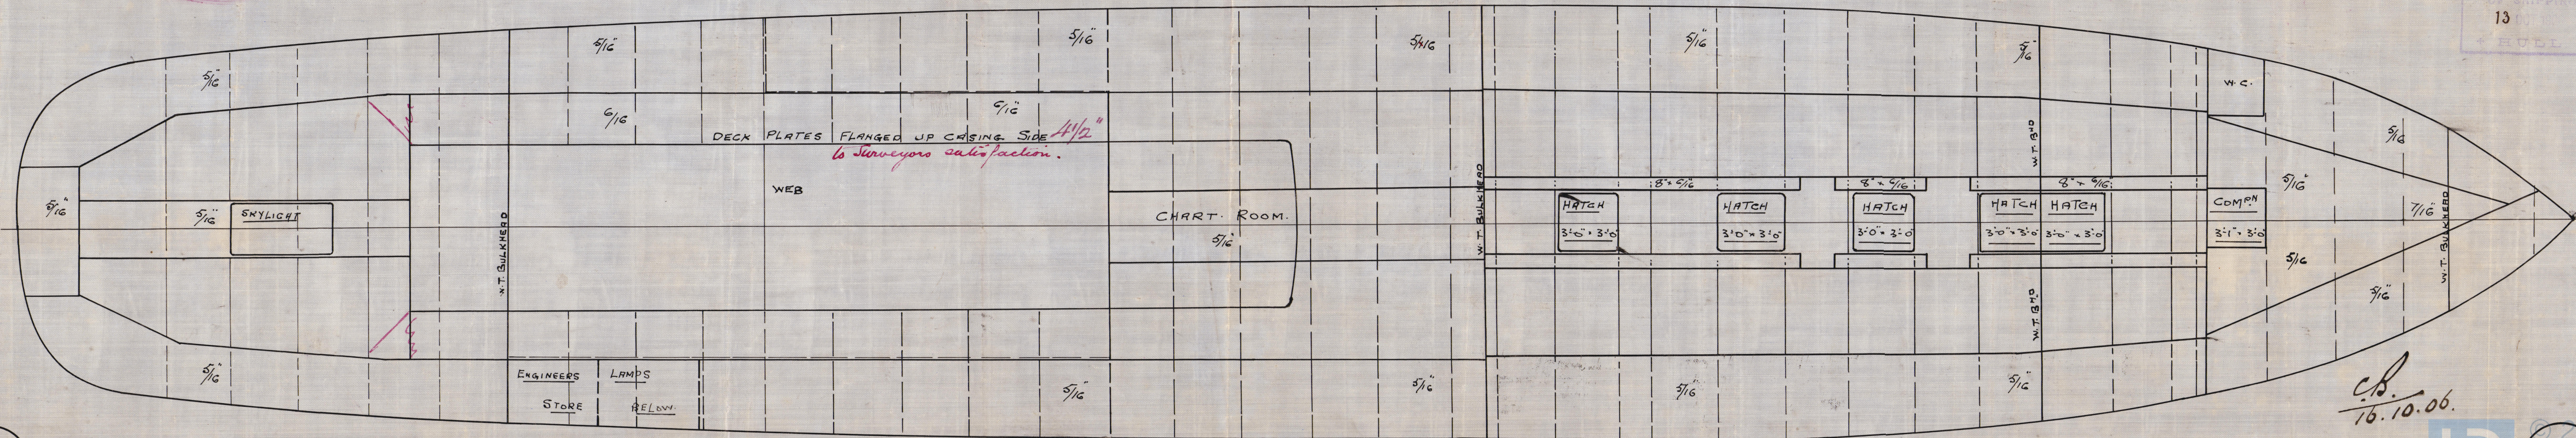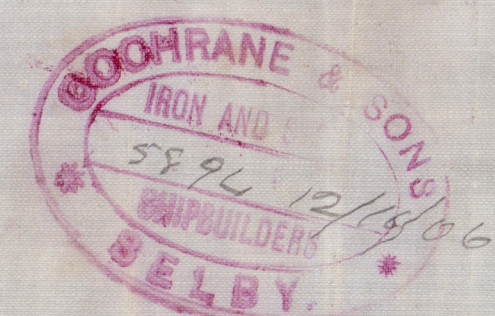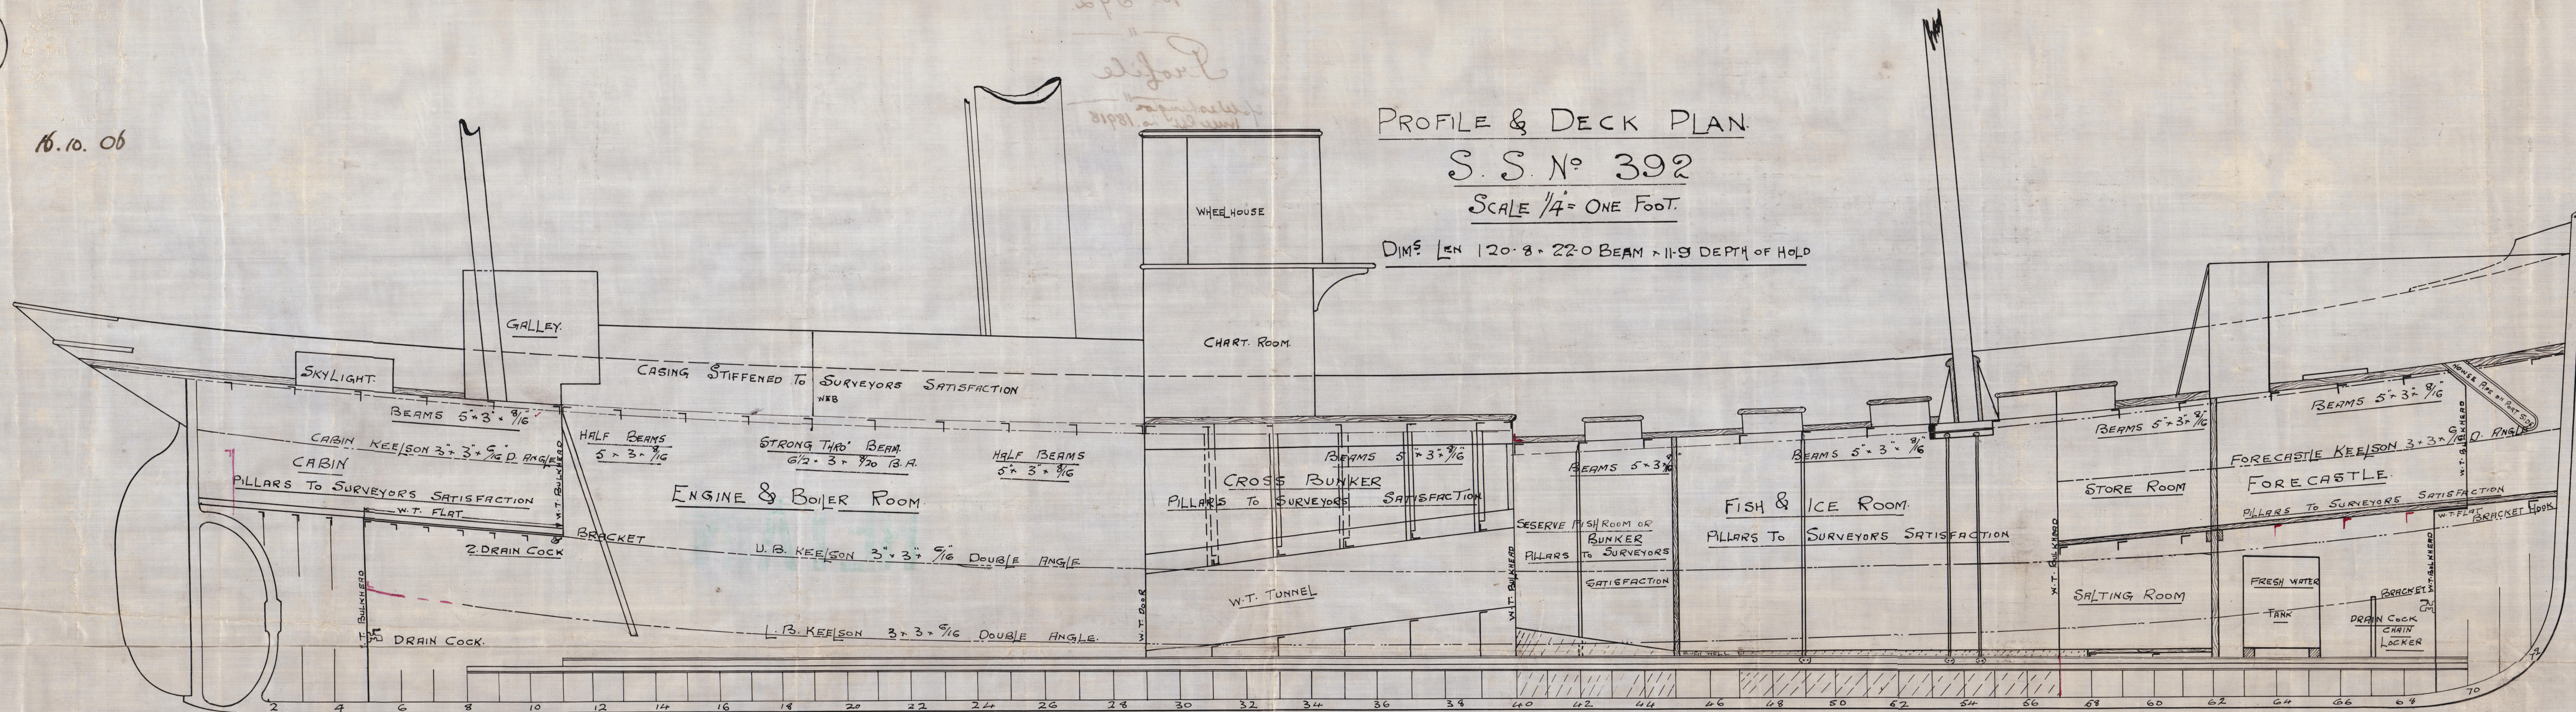


C.B.
16.10.06.

Messrs
Cochrane & Sons

no 392.

Profile

of Washington
Hull Rpt No. 18918

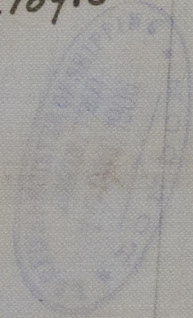

W722-0120



© 2020

Lloyd's Register
Foundation