




MOULDED DIMENSIONS $240'0'' \times 32'10'' \times 16'6''$

SCALE $\frac{1}{8}$ INCH = 1 FOOT.



13. 7. 05
16. 8. 05
22. 8. 05

[Handwritten signature]

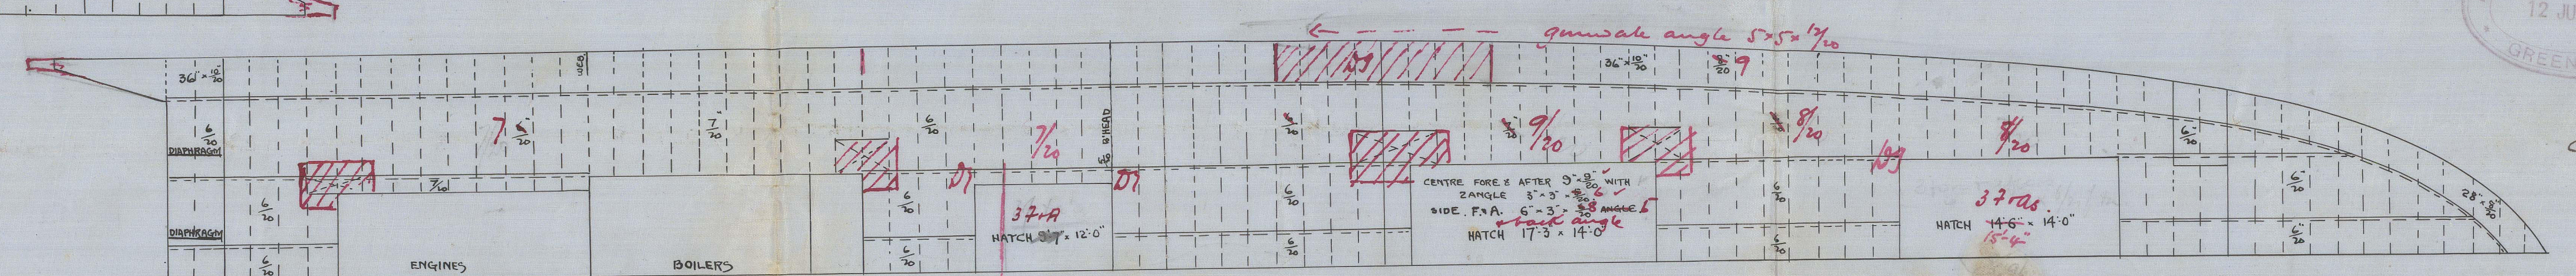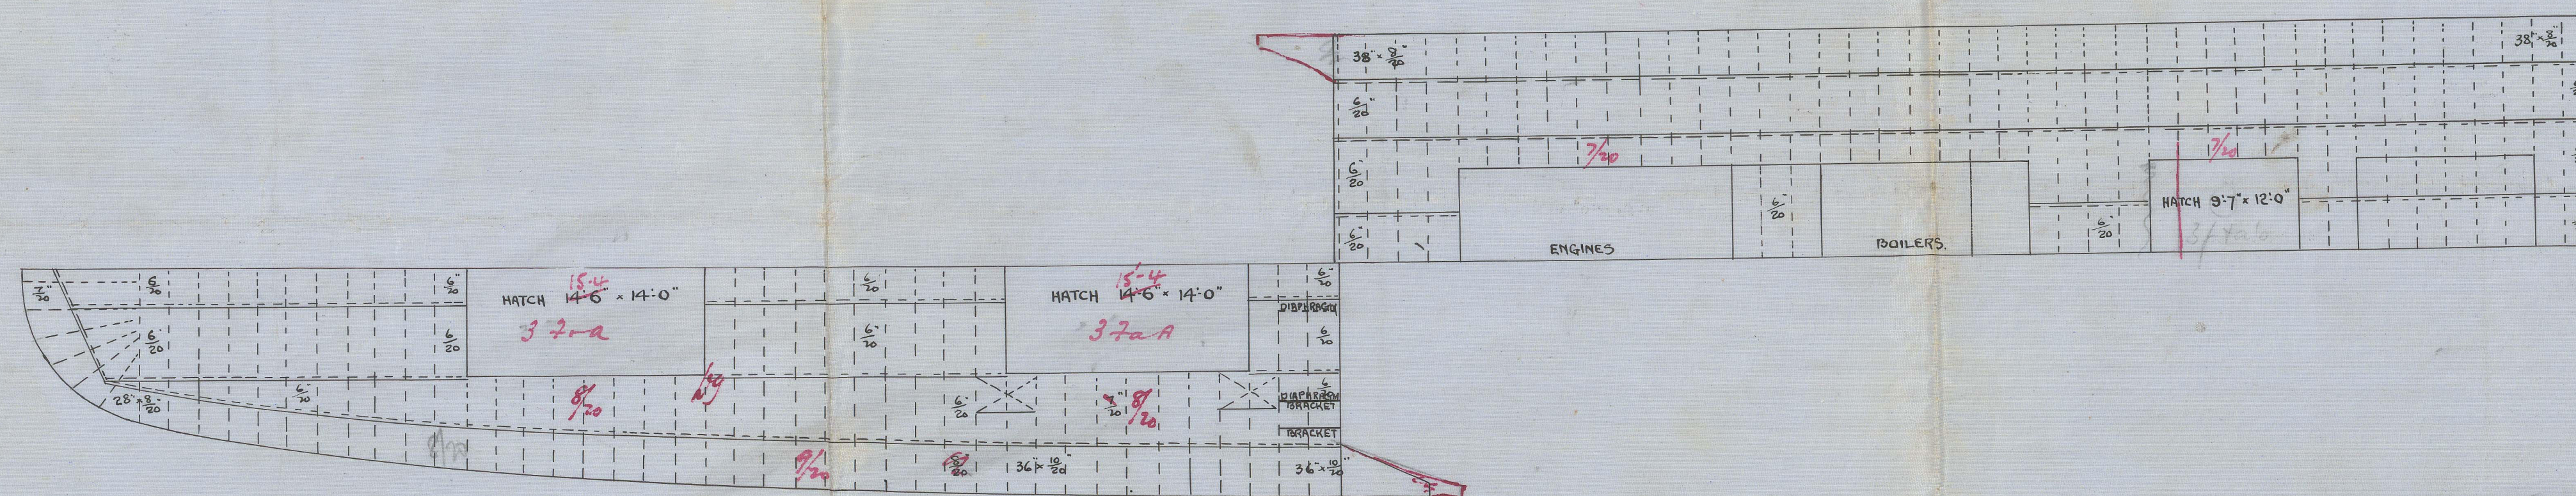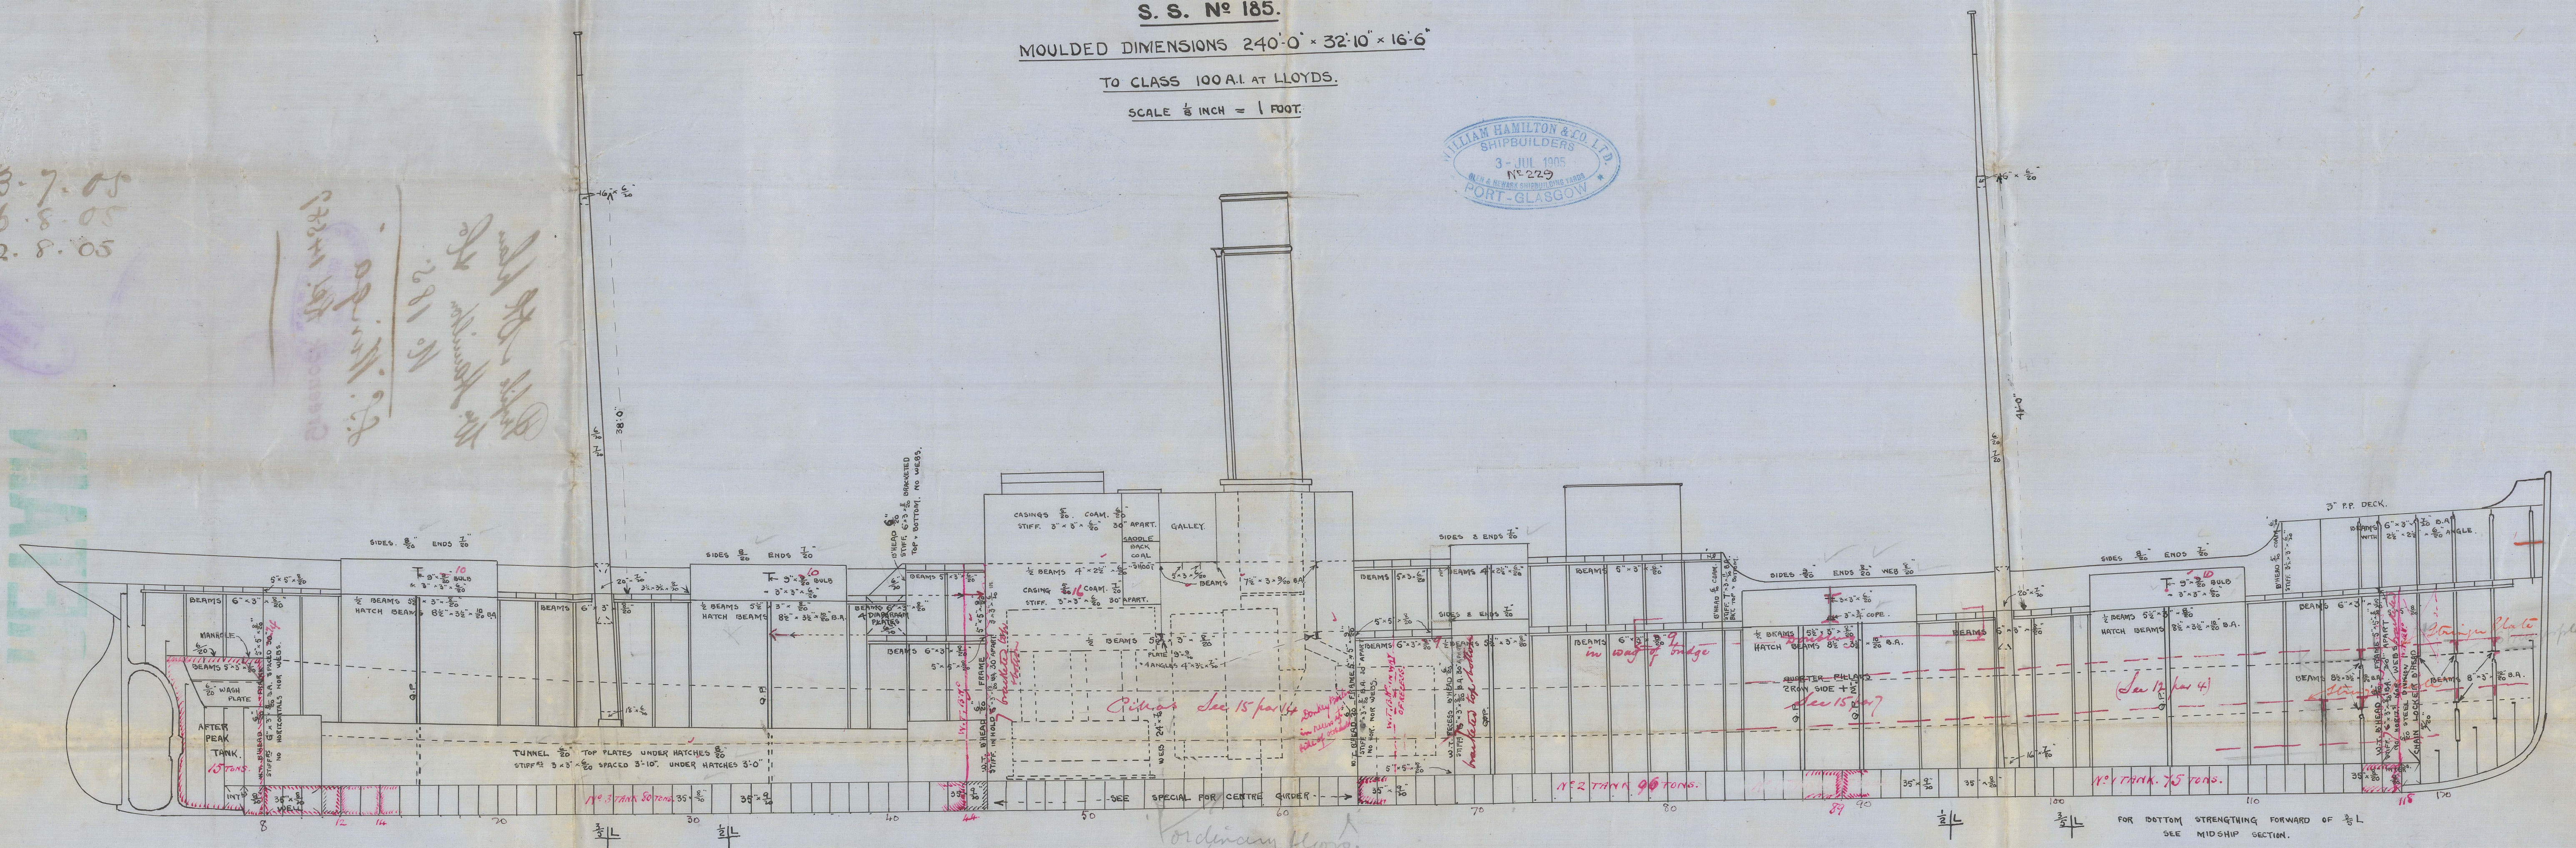

13/7/05

~~Price~~ #

Profile & DR plan
W. Hamilton & Co
No 185.

S.S. Kinga
Greenock R.R. 14587

RETAIN



© 2021

Lloyd's Register
W725-0052
Foundation