

Winlaton
Ship Forquips
Sta. Exp. 25771



© 2020

Lloyd's Register
Foundation

W726-0064

Lloyd's Register of British & Foreign Shipping.

(Report on Vessel No. _____ Port _____)

No. _____ SHIP FORGINGS ~~OR CASTINGS~~.

I have to report that the undermentioned ~~Iron or Steel Forgings or Castings~~, manufactured by Sunderland Forge Co. Ltd. of Sunderland for the Vessel No. 241, being built by Robert Thompson & Sons of Sunderland have been inspected by me as set forth below and found to be, so far as can be seen, Sound

Mark on Forgings.

Lloyd's

No 4531


MR

Matt Robertson

Built - Sunderland, 5.12.11

	STERN FRAME.	RUDDER FRAME.	STEM.
Material*	<u>Scrap Steel</u>	<u>Scrap Steel</u>	<u>Scrap Steel</u>
How made	<u>Forged</u>	<u>Forged</u>	<u>Forged</u>
Dimensions	<u>10' x 6 1/2' x 9' x 6 1/2"</u>	<u>9' to 6 3/4' dia</u>	<u>10 1/2' x 2 1/2' x 11' x 2 3/4"</u>
Progress on Inspection	<u>Forged and</u>	<u>Forged and</u>	<u>Forged and</u>
Date when Inspected	<u>Smithed</u>	<u>Finished</u>	<u>Machined</u>
	<u>1.9.11 to 29.8.11</u>	<u>8.9.11 to 30.11.11</u>	<u>12.9.11 to 26.9.11</u>

SKETCHES OF FRAMES SHOWING POSITION AND DESCRIPTION OF WELDS OF FORGINGS, OR PARTICULARS OF TESTS APPLIED TO CASTINGS.

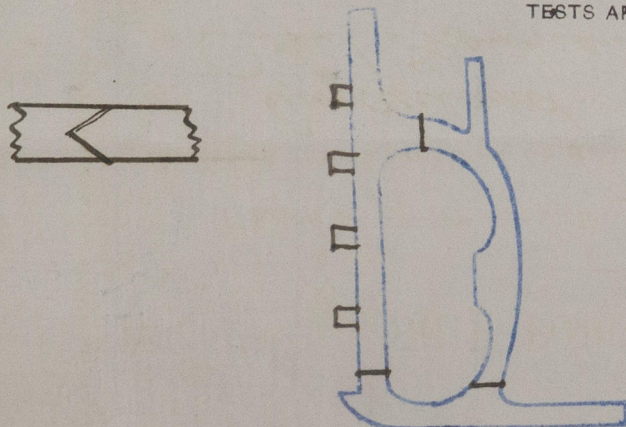

Fee (if any chargeable) £

To be paid at

* If of Iron, state whether scrap or puddled Iron.