


26: 4: 04

MARINE BOILER N^{OS} 578-9 & 581



SCALE 1 INCH = 1 FOOT

TENSILE STRENGTH OF SHELL PLATES AND BUTT STRAPS TO BE FROM 28 TO 32 TONS

3 OFF (1 FOR EACH NUMBER)

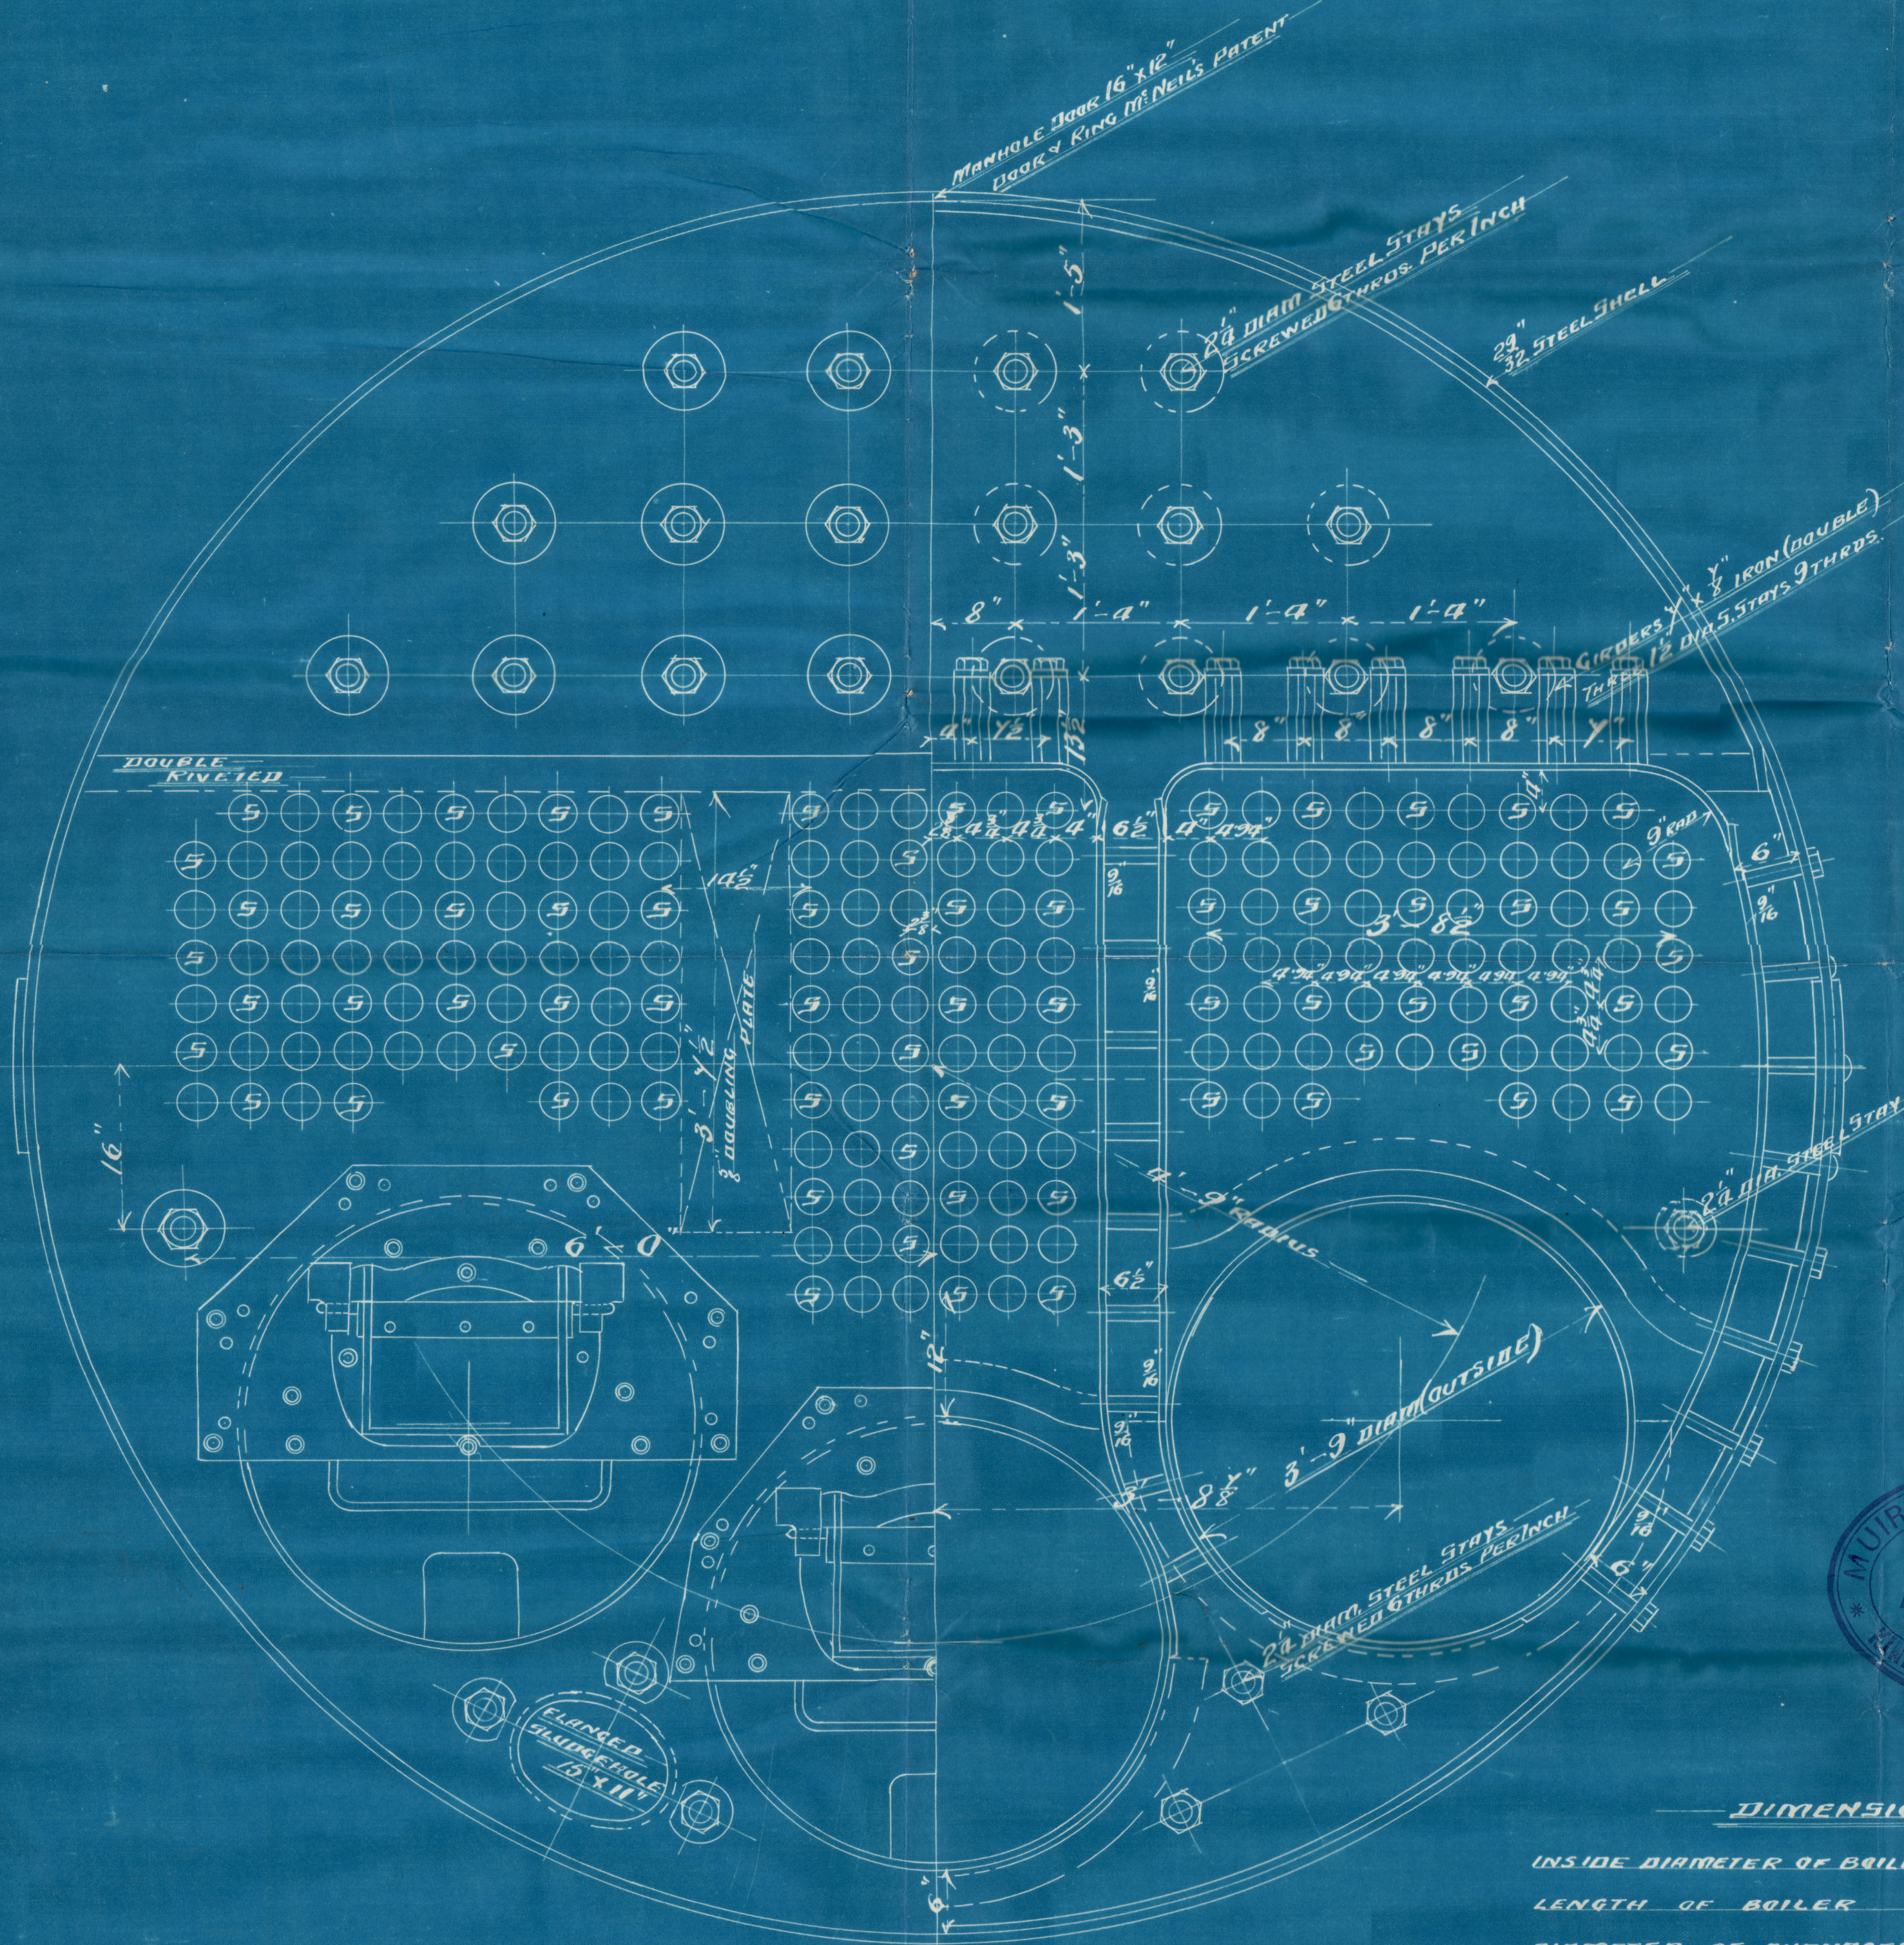

DIMENSIONS	
INSIDE DIAMETER OF BOILER	14'-3"
LENGTH OF BOILER	10'-0"
DIAMETER OF FURNACE	3'-9"
NUMBER OF PLAIN TUBES	127
NUMBER OF STAY TUBES	71
TOTAL NUMBER OF TUBES	198
TOTAL HEATING SURFACE	1045 sq ft
TOTAL FIREGRATE AREA	622 sq ft
WORKING PRESSURE	120 LBS PER INCH

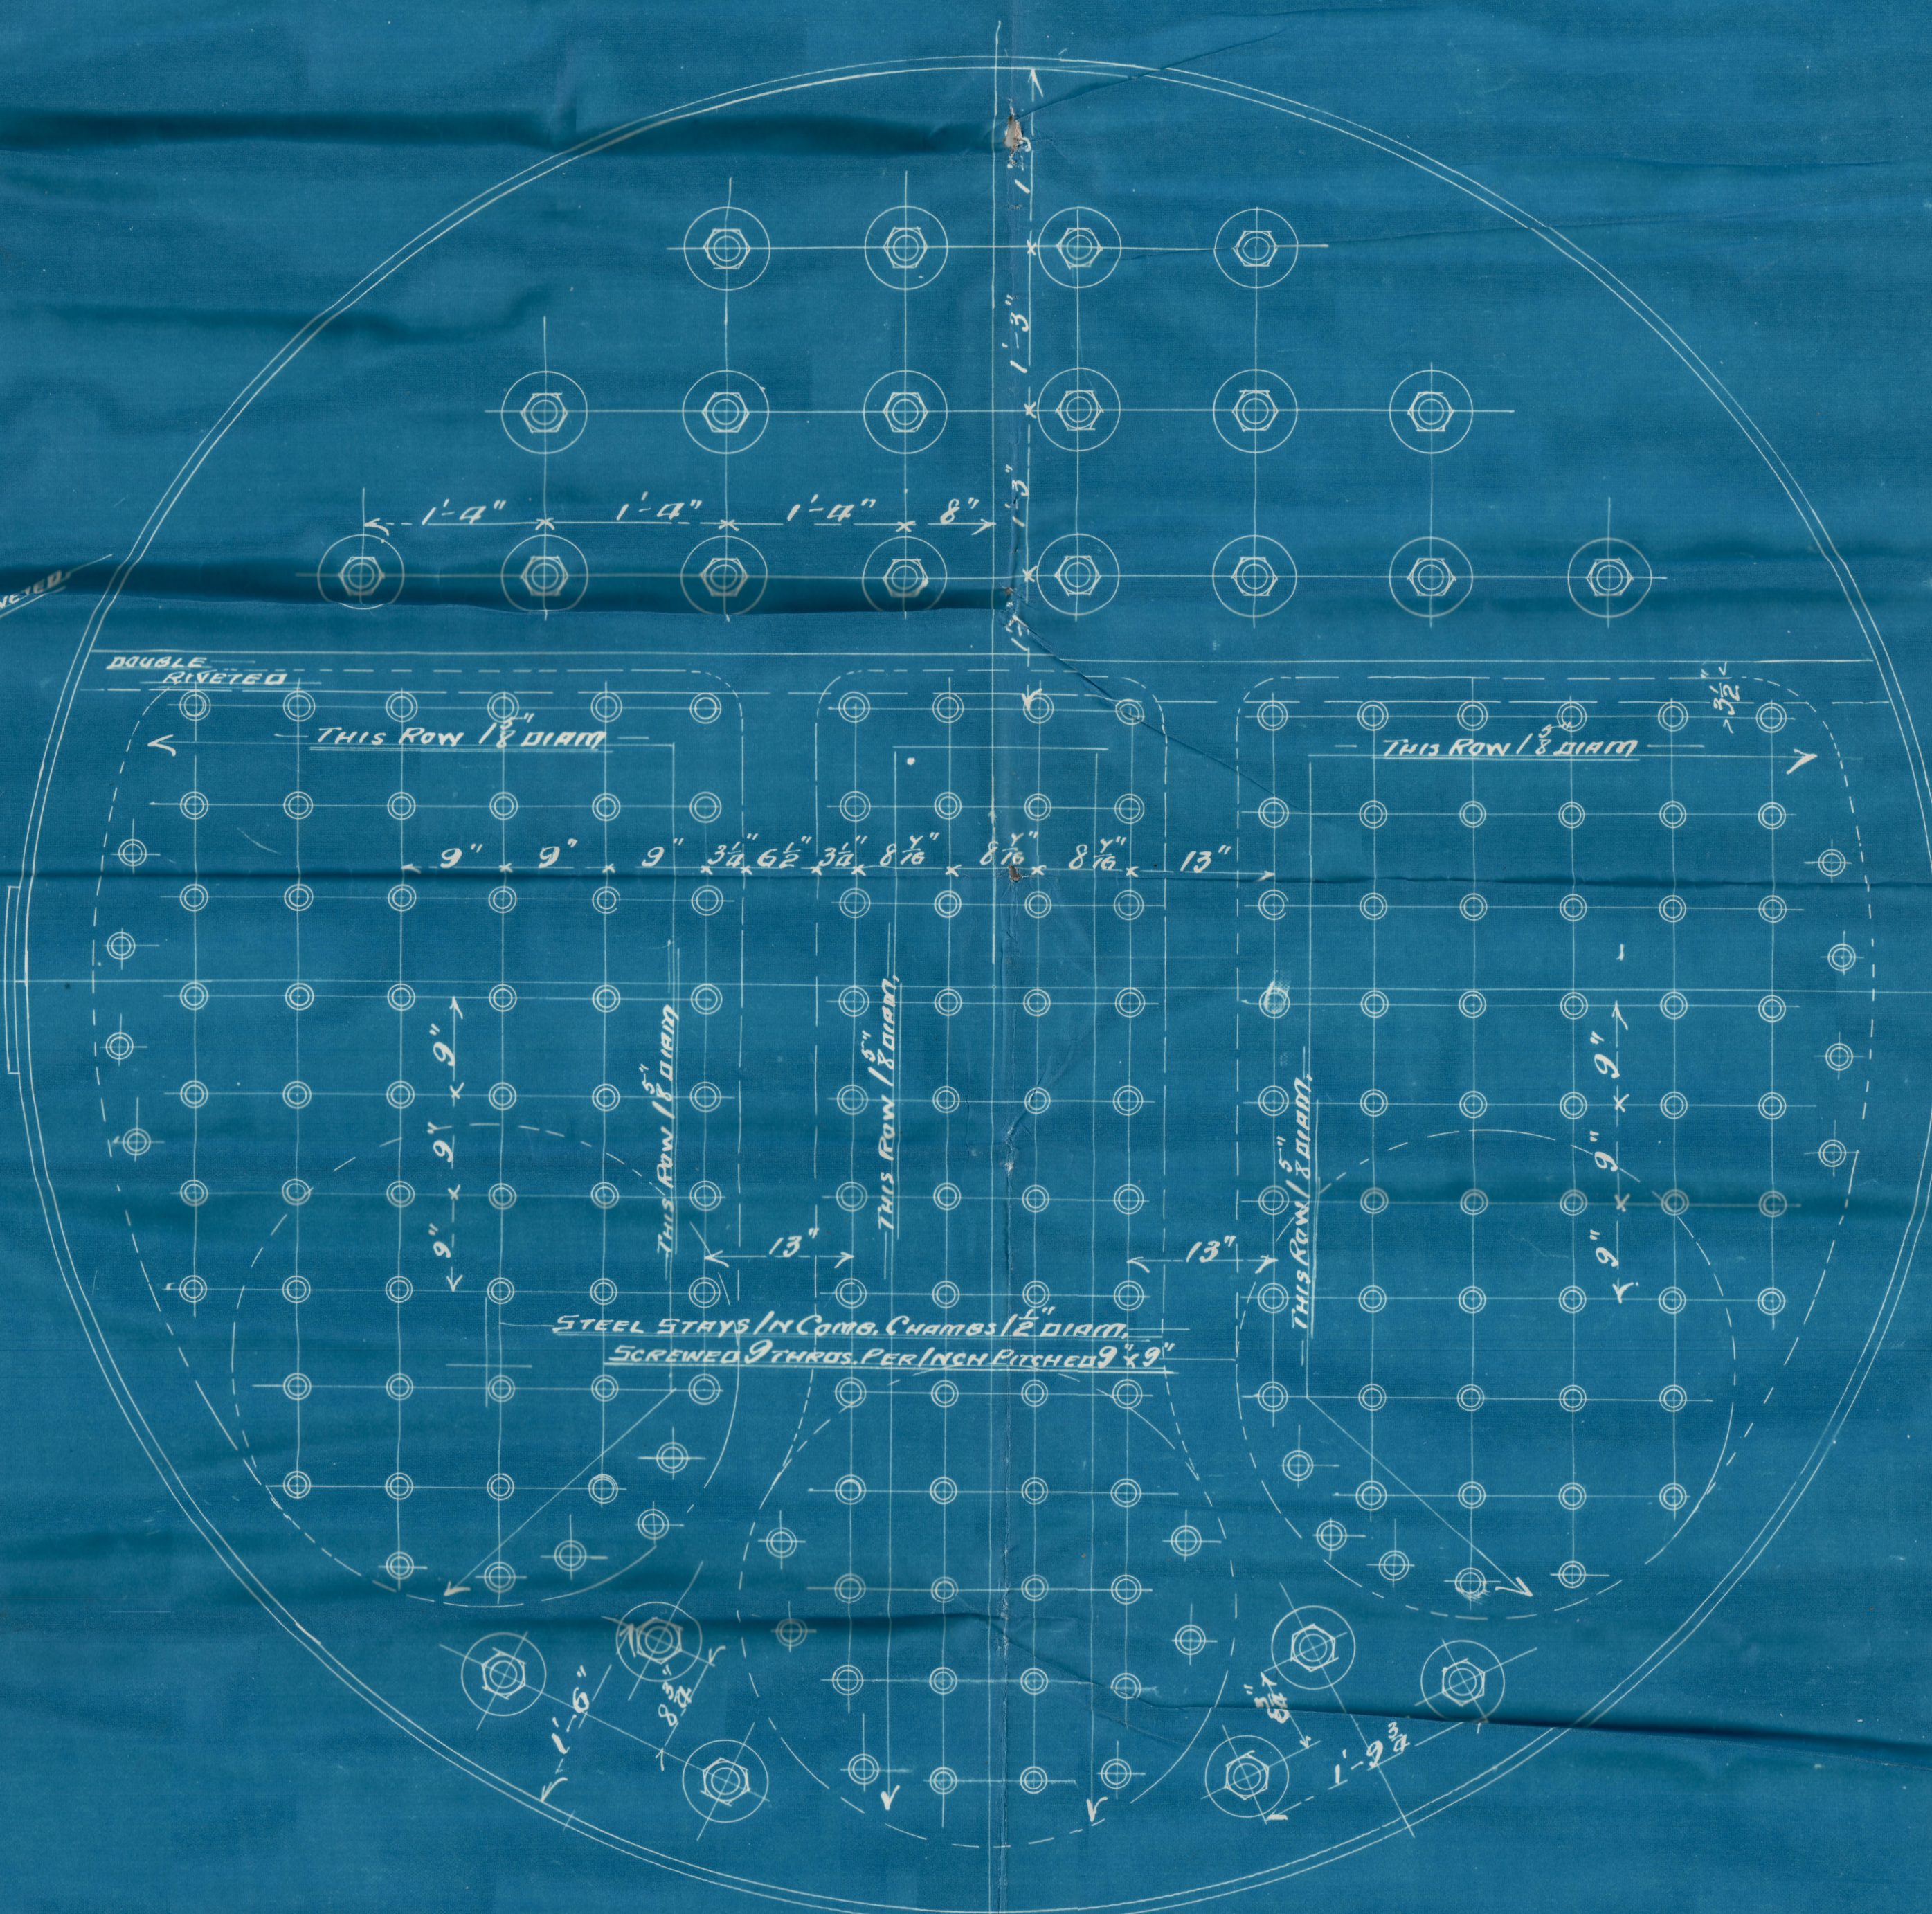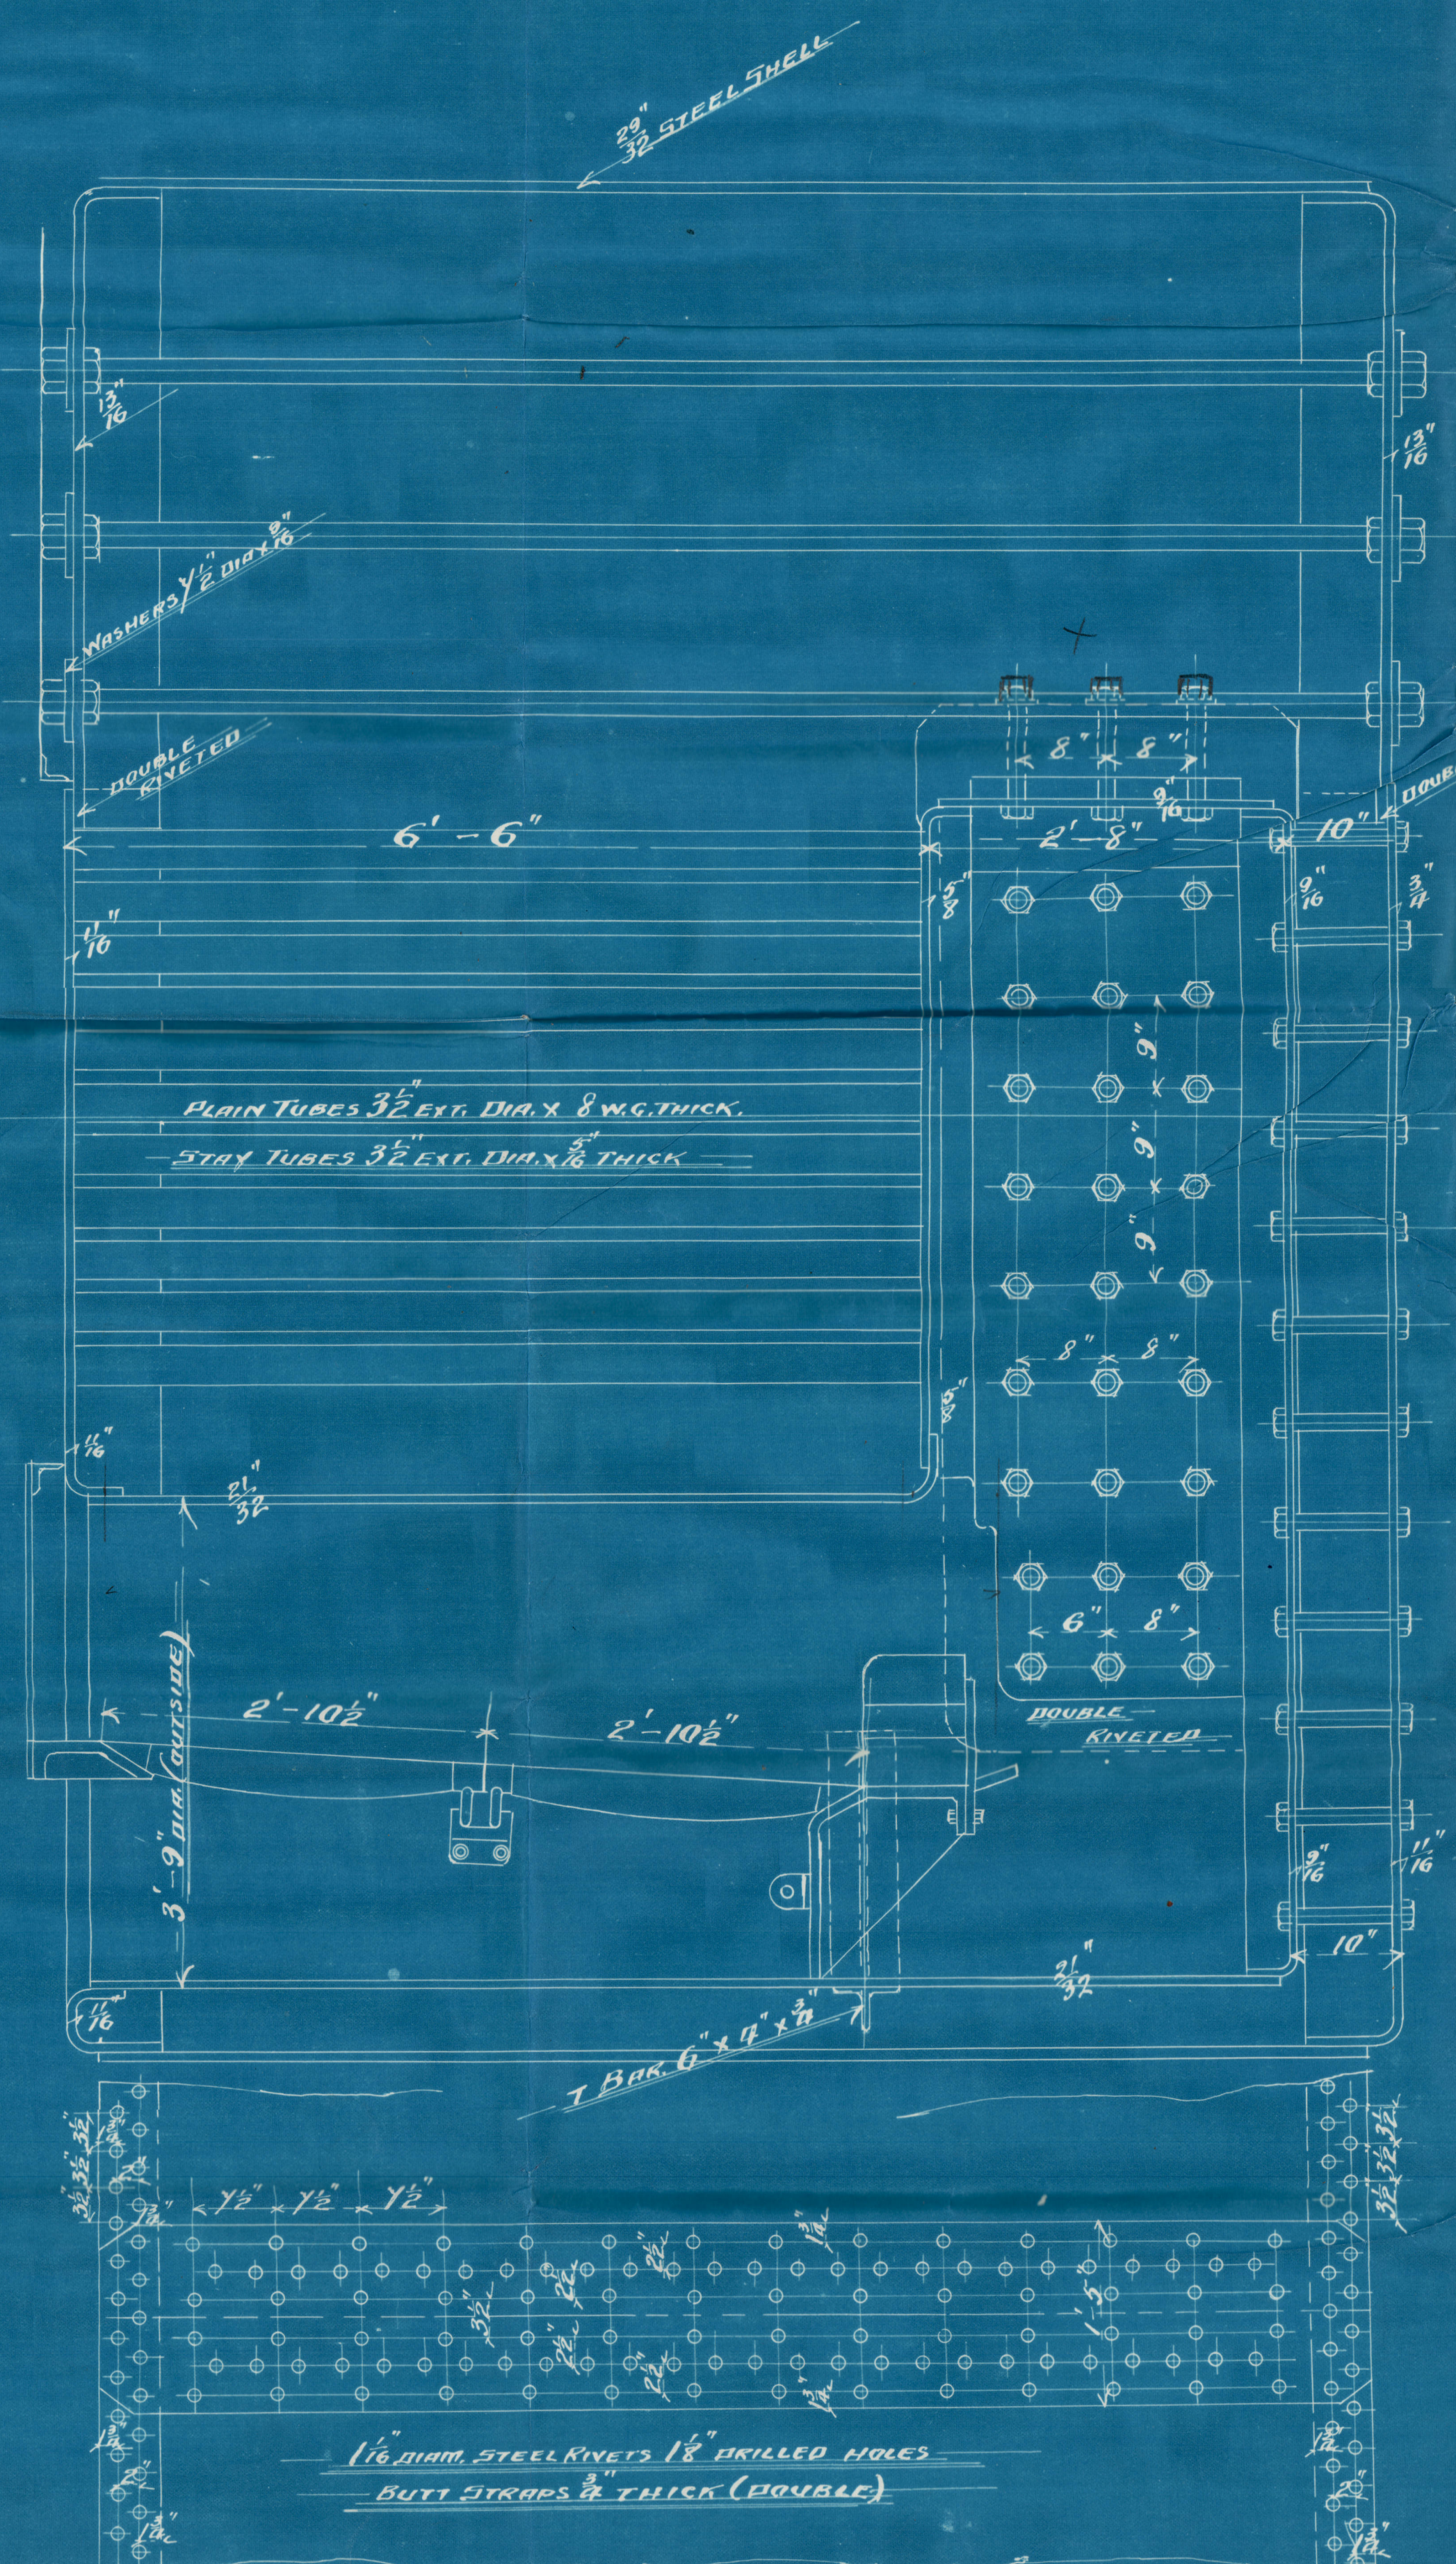

25.4.04




Muir & Houston
M-Boilers 578. r

" 579.

" 581.

W.P. 130 lbs.

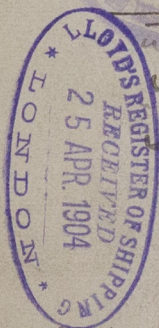

"The President"
"The Sultan"

"The President"

Glasgow rft No 22223.



"The Sultan"

Glasgow rft No 22313

Lloyd's Register
Foundation

W726-0173