

NUMERALS

BREADTH 24.00 ✓
DEPTH 11.83 ✓
35.83 TRANSVERSE NUMBER
LENGTH 145 ✓
17915 ✓
14332
3583 ✓
5195.35 LONGITUDINAL NUMBER

S.S. N^o 129
MIDSHIP SECTION
STEEL SCREW STEAMER

DIMS 145-0 BP x 24-0 x 11-10 MLD —

SCALE 1/2" = 1 FOOT

$$\frac{L}{D} = 12.25$$

EQUIPMENT N° = 5705.22

BREADTH = 24
DEPTH = 11.83
35.83
LENGTH = 145

5195-35

$$\underline{R.Q.D^k = 91.375 \times 4 = 365.50}$$
$$\underline{F_{GLE} D^K = 19.0 \times 7 \times .75 = 99.75}$$

B.D. House = $12.75 \times 7 \times 5$ 44.62

EQUIPMENT N°= 5705.22

EQUIPMENT N^o = 570522 Equip No
Ex B. Casings 43' x 6.5 x .5 = 139.75 58 44.97

2 BOWER ANCHORS 9 CWTs EA. STO

1 STREAM ANCHOR 3 C_{WTS} Ex


1	KEDGE ANCHOR	1 1/4 C WTS	Ex
---	--------------	-------------	----

165 FATHOMS 1" STUD LINK CABLE

45 FATHOMS 2 3/4" STEEL WIRE

75	FATHOMS	2 1/2	STEEL WIRE
----	---------	-------	------------

75	FATHOMS	2 1/2	STEEL WIRE
90	FATHOMS	5%	HAWSEER

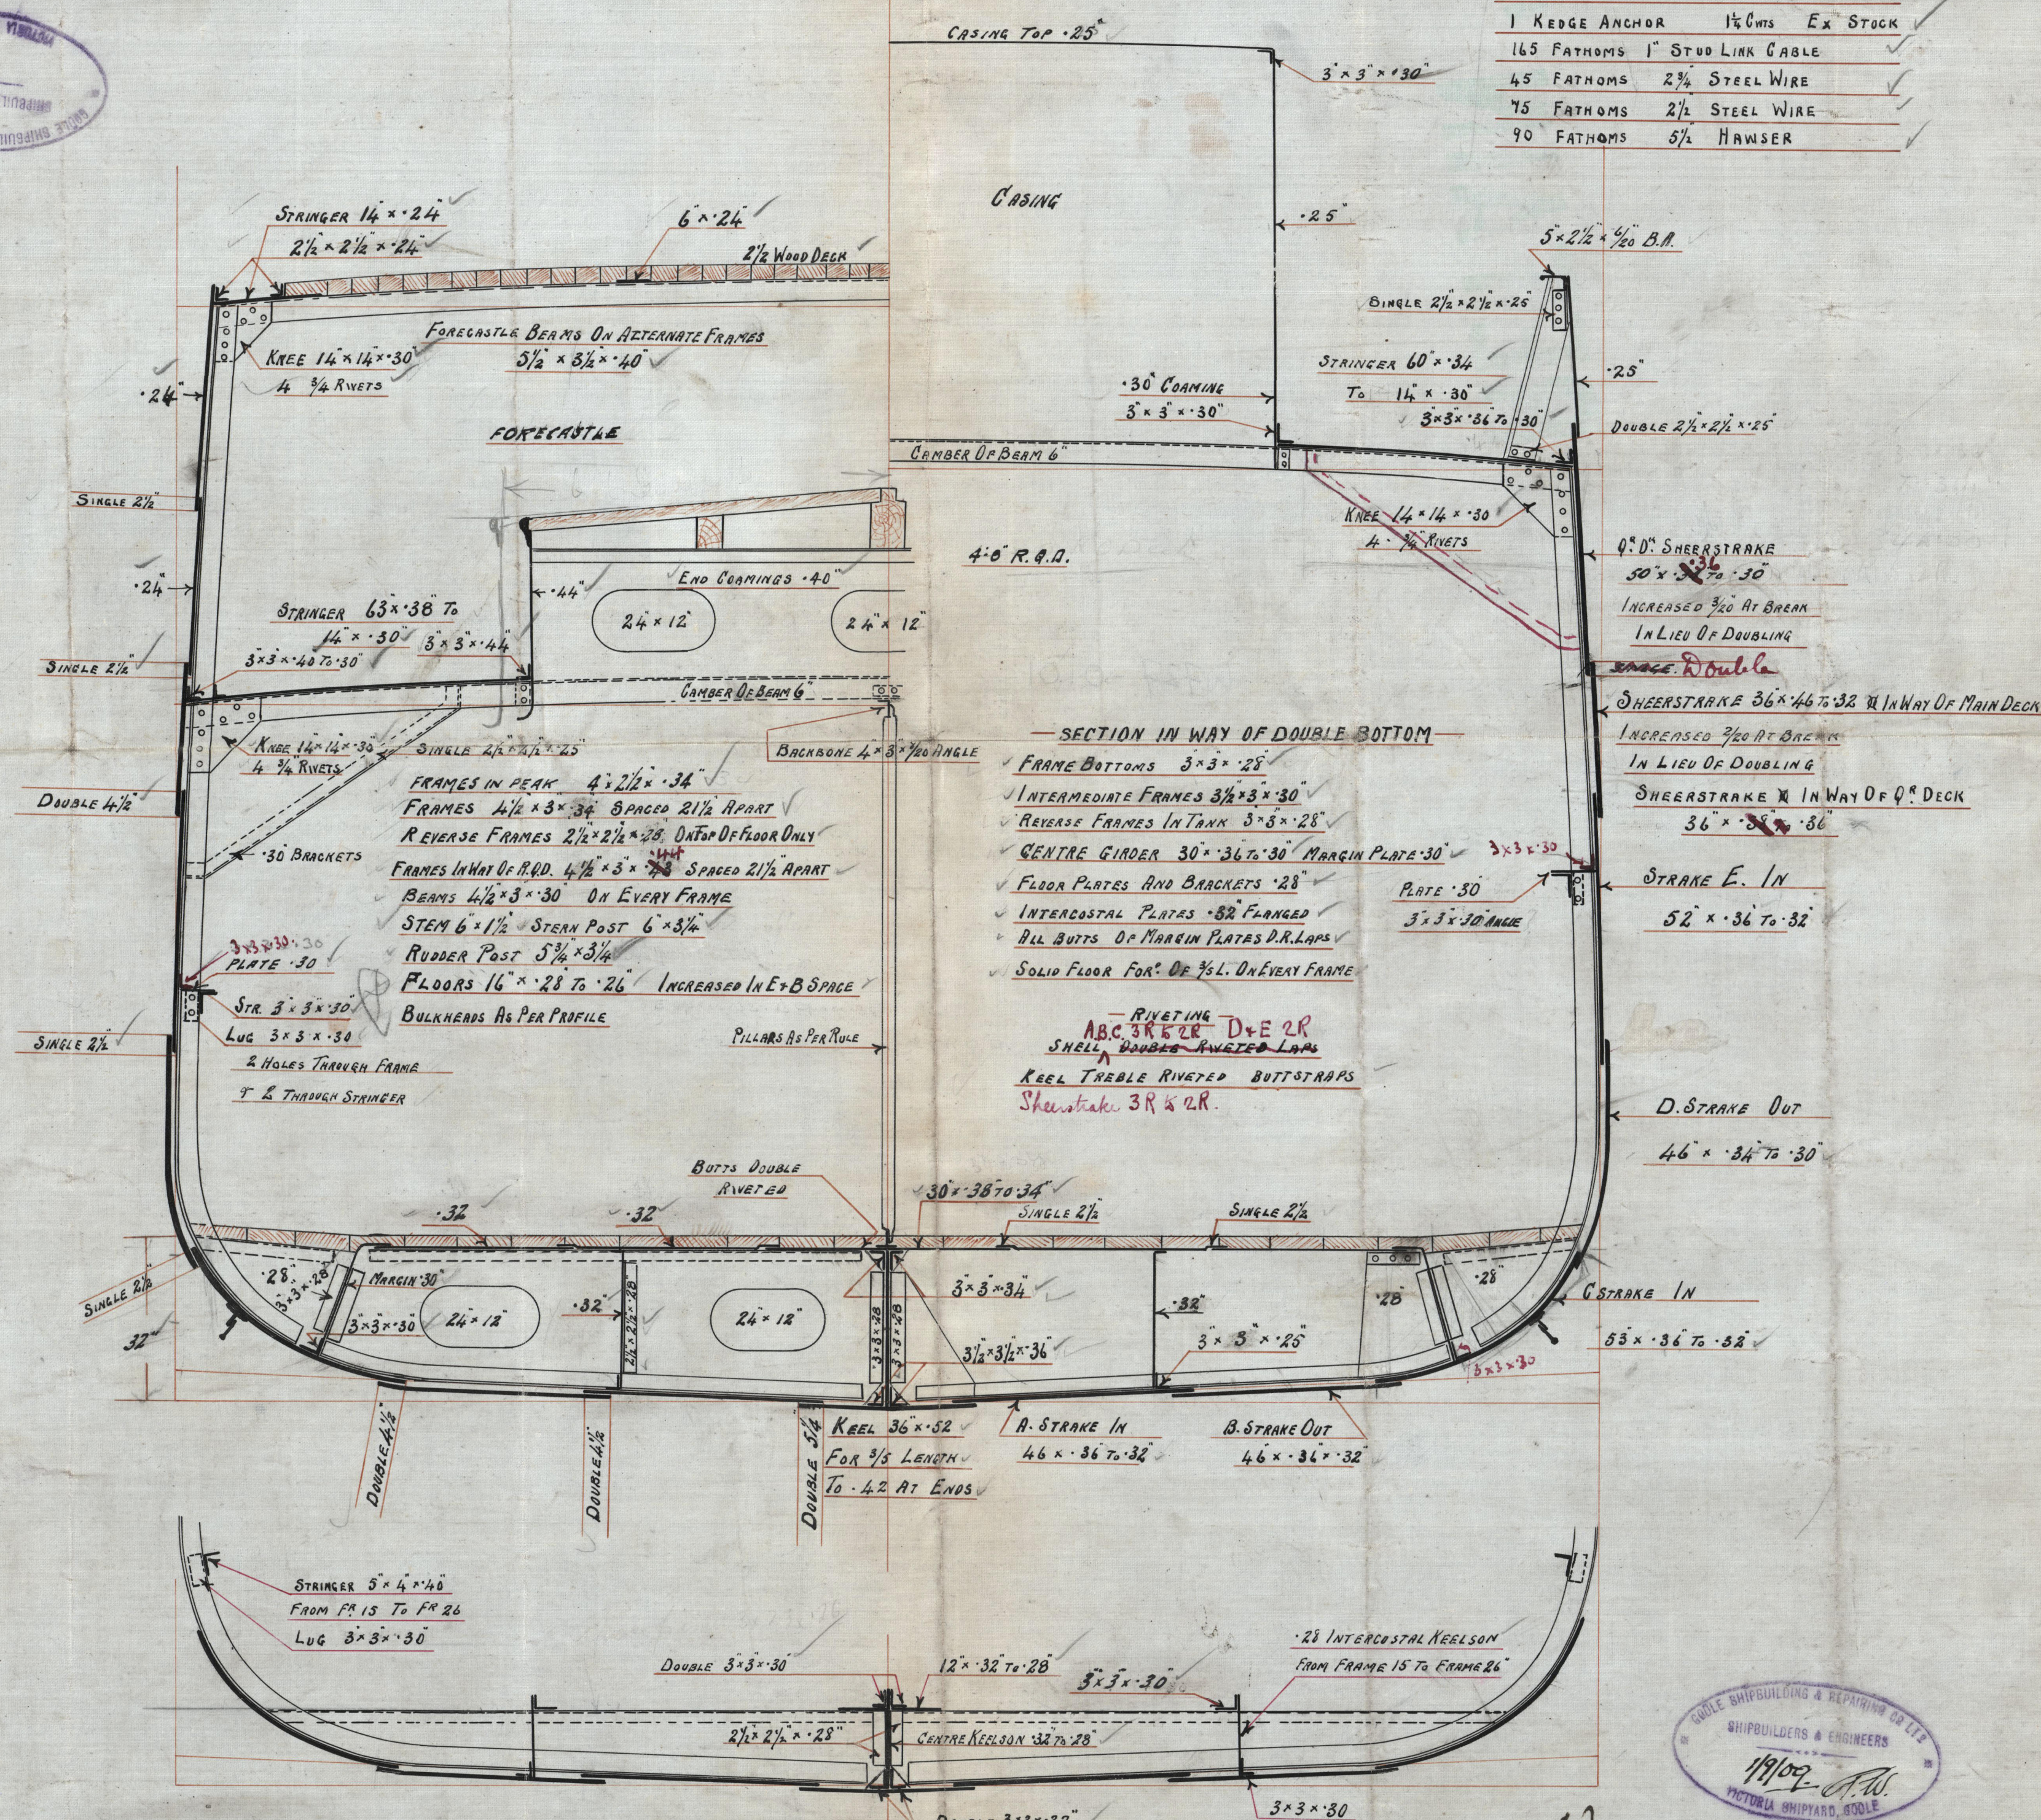

C.F.
20/9/09

Good S. R. C. 29

N. 129

Amended

Midship Section.

s/s James

Hull Report No.

22797



© 2021

Lloyd's Register
Foundation