

Good S. & R. C. Ltd

Nº 129


amended

Proper & Dietz

s/s Kames

Hull-Report No-

22797

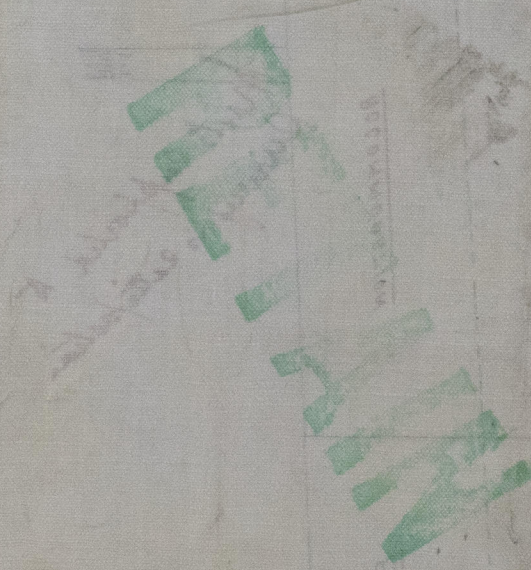

© 2021

Lloyd's Register
Foundation