

N° 148



ELEVATION

SCALE 1/4" = 1 FOOT

DIMENSIONS 130' 0" B.P. x 23' 6" EX. x 10' 6" MLD.



21.9.11
2.12.11
K 148
2 x 16 G. 100

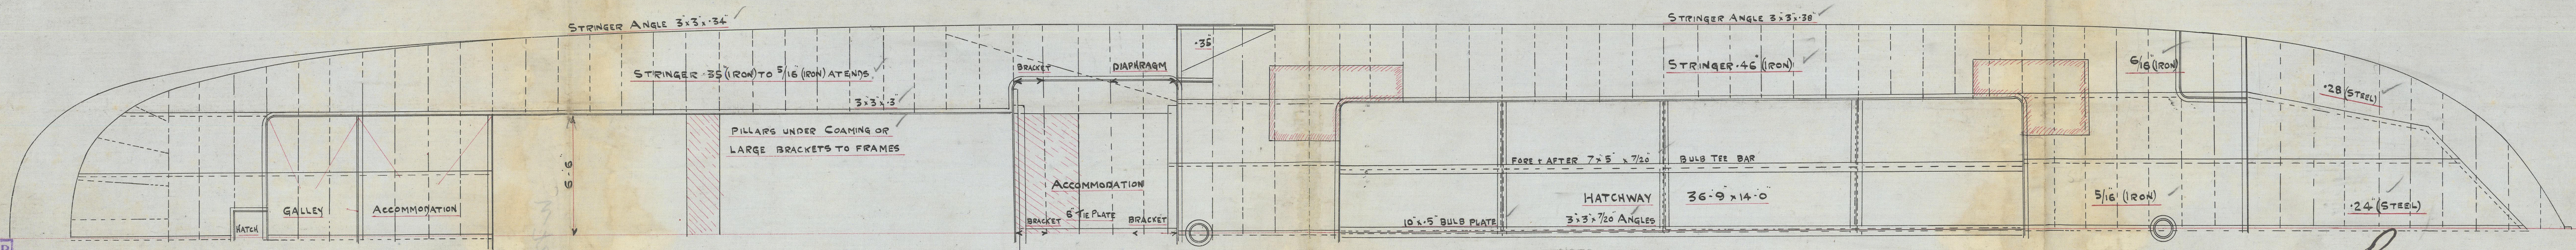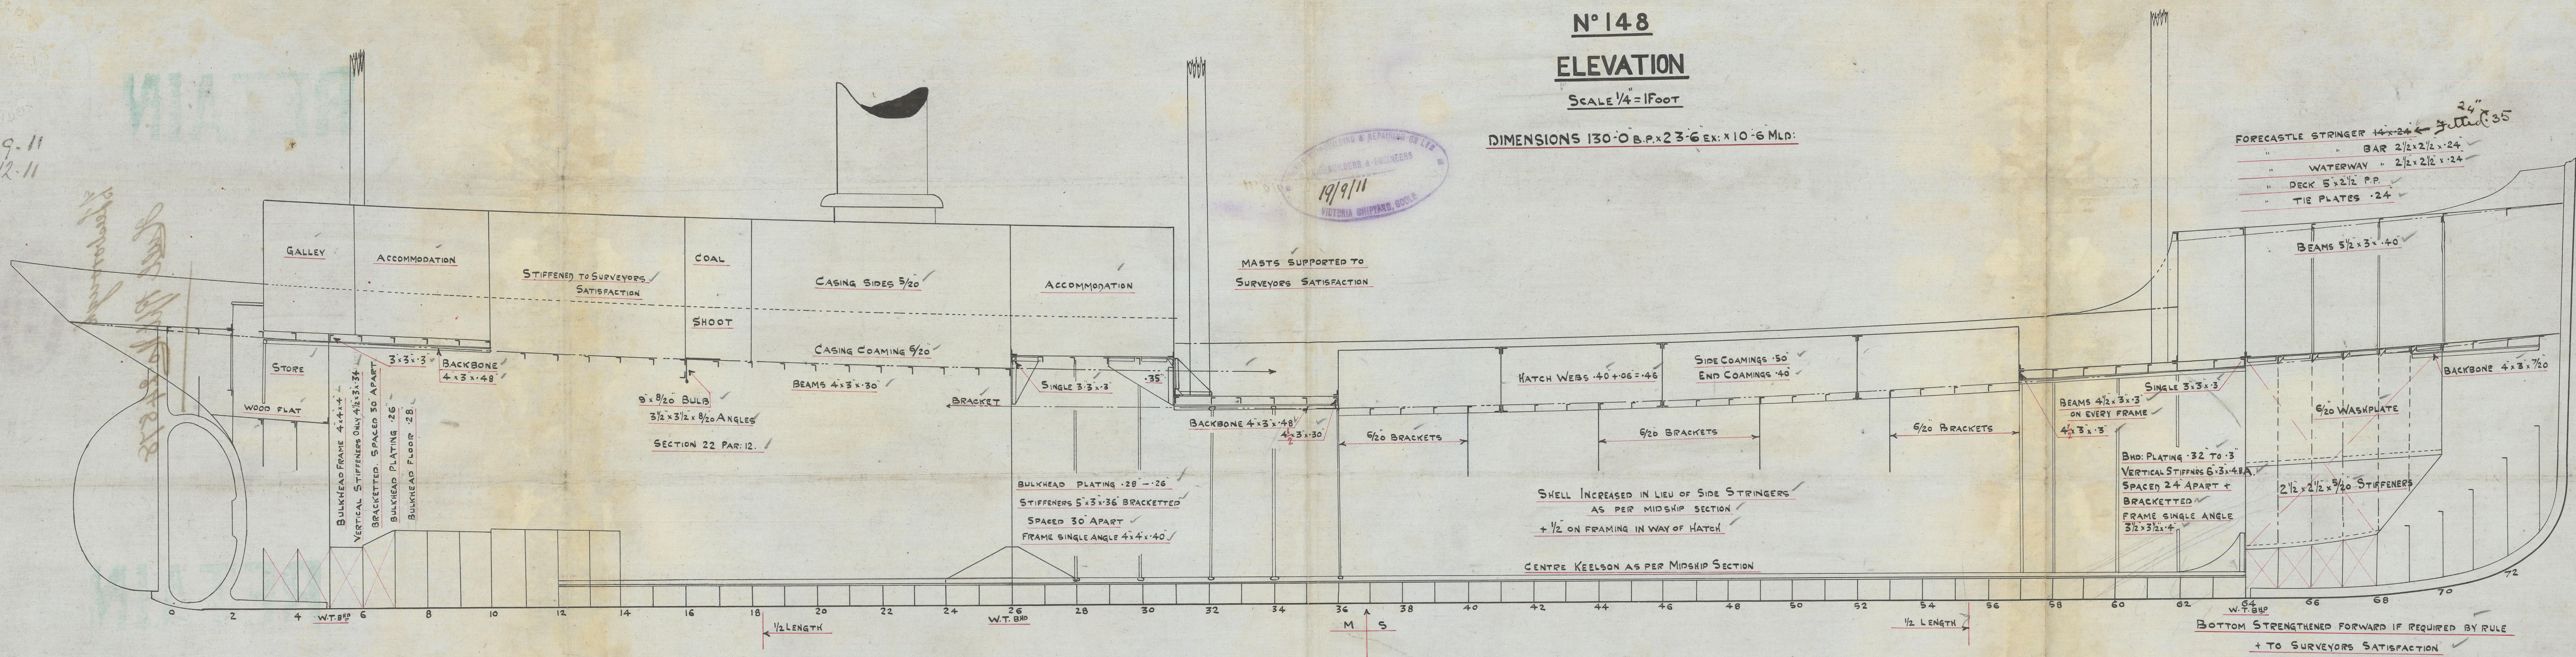

LLOYD'S REGISTER
OF SHIPPING
20 SEP 1911

C.B.
21.9.11.

LLOYD'S REGISTER
OF SHIPPING
20 SEP 1911

W728-0182

Lloyd's Register
Foundation

Goole S + R Co Ltd.


No 148

Amended.

Profile & Details.

Leesborough

Hull Rpt No: 24878

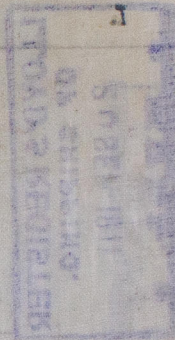

© 2021

Lloyd's Register
Foundation