

N<sup>o</sup> 148

# MIDSHIP SECTION

Dimensions 130'-0" x 23'-6" x 10'-6" Mid.

Scale 1/2" = 1 Foot.

## NUMERALS

BREADTH	23.37 ✓
DEPTH	10.5 ✓
TRANSVERSE No.	33.87 ✓
LENGTH	130.0 ✓
LONGITUDINAL No.	4403 ✓



$$\frac{L}{D} = \frac{12.38}{10.4} \text{ TO U.D. ✓}$$

$$\frac{L}{D} = \frac{10.4}{10.4} \text{ TO R.Q.D. ✓}$$

## EQUIPMENT

4403 (R.Q.D. 54.5 x 2.0) + 1/2 (DECKHOUSE 49 x 7.0) + 3/4  
(FORECASTLE 21.0 x 7.0) = 4794

1 BOWER ANCHOR	7 1/4 CWTs.	STOCKLESS ✓
1 " " "	7 " "	" " ✓
1 STREAM "	2 1/4 " "	EX STOCK ✓
1 KEDGE "	3/4 " "	" " ✓
165 FATHOMS	1 1/16" STUD CHAIN CABLE	✓
45 "	2 1/4" STEEL WIRE	✓
75 "	2 1/4" STEEL TOWLINE	✓
90 "	4 WARP	✓

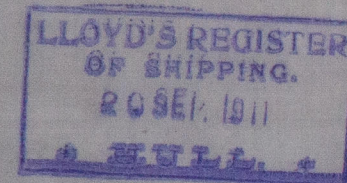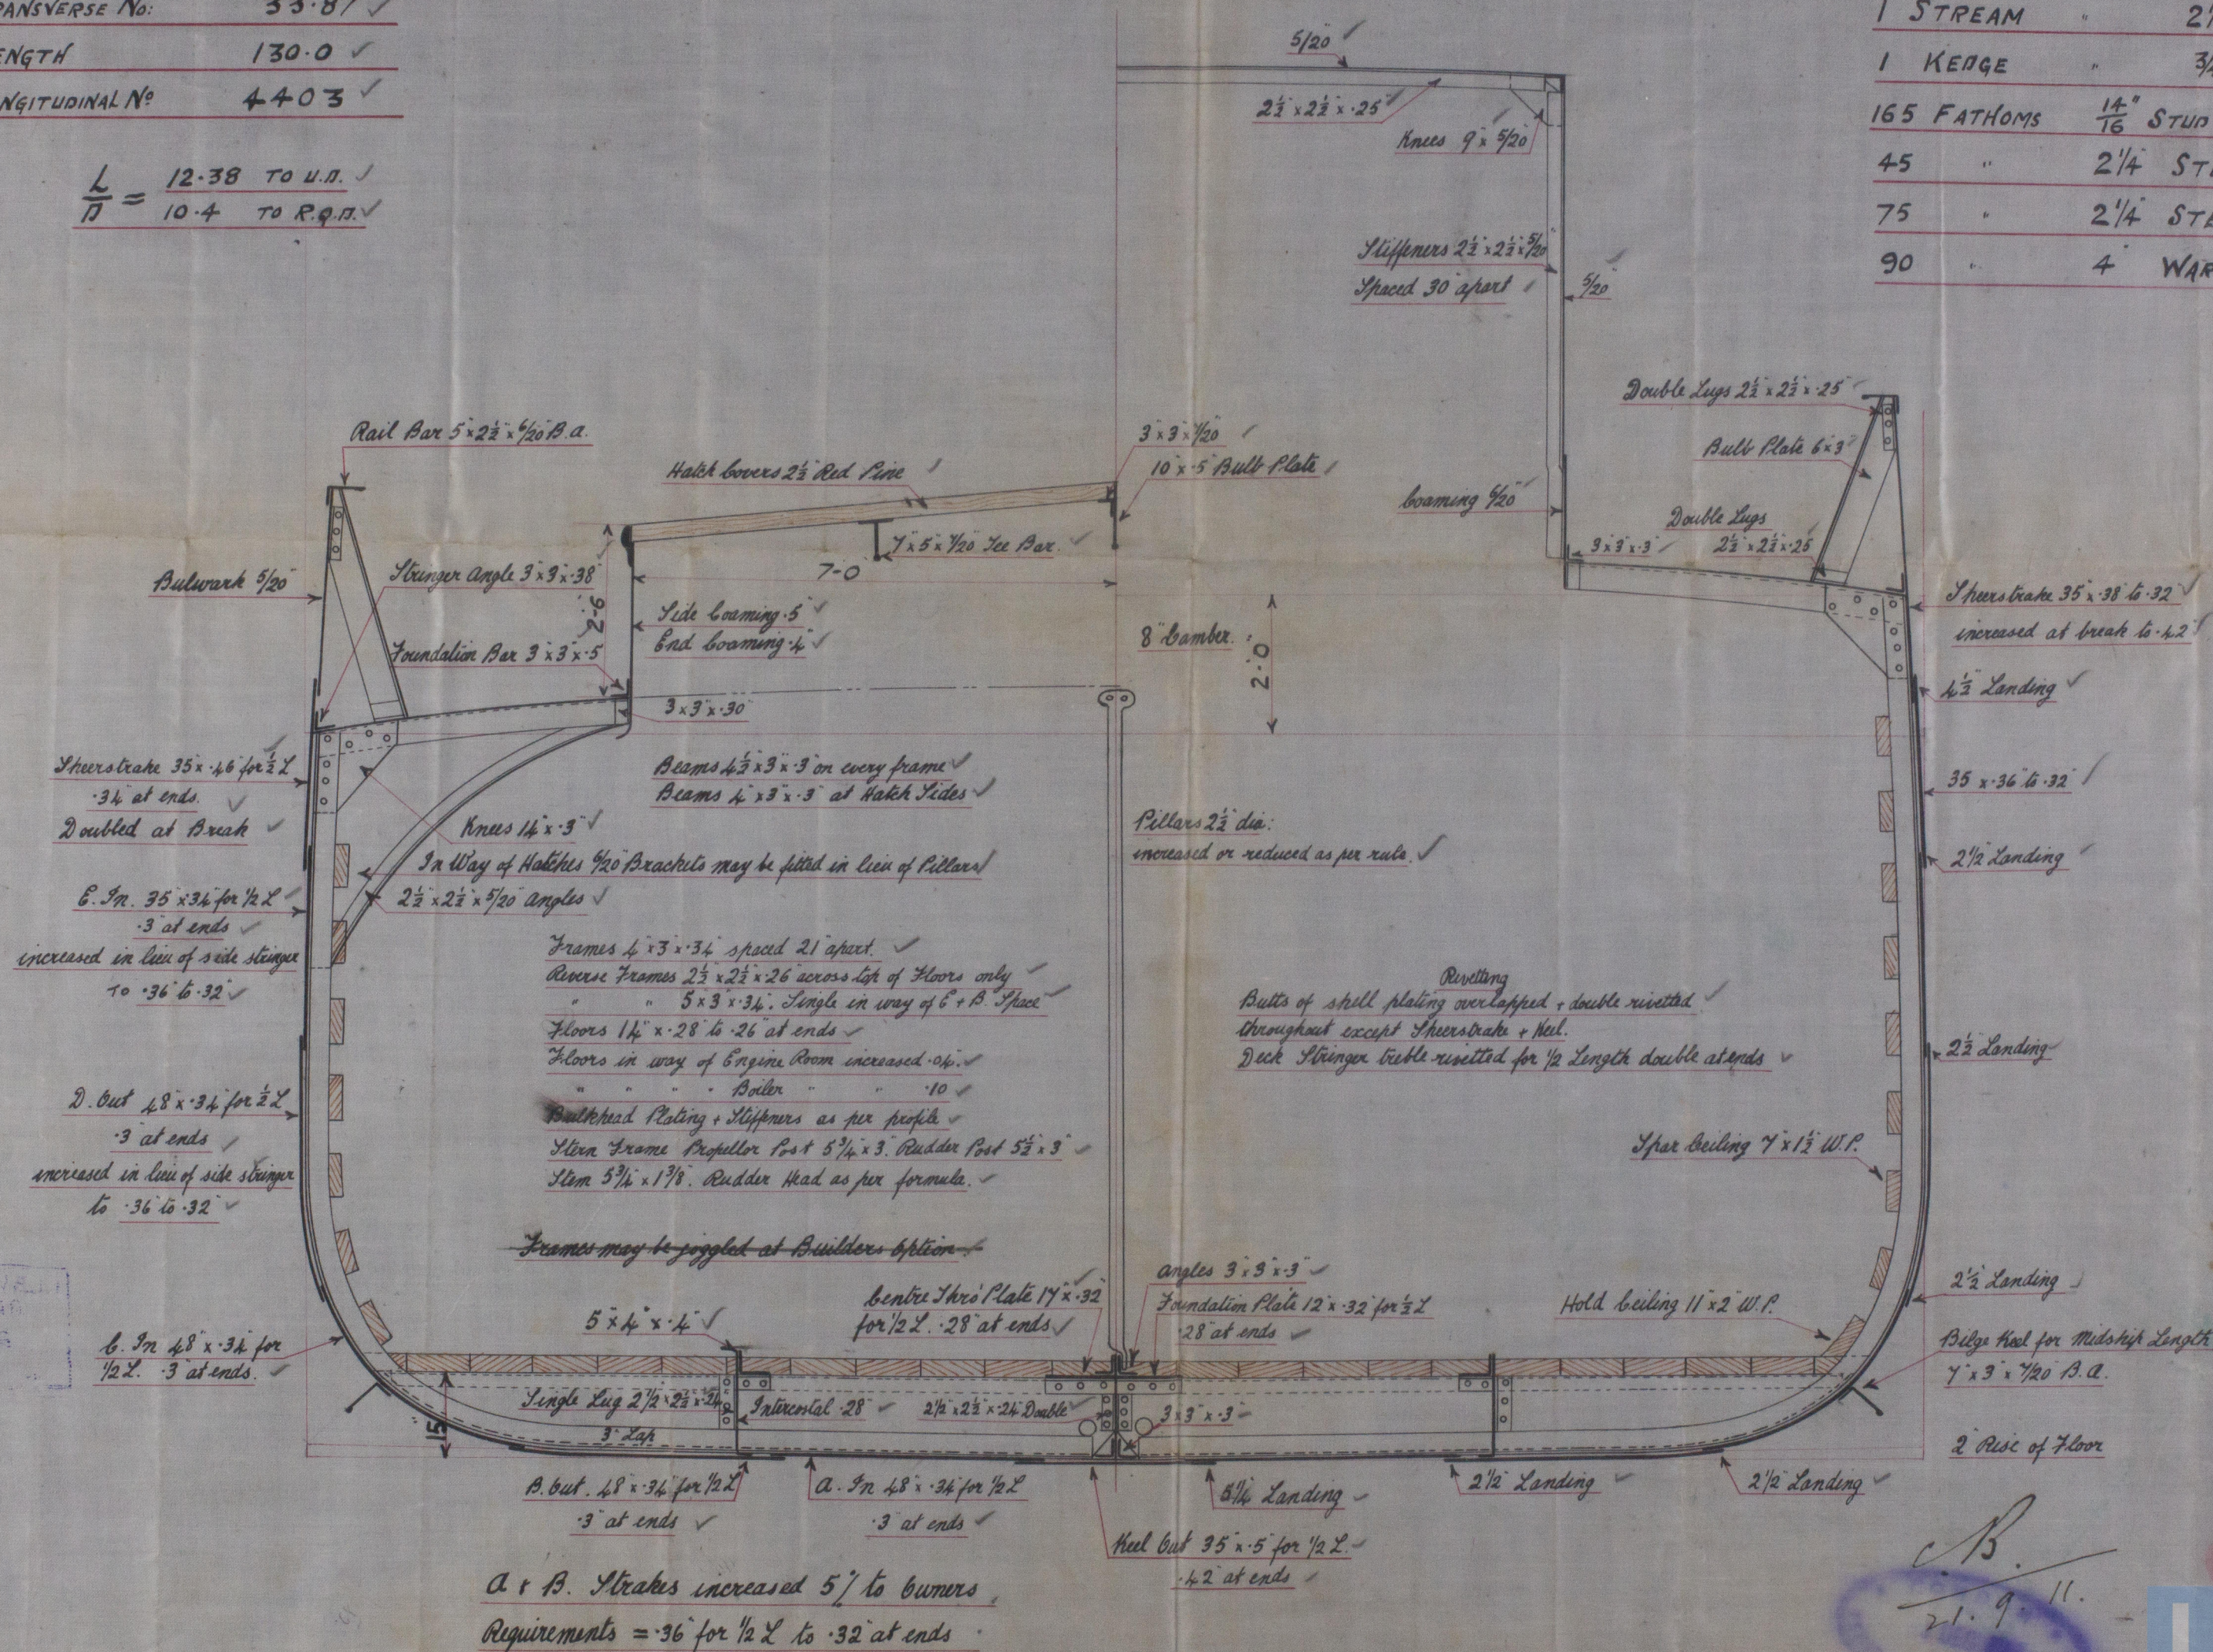




Boole S. & R. C. Ltd.

No 148.

Amended  
Midship Section.

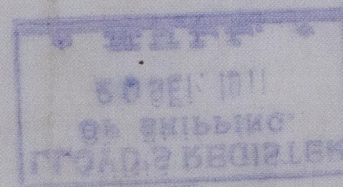

Leesborough  
Hull Regt No 24878



© 2021

Lloyd's Register  
Foundation

W 728-084