



LOUIS REGISTER
SHIPPING
LONDON

11-8-09.

Workman Clark & Co.
Nº 290
Profile & Deck Plan
S.S. *Warran*
11-8-09

Longitudinal Deck Plan Nº 290.S.S.
Dimensions 186'-3" x 28'-6" x 14'-3" hld. 30 main SK
Scale 1/8" = 1 foot

30 Class 100 A-1. Raised Quarters SK, Bridges & Tackle SK.

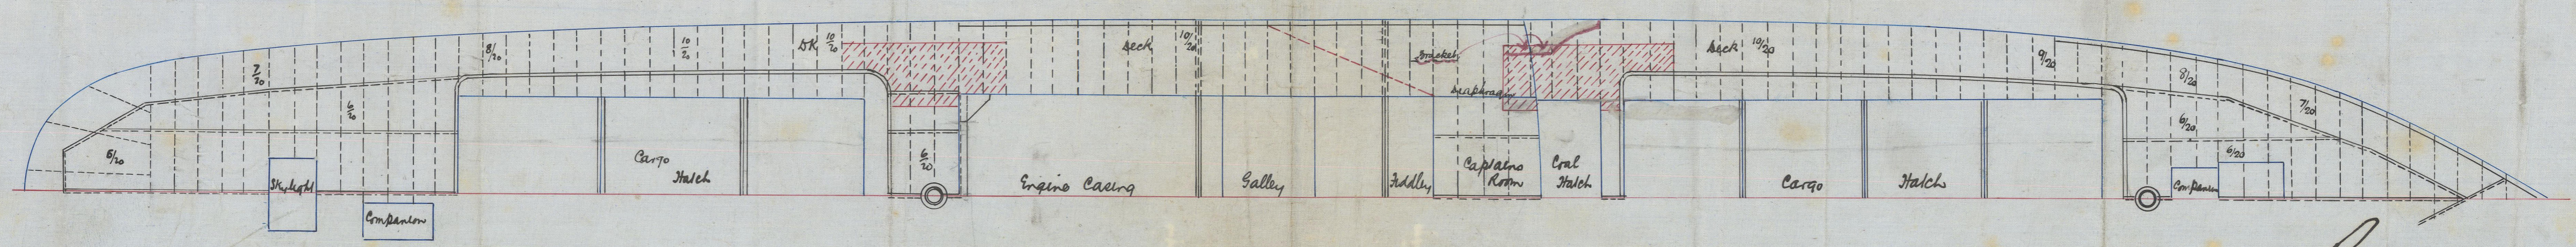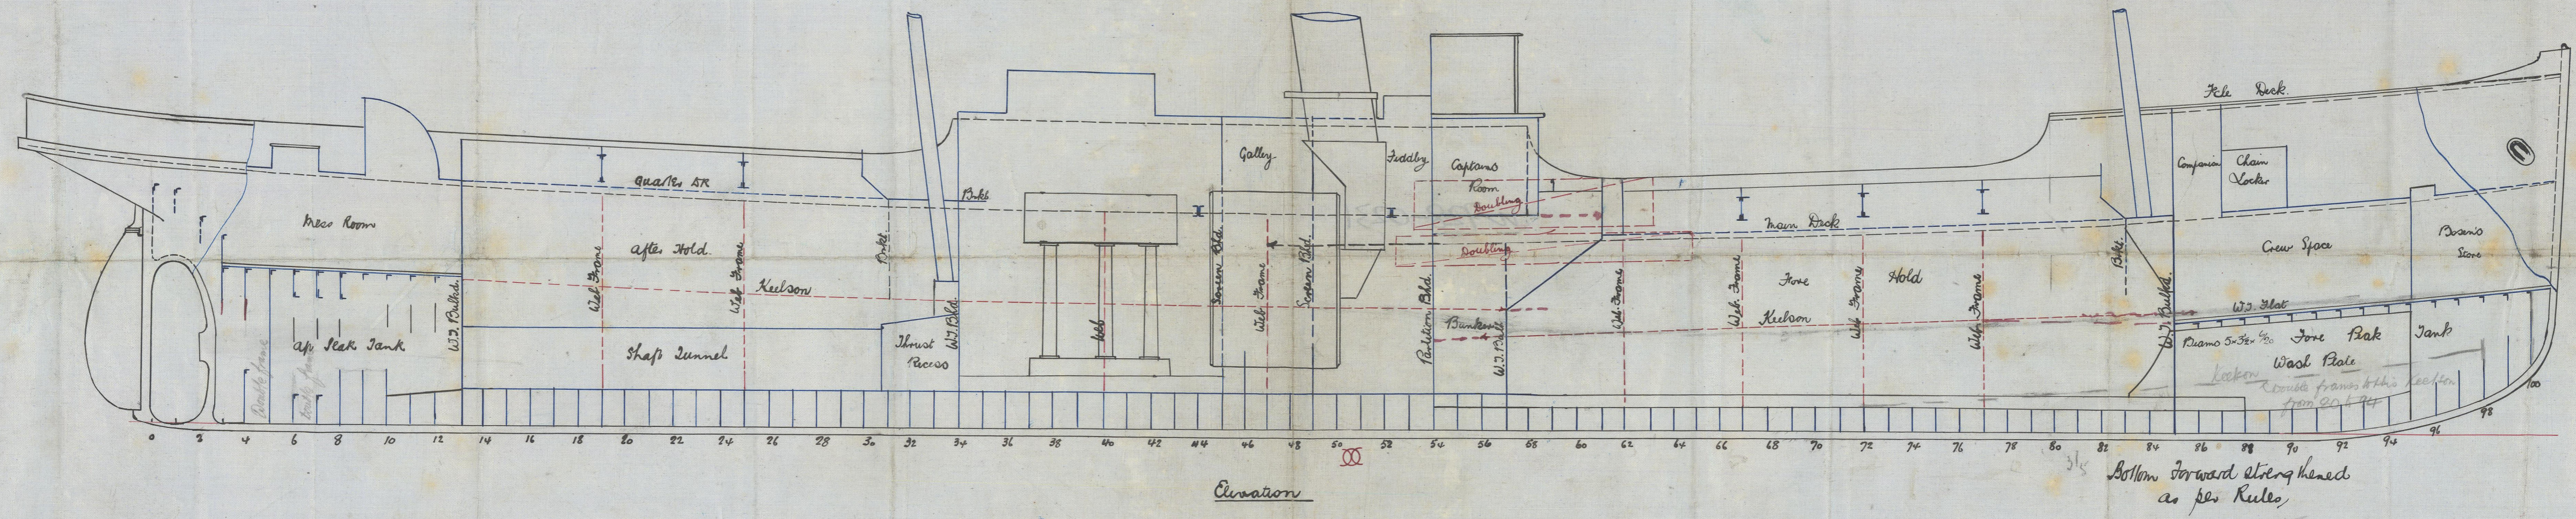

C.B.
11. 8. 09.



Lloyd's Register
Foundation

W-28-023

Watman Clarke & Co.



Nº 290

Profile & Deck Plan

amended

Genet

Bel by 43.

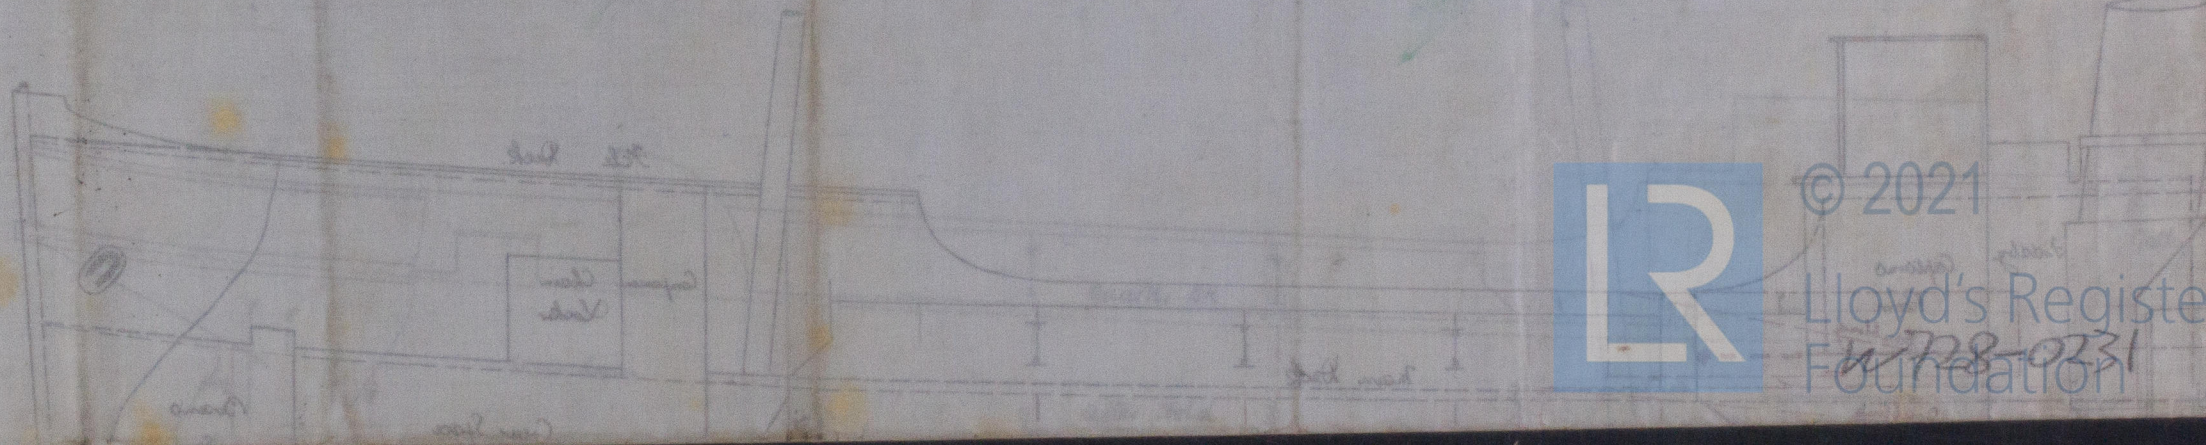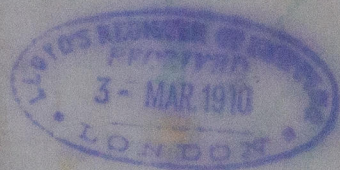

© 2021

Lloyd's Register
Foundation