


"PORT BRISBANE"
T.S.S. PORT AUCKLAND.

ALTERATIONS TO E.R. & THRUST RECESS BULKHEADS.

SCALE $\frac{1}{4}" = 1 \text{ FOOT}$

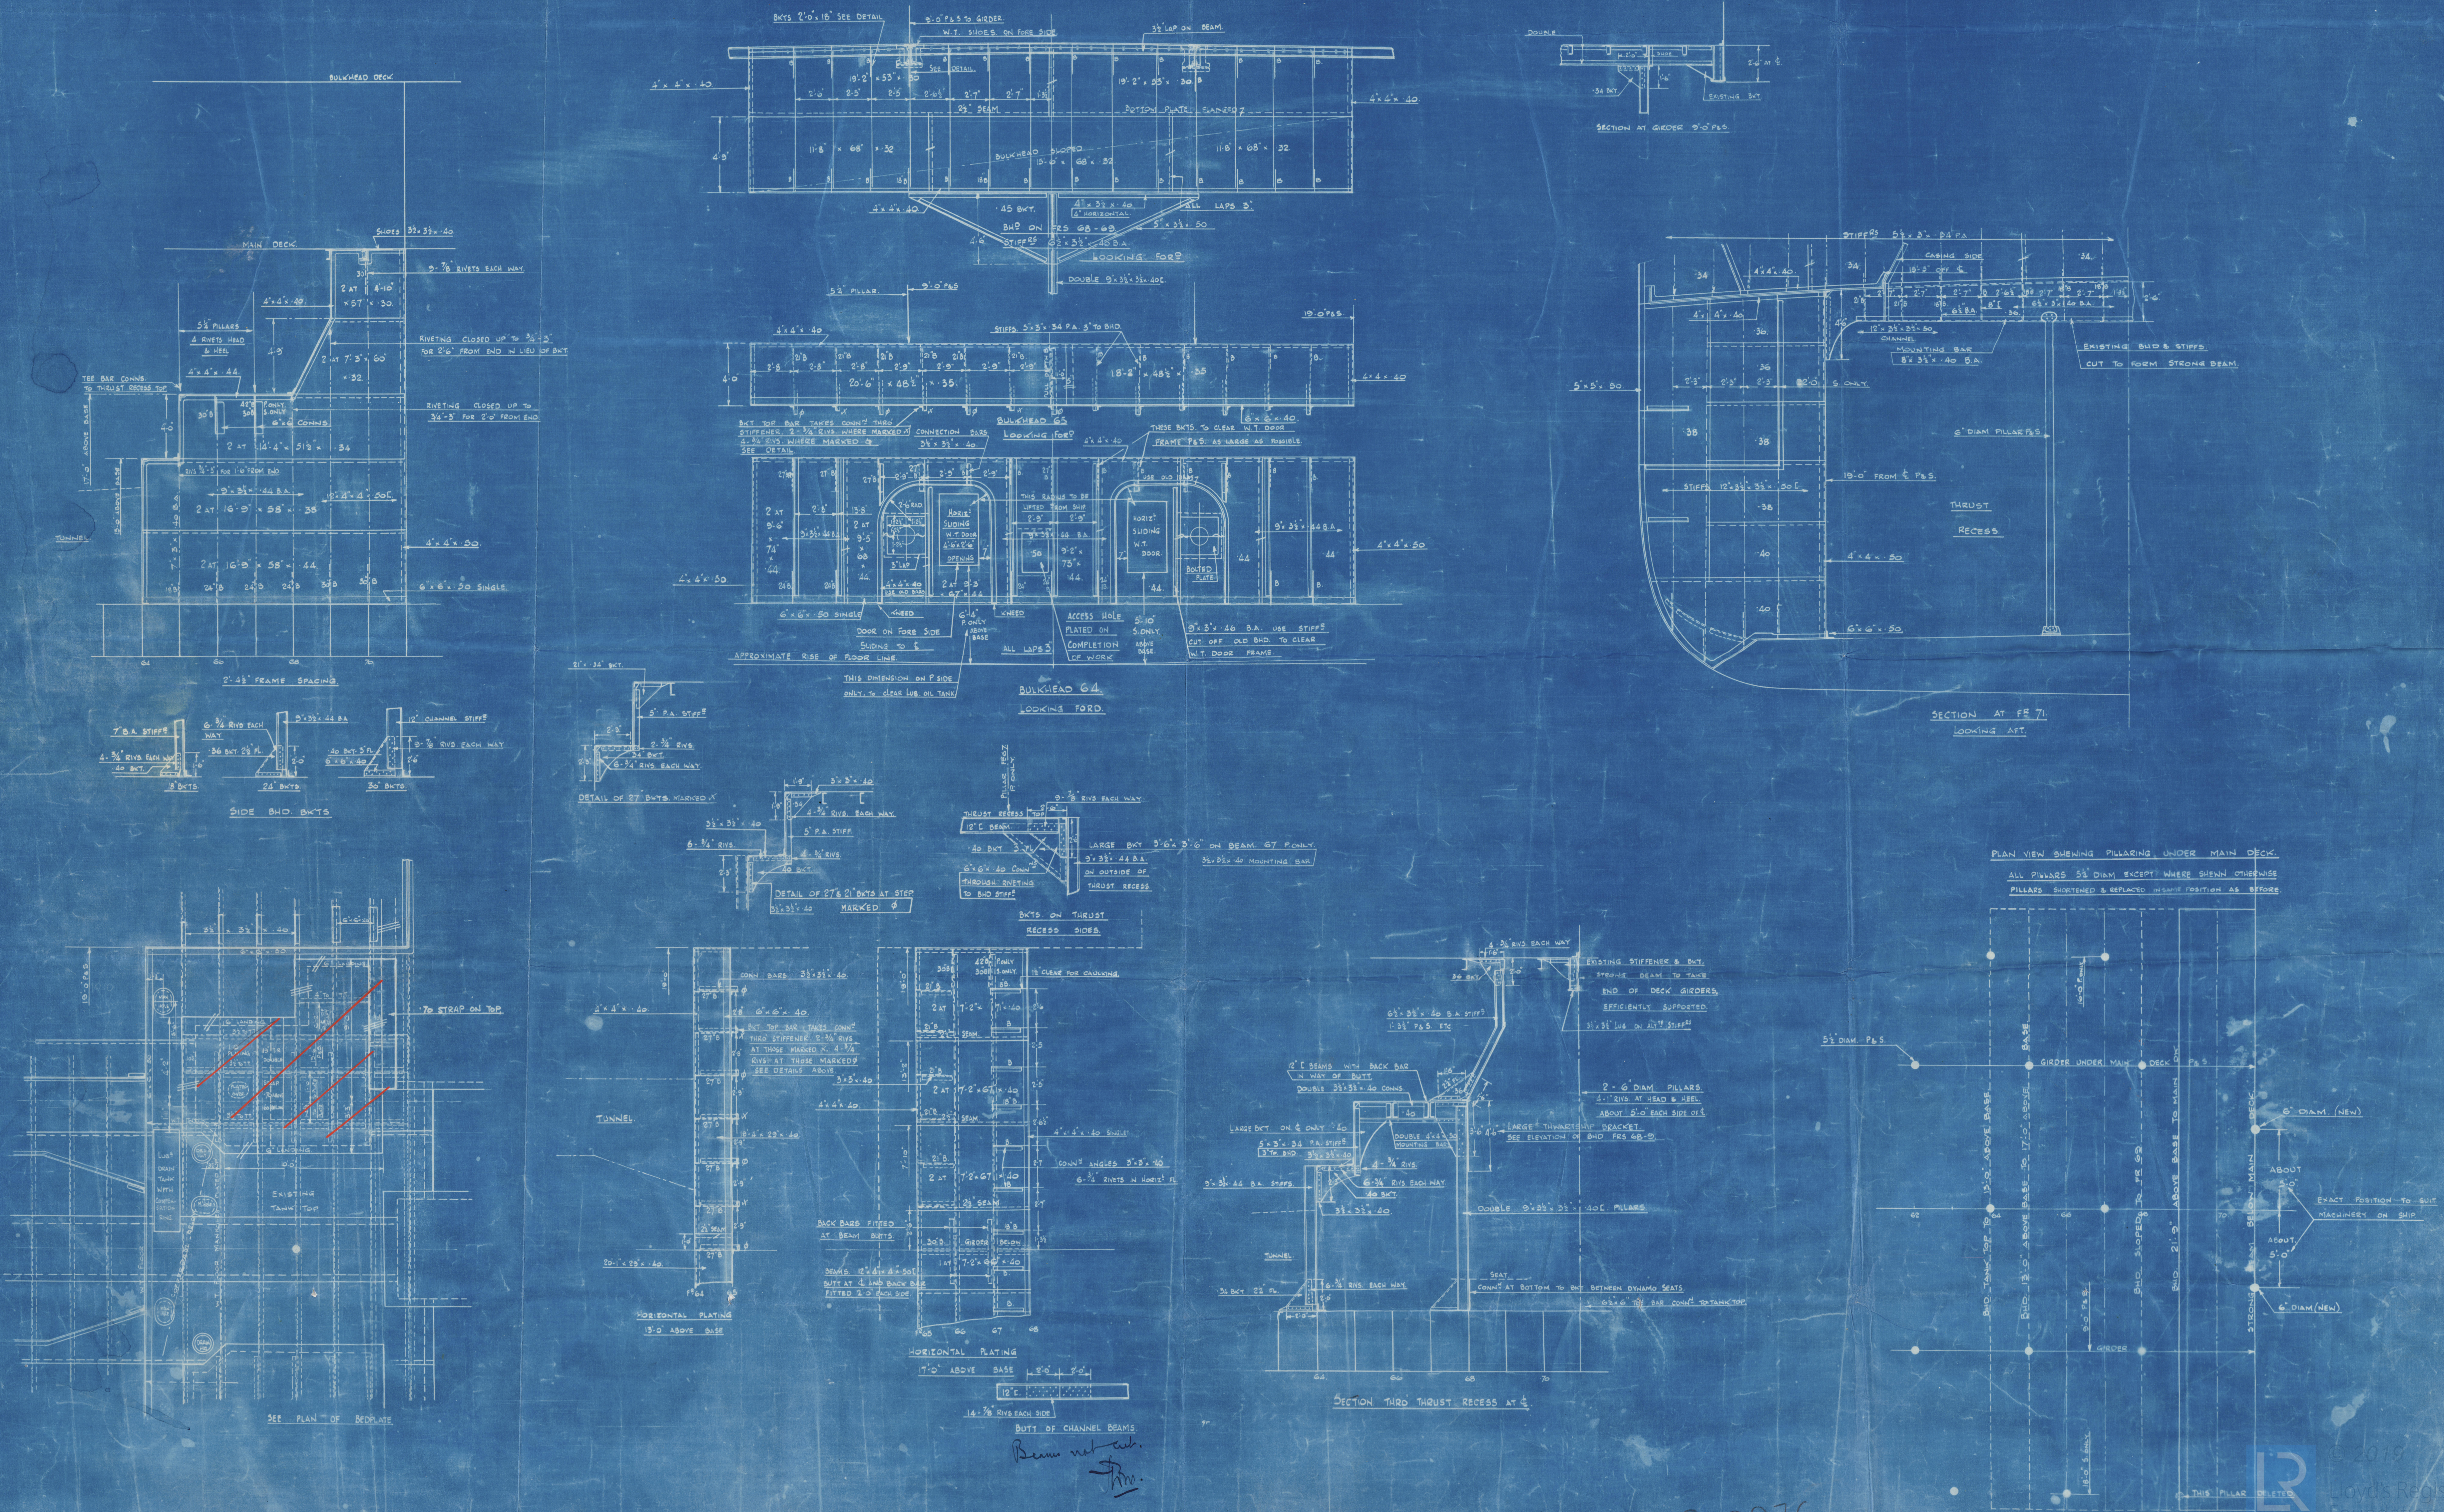

W73 0076

Port Brisbane

Alteration to E Room
Bulkhead to make
room for Bauer wash
Gear.

See Inve. Rpt.

J.S. & Port Brisbane.

NEWCASTLE ON TYNE.

Report No. 96078

W73-0076



© 2019

Lloyd's Register
Foundation