

Port Brisbane

Attention to ER
Tank Top to suit
Bauer Wash
Gear.

See Muc. Rpt.

T.S.S. Port Brisbane.

NEWCASTLE ON TYNE.

Report No. 86078.

W73-0077.1



© 2019

Lloyd's Register
Foundation


Alterations carried out
to tank top in connection
with fitting of low pressure turbine
on

Boys


"PORT BRISBANE"

TANK TOP IN WAY OF BAUER WACH GEAR

^{level of}
1" NEW TANK TOP PLATING FITTED BENEATH EXISTING TANK TOP PLATING.
FLOORS IN WAY CUT DOWN TO SUIT & NEW FLOOR REVERSE BARS FITTED.

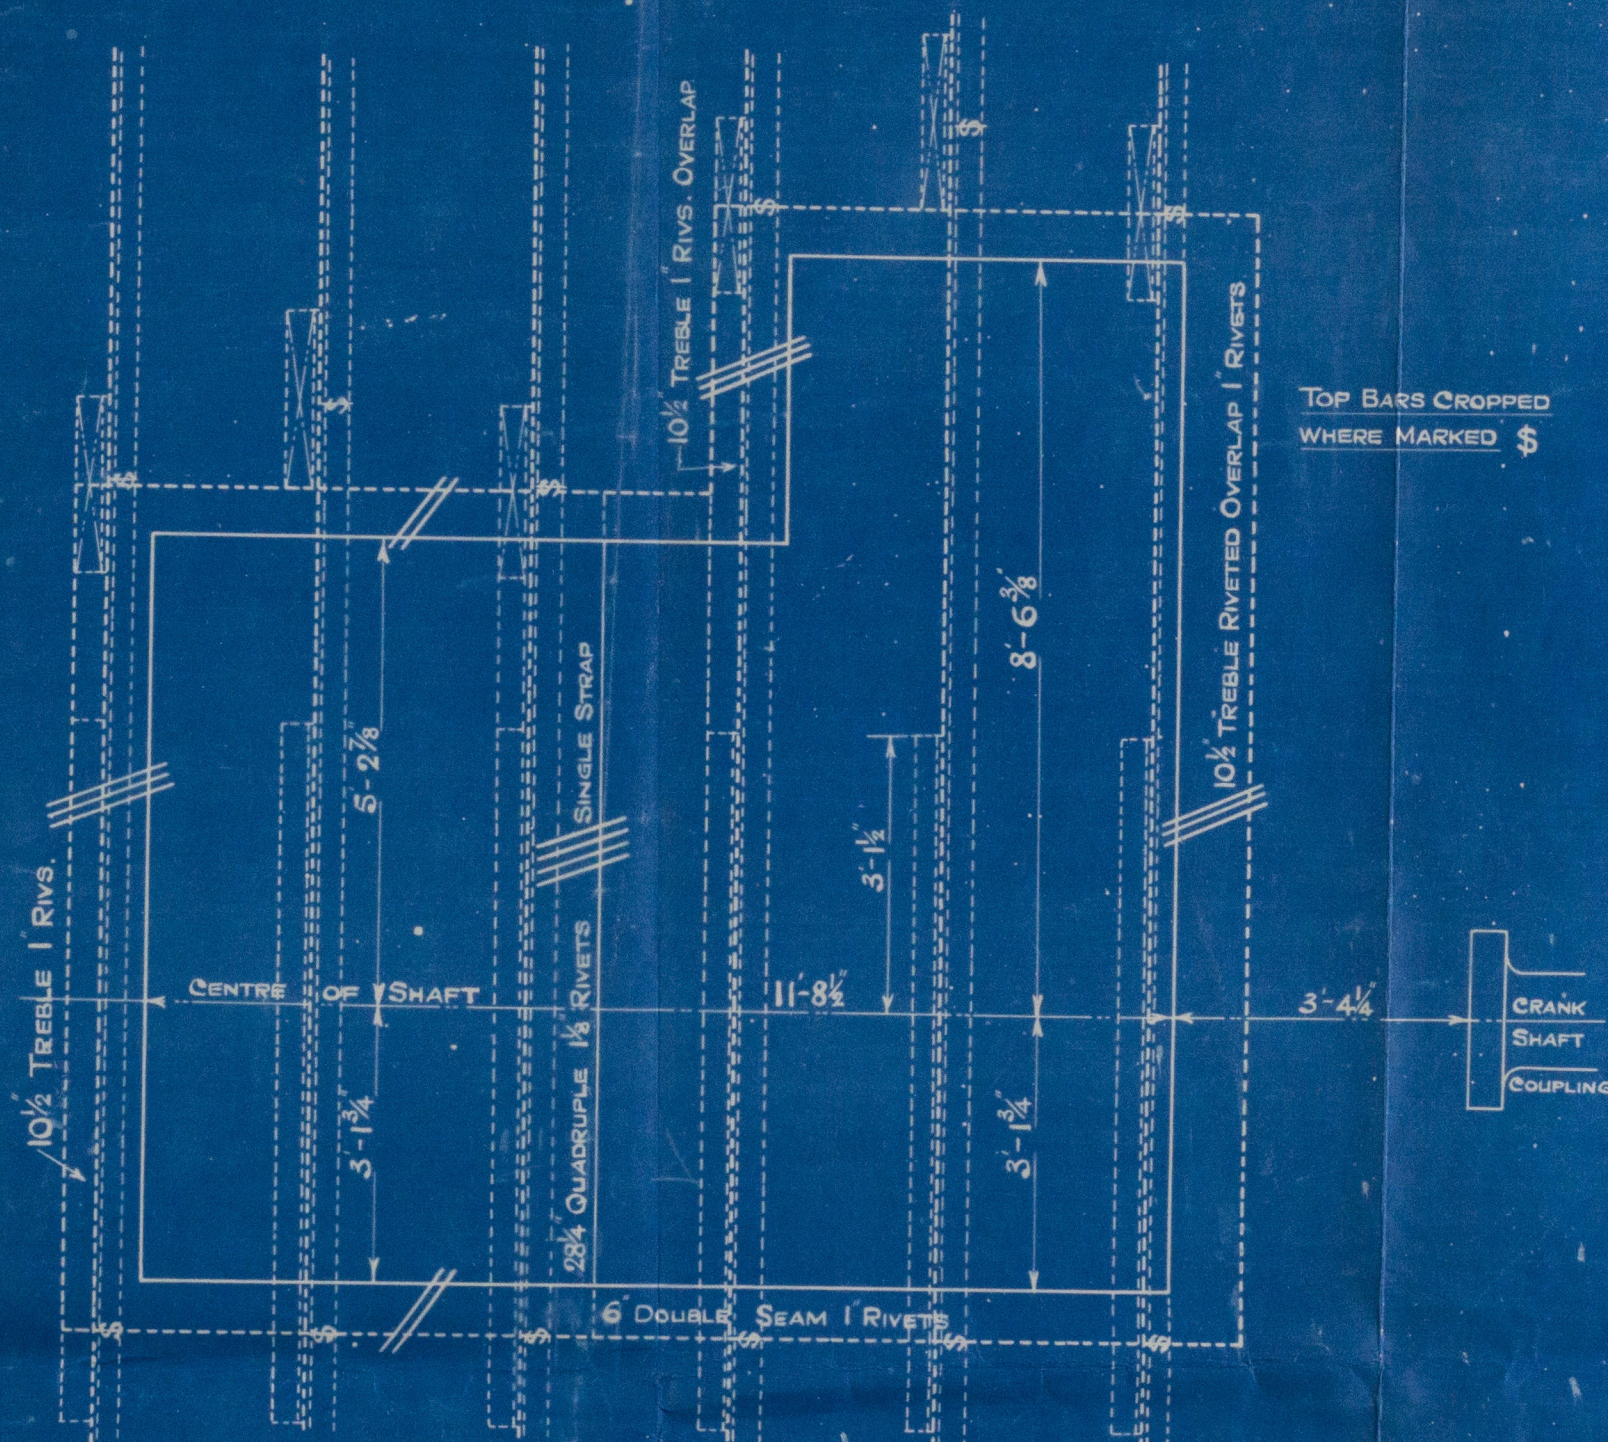

new floor to be
fitted, joggled to take new
1" tank top plate

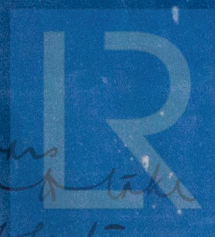

© 2019



W73-0077.1