

7.4.03  
25.4.03  
11.5.03  
2.6.03

# MIDSHIP SECTION No 110, 111, 112

SCALE 1/2" = 1 FOOT

ALL DIMENSIONS IN INCHES  
LENGTH 300.0  
BREADTH 48.0  
DEPTH 30.0


Date 26.3.03  
No 3104  
CLASS OFFICE  
BOWDON-ON-TYNE

EQUIPMENT No 40331

CLASS 100 A1 SPAR DECK LLOYDS  
SPECIAL FREEBOARD STRENGTHENED SIDES

Date 26/3/03  
No 3104  
BOWDON-ON-TYNE

2 BOWER ANCHORS (STOCKLESS) 3/2 CTS EACH ✓  
1 STREAM ROSE ✓  
1 KEDGE ✓  
270 FATHOMS 28 STD CHAIN CABLE ✓  
90 44 STEEL WIRE STAY OR 3/2 SPECIAL FLEX WIRE (ONLINE) - 3/2 ✓  
10 44 3/2 ✓  
10 25 ✓  
2 40 3/2 ✓  
2 40 3/2 ✓  
3/2 TAILLARD HARPS ✓  
3/2 ✓

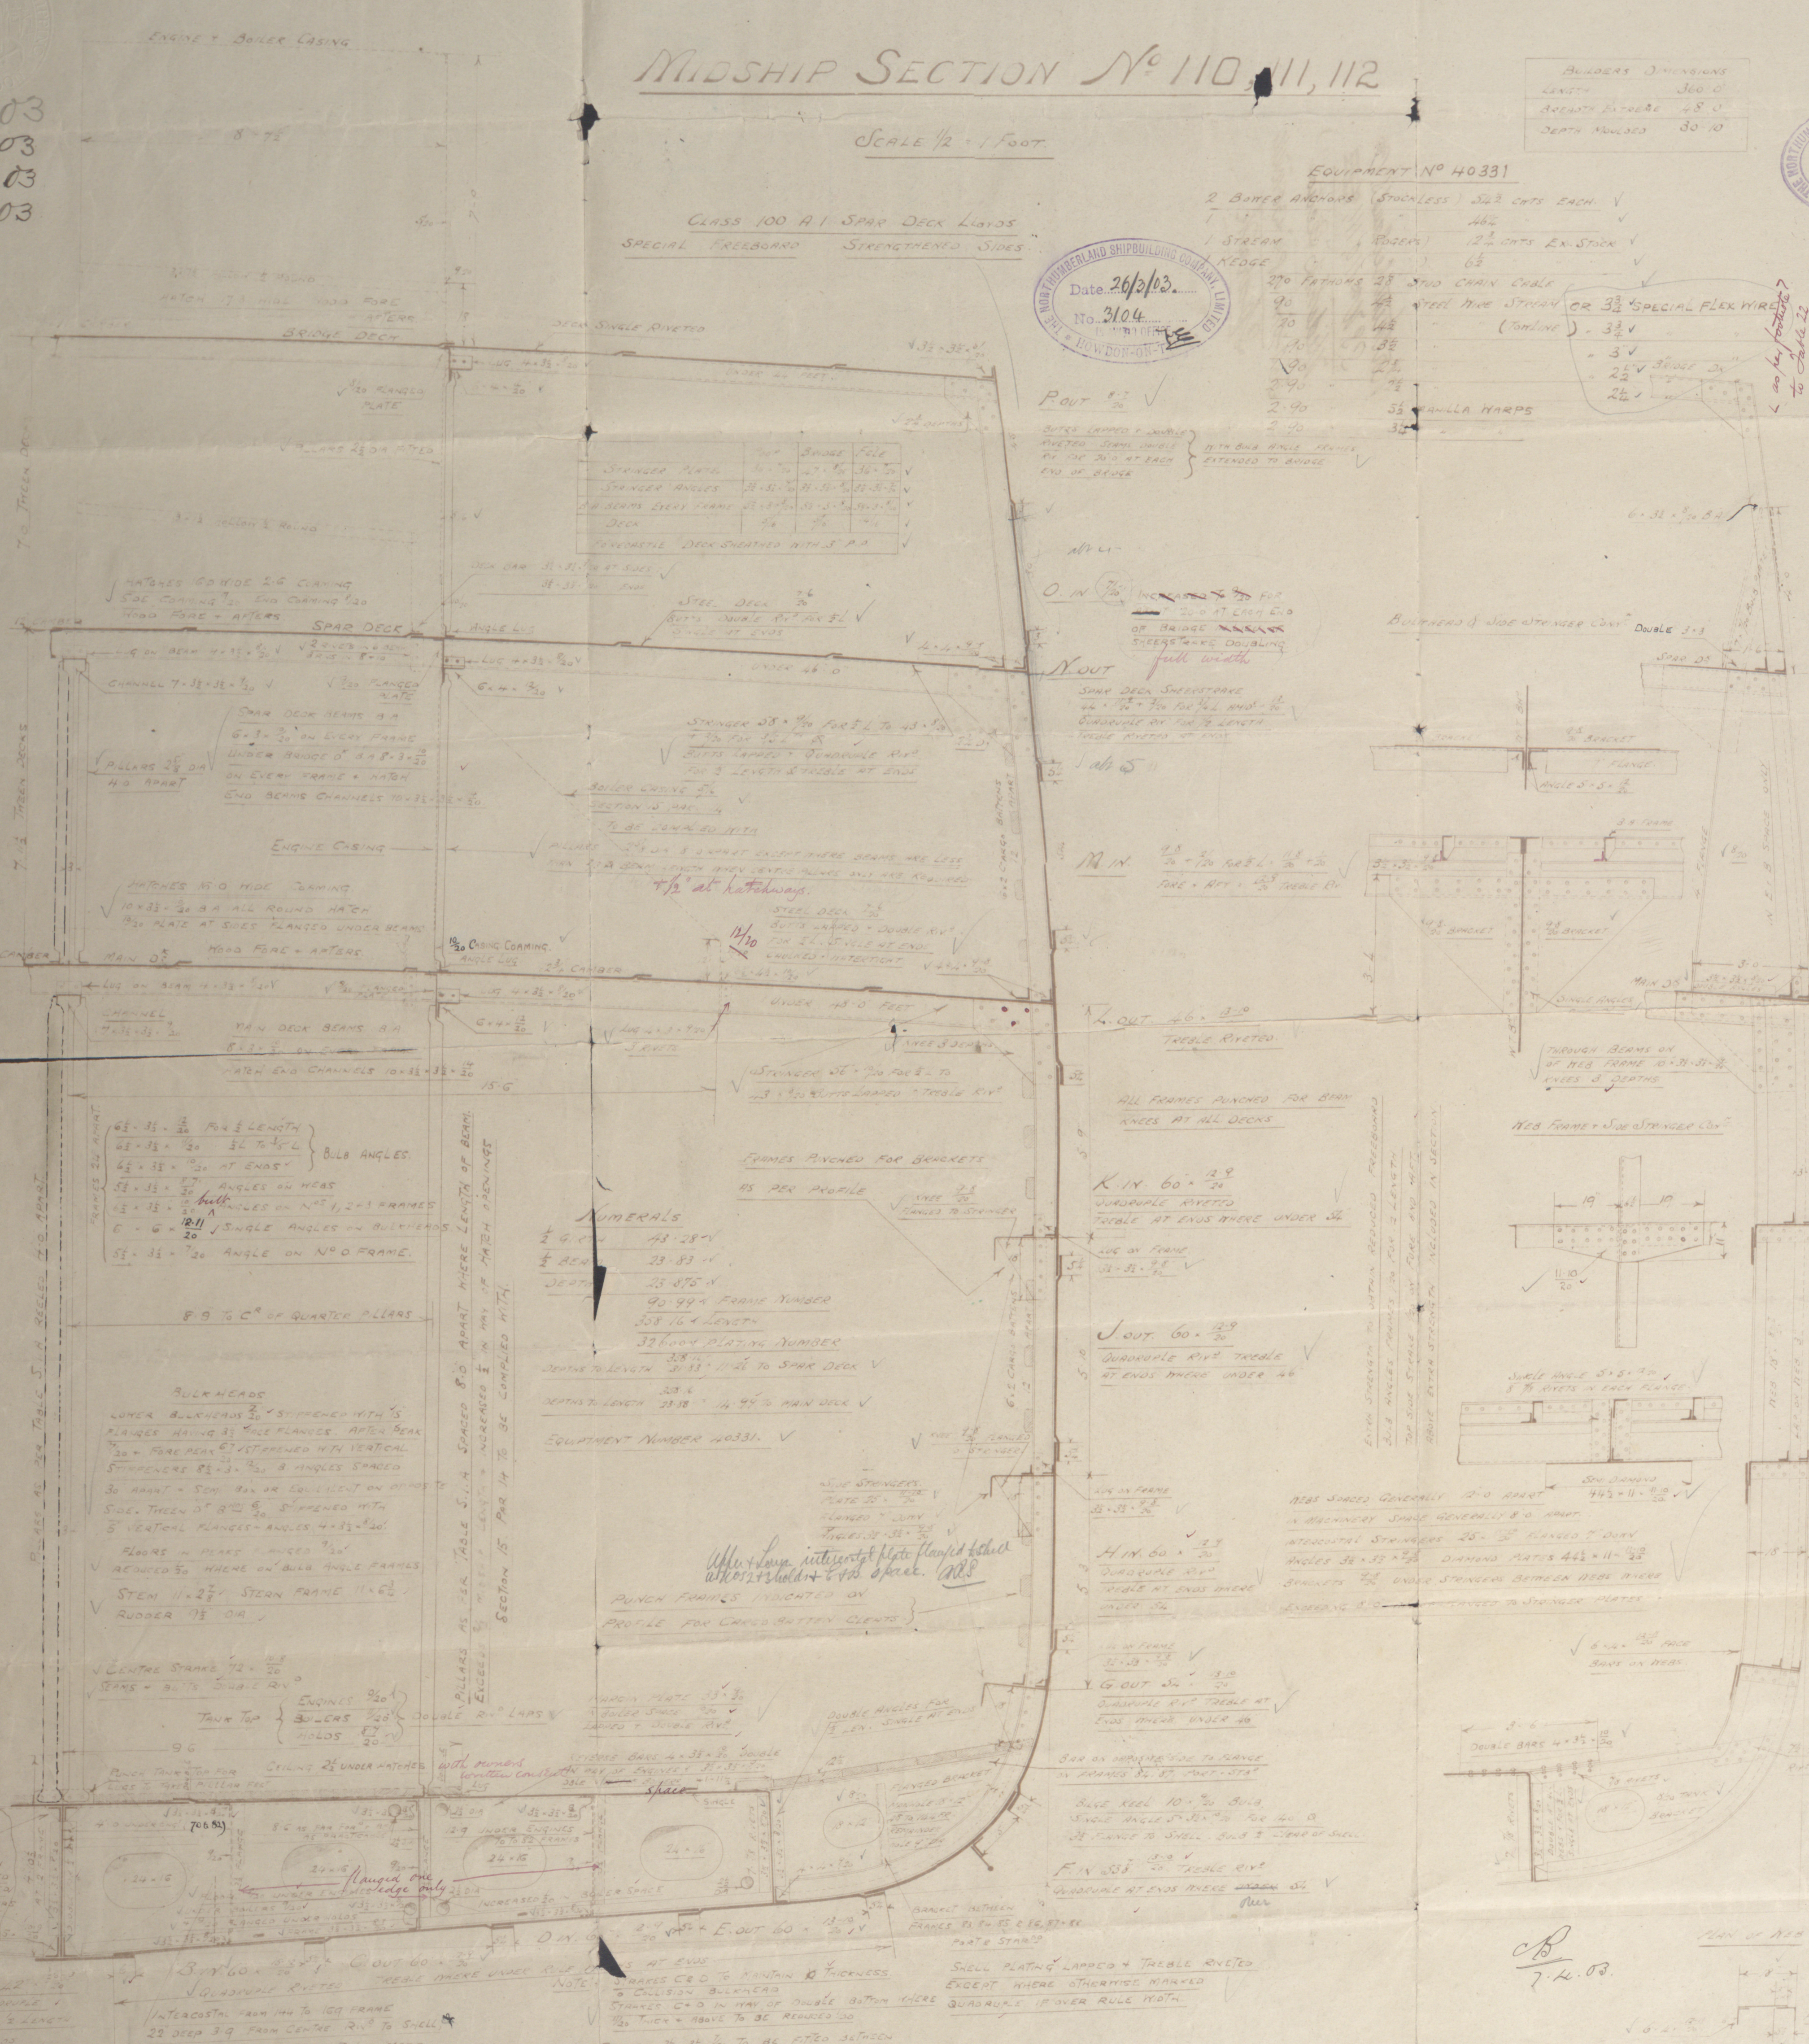

**NUMERALS**  
1/4 4.28 ✓  
1/2 28.83 ✓  
3/4 28.87 ✓  
90 994 FRAME NUMBER  
308 164 LENGTH  
32 100 PLATING NUMBER  
DEPTH TO LENGTH 28.83 1/4 40 1/2 MAIN DECK ✓  
EQUIPMENT NUMBER 40331 ✓

**BULK HEADS**  
LOWER BULK HEADS 30" STRENGTHENED WITH 1/2" PLATES HAVING 3/4" FLANGES. AFTER BEAK 20" FINE BULK HEAD STRENGTHENED WITH VERTICAL STRENGTHENERS 8 1/2" 3/4" 3/4" ANGLES SPACED 30" APART. 30" DIA OR EQUIVALENT ON OPPOSITE SIDE. THREE OF 8 1/2" 3/4" STRENGTHENED WITH 5" VERTICAL PLATES - ANGLES 4 1/2" 3/4" 30".  
FLOORS IN PLATE 1/2" 20" REQUIRED 50" HANGERS ON BULK HEAD FRAMES  
STERN 11 1/2" STERN FRAME 11 1/2" 30"  
RUDDER 15" DIA







321



$\frac{18}{20} \times 3$



Northumberland S. Co.  
S.S. No. 110 ~~111~~  
Midship Section  
360'0" x 48'0" x 30'0" all.  
Sparck.

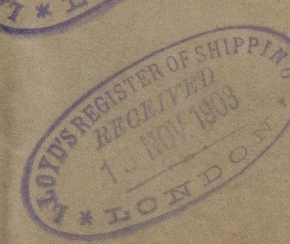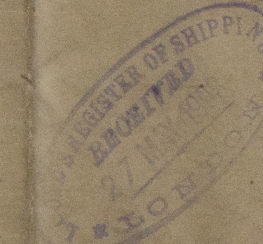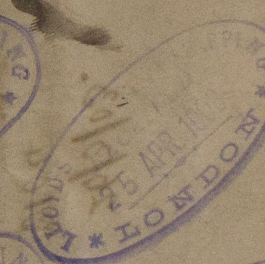

S.S. Canada Cape

Newcastle Report

No. 46573

S.S. Agincourt

Newcastle Report

No. 46523