

EQUIPMENT N^o 52270

LENGTH BETW. STEM & STERNP. 421.3" = 128.39 MTR.
BREADTH MLD. 54.11" = 16.74 "
DEPTH MLD. TO SPARK 31.3" = 9.52 "

| | | | |
|-----------------|--------------------|--------------------|--|
| $\frac{1}{2}$ B | 27.45 | | |
| $\frac{1}{2}$ G | 48.35 | | |
| LD | 24.50 | | |
| | <hr/> | | |
| | 100.30 | 1 ST N° | |
| 42251 | 2 ND N° | | |


3DK NUMERALS

| | |
|--------|--------------------|
| 109,14 | 1 ST N° |
| 45975 | 2 ND N° |

| | | | |
|--|-----|----|---------|
| 3 Bowers stockless patent | --- | a | 65 cwt. |
| 1 Stream Anchor excl. stock | --- | 19 | " |
| 1 Hedge " " " | --- | 8 | " |
| 270 fathoms steel chain cable | --- | 2 | 76 " |
| 90 " Stream chain $1\frac{1}{2}$ " or steel wire | --- | 5 | 50 cire |
| 120 " Hemp | --- | 15 | cire |
| 2 of 90 " " | --- | 8 | " |
| 2 of 90 " " | --- | 4 | " |

| British Section | Equiv. Germ. Section |
|--------------------------|-------------------------------------|
| 9 - 3 1/2, 1/20 I | 220 - 90 - 15 1/2 |
| 8 - 3 1/2, 1/20 - 1/20 I | 200 - 85 - 15 - 14 1/2 |
| 7 1/2 - 3 1/2 I | 190 - 75 - 12 1/2 |
| 7 - 3 - 1/20 I | 180 - 80 - 11 1/2 1/2 |
| 9 - 6 1/2, 1/20 I | 240 - 120 - 140 - 14 1/2 |
| 8 1/2 - 6 1/2, 1/20 I | 220 - 115 - 135 - 13 1/2 |

Butts of *Scardinius* shorter, to have 2 ^{6 1/2} straps
3^{4 1/2} rind. of 7, butts of plate. plate keel 2 ^{1/2} straps
3 ^{4 1/2} rind throughout. ~~Straps and short plate~~
4 side plates of 3 ^{6 1/2} rind overtop. Not of shell plate
4 ^{6 1/2} rind. over. throughout. (our breadth). All rind
double as marked. 2 rind to through landing edge
and frame, where plates are joggled.

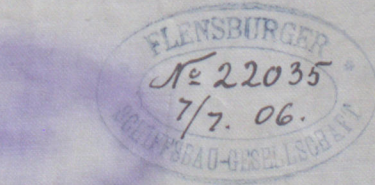

Yours verse Section Hamburg No 240
with 3 Row of Pillars
Hamburg Cellar 9. 7. 06
Report No 2555

W730-0035