


SCALE 1:96


For correct position of *Hatchways*
 " " " " *Pillaring* } see sketch attached.
 " " " " *Bulkheads*

 

NOTE: Bottom Form strengthened according to rule.

C.B.
137.06

Longitudinal & Deck plans
with 3 Rows of Pillars
Gleisburg No 270
Hamburg 9. 7. 06

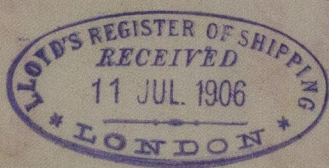

Report No 9555

RETAIN



© 2020

Lloyd's Register
Foundation

W730-0036