

# MIDSHIP SECTION

STEEL SCREW TRAWLER.


Nº 532

DIM<sup>S</sup> 110'-0" x 21'-0" E x 12'-9" M<sup>LD</sup>

SCALE  $\frac{1}{2}$ " INCH = 1 FOOT.

TO CLASS 100 A.1 FOR FISHING  
PURPOSES. DECK PLATED OVER IN  
WAY OF MACHINERY SPACE. ENGINE  
BOILER CASING AS PREVIOUSLY  
APPROVED

PLAN NO. 1306  
FOR ENCLOSURE TO  
Messrs. Lloyd's Surveyors  
Hull FROM  
COCHRANE & SONS.  
SHIPBUILDERS, SELBY  
DATE March 12, 1912. RK

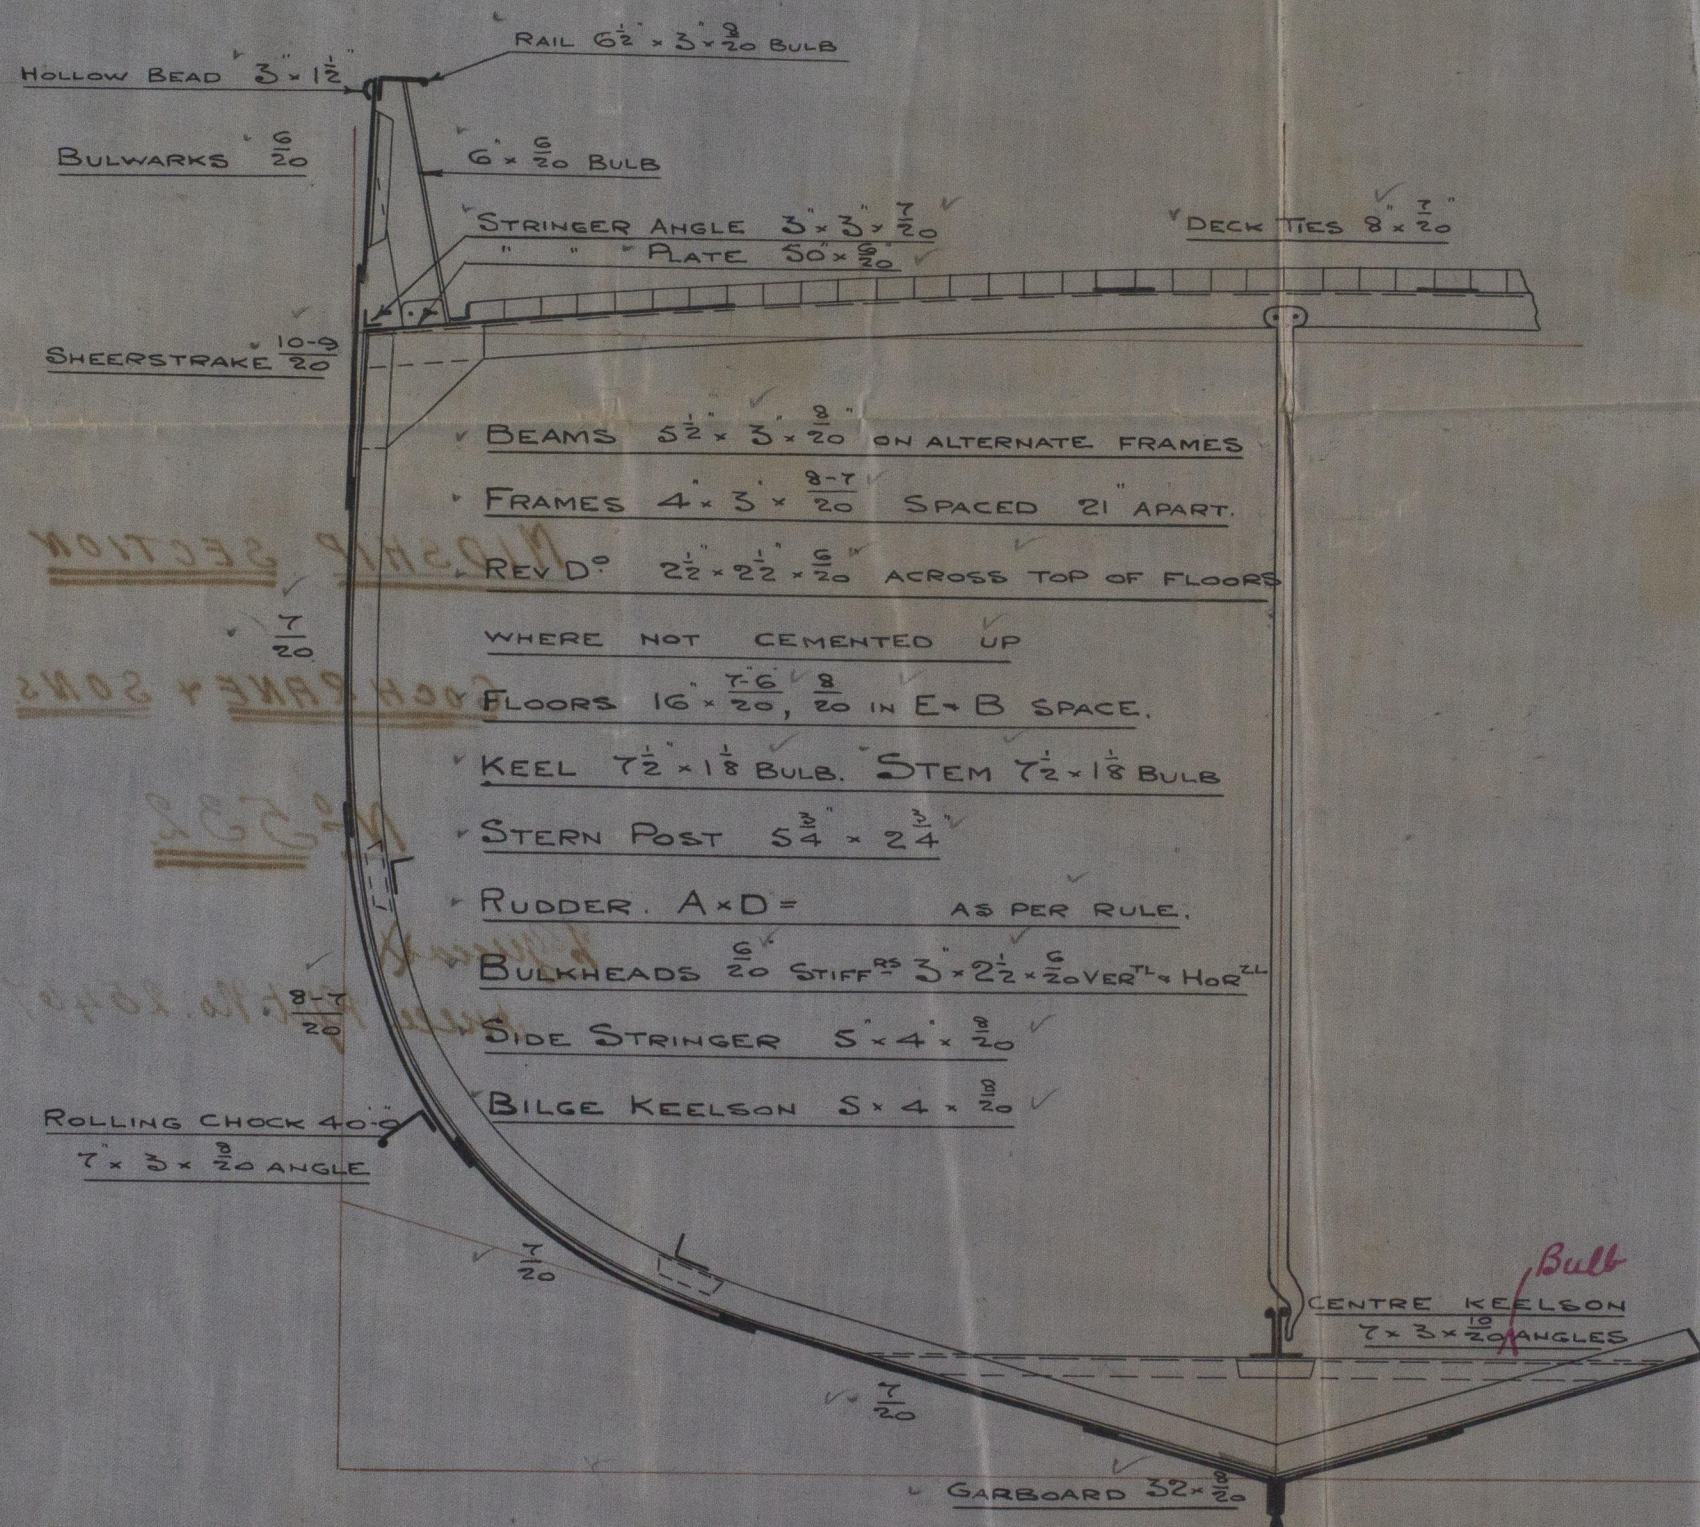

## NUMERALS.

B + D = 33.62 ✓  
L x (B + D) = 3698.20 ✓

## PROPORTIONS

$\frac{L}{D}$  = 8.62 ✓  
 $\frac{L}{B}$  = 5.27 ✓

## EQUIPMENT

1 <sup>ST</sup> BOWER ANCHOR	4 $\frac{3}{4}$ CWT. EX STOCK
2 <sup>ND</sup> " " "	4 $\frac{1}{4}$ " " "
KEDGE ANCHOR	2 $\frac{1}{2}$ " " "
30 FATHOMS	15" CABLE ✓
60 "	5 $\frac{1}{2}$ " HAWSER ✓
60 "	4" WARP ✓

## RIVETING

- BUTTS OF SHELL PLATING LAPPED
- DOUBLE RIVETED, EXCEPT GARBOARD
- SHEERSTRAKE WHICH ARE TO BE STRAPPED
- DOUBLE RIVETED, LANDING EDGES DOUBLE
- RIVETED EXCEPT TOP EDGE OF SHEERSTRAKE
- WHICH IS TO BE SINGLE RIVETED, BUTTS
- OF STRINGER & TIE PLATES TO BE LAPPED
- DOUBLE RIVETED ✓

APR 12-3-12

C.B.  
13.3.12.

W730-0043

LOYD'S REGISTER  
OF SHIPPING.  
12 MAR 1912  
HULL



© 2020


Lloyd's Register  
Foundation







 


MIDSHIP SECTION

GOCHRANE & SONS

N<sup>o</sup> 532

*H. Guccia*  
Sheet Rpt No: 25467

 

RETAIN

