

3 BOILERS 6408. $\frac{1}{2}$

SCREW STAYS 11 THREADS PER INCH

BOILERS N° 398-399.

SCALE $1'' = 1 \text{ FOOT}$

Richardsons, Westgarth & Co.

Main Boilers


N^{os} 398 + 399

for

Sir Raylton Dixon & Co.

SS N^{os} 577 + 578

180 lbs W.P.

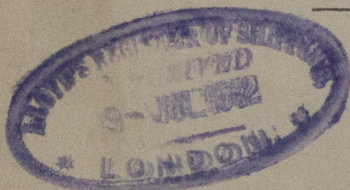

398


No. 5024
LLOYD'S TEST
360 lbs.
14.2.13, J.K.

RETAIN

Mdb. Report No. 7992.

399

No. 5044
LLOYD'S TEST
360 lbs.
31.3.13, J.K.

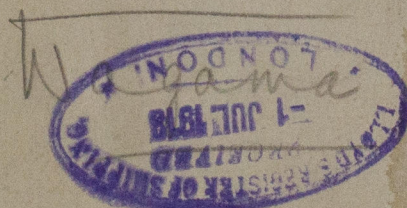

© 2020

Lloyd's Register

W7350010101ation