

27.3.05

MIDSHIP SECTION OF S.S. N° 186

S.S. YEW'S.

TO CLASS 100 A.1. AT LLOYDS AND BE BUILT UNDER SPECIAL SURVEY.


SCALE $\frac{1}{2}$ INCH = ONE FOOT.

RIVETING

KEEL, STEM AND STERNPOST, LAP BUTTS OF STRINGER PLATE, LAP BUTTS OF SHELL BEFORE AND ABAFT $\frac{1}{2}L$ AMIDSHIPS, LANDINGS TO TURN OF BILGE AND LOWER EDGE OF SHEERSTRAKE AND LAP BUTTS OF DECK PLATING FOR $\frac{1}{2}L$ AMIDSHIPS ALL TO BE DOUBLE RIVETED.
LAP BUTTS OF SHELL TREBLE RIVETED FOR $\frac{1}{2}L$ AMIDSHIPS.
LAP BUTTS OF DECK PLATING SINGLE RIVETED AT ENDS.

VESSEL TO BE BUILT OF STEEL TO IRON SCANTLINGS.


LENGTH AS PER RULE 141.48
BREADTH 23.20 = 6.1 B IN L.
DEPTH 11.66 = 12.13 D IN L.
RAISED QUARTER DECK 76.0" LONG x 3.9" ABOVE MAIN DECK
BRIDGE 4.0" x 6.9" " " "
TOP GALLANT FORECASTLE 24.6" x 6.0" " " "
23.0

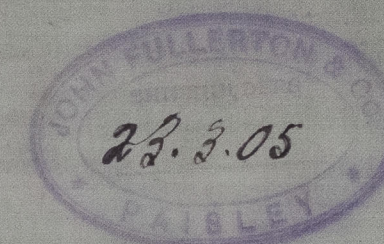


VESSEL TO HAVE 6 HOLD PILLARS 4" DIA.

NUMERALS

$\frac{1}{2}B$ = 11.60
 $\frac{1}{2}G$ = 21.20
D = 11.66
44.46 - 1st NUMBER
141.48
6290.20 - 2nd NUMBER.

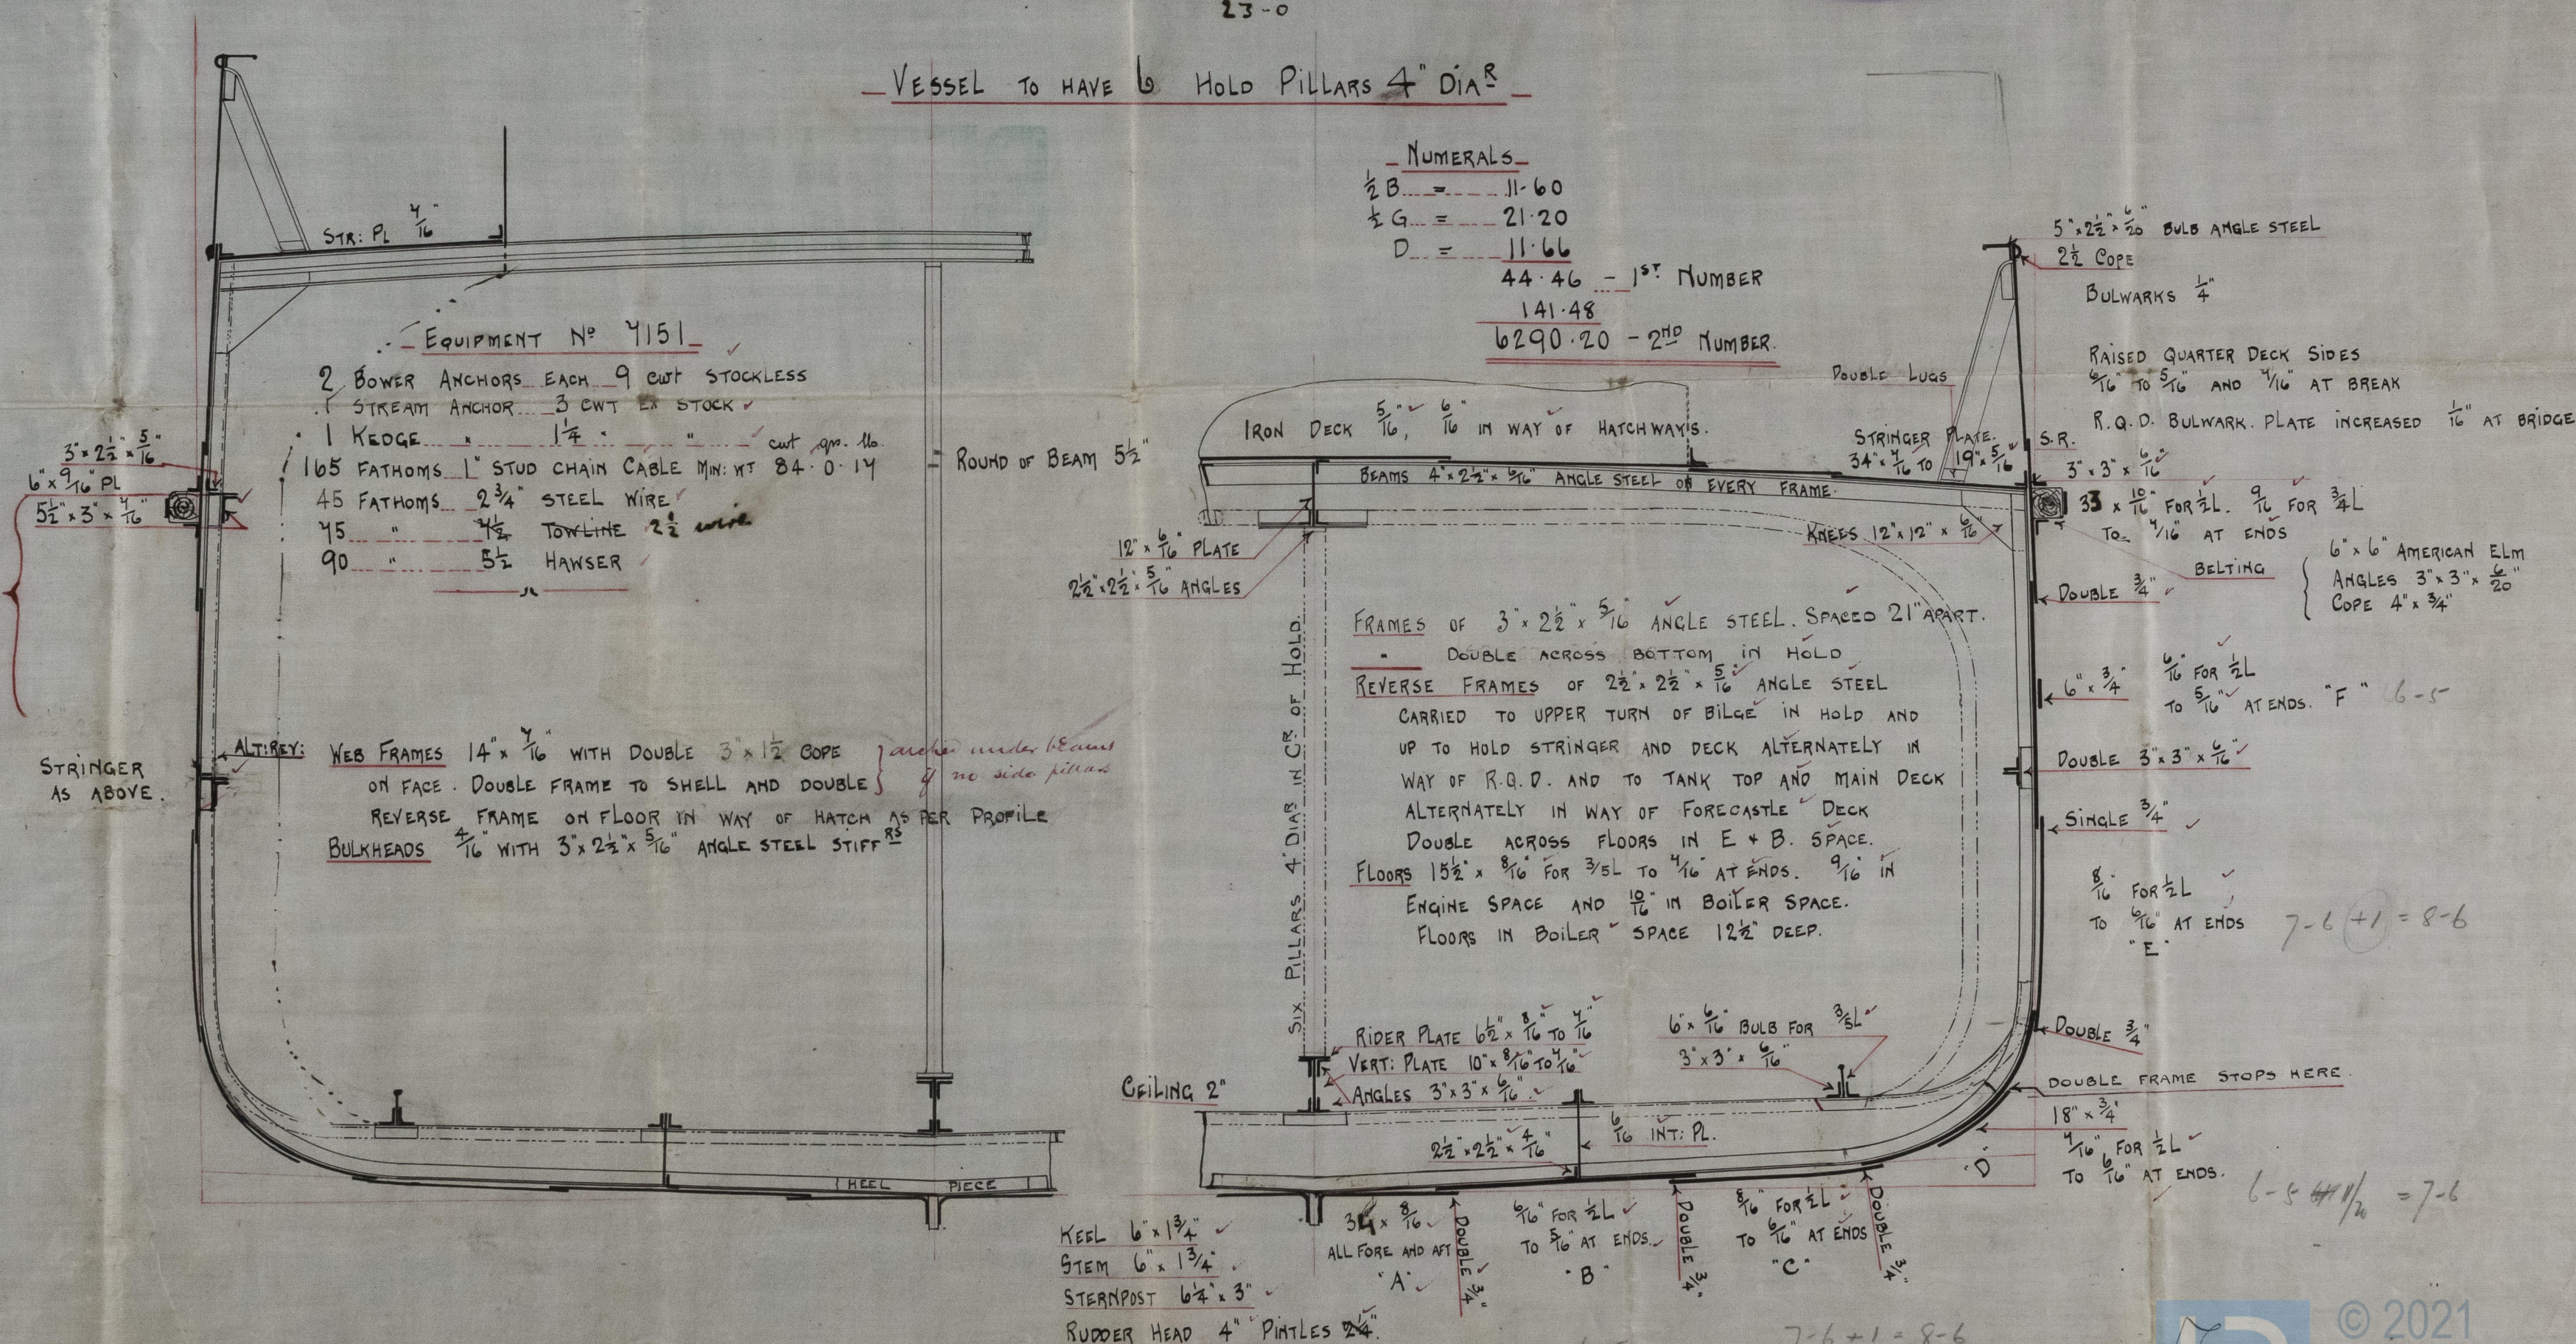

Midship Section
 Messrs J. Fullerton & Co
 No 186
 S.S. Yews
 Reg. No. 23365

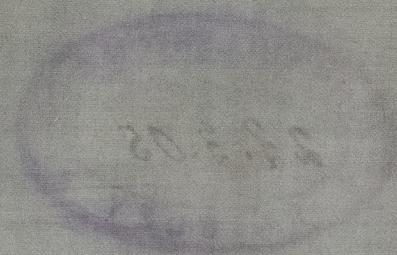

MIDSHIP SECTION OF S.S. YEW








W731-0014

