


SCALE  $\frac{1}{2}$  = ONE FOOT



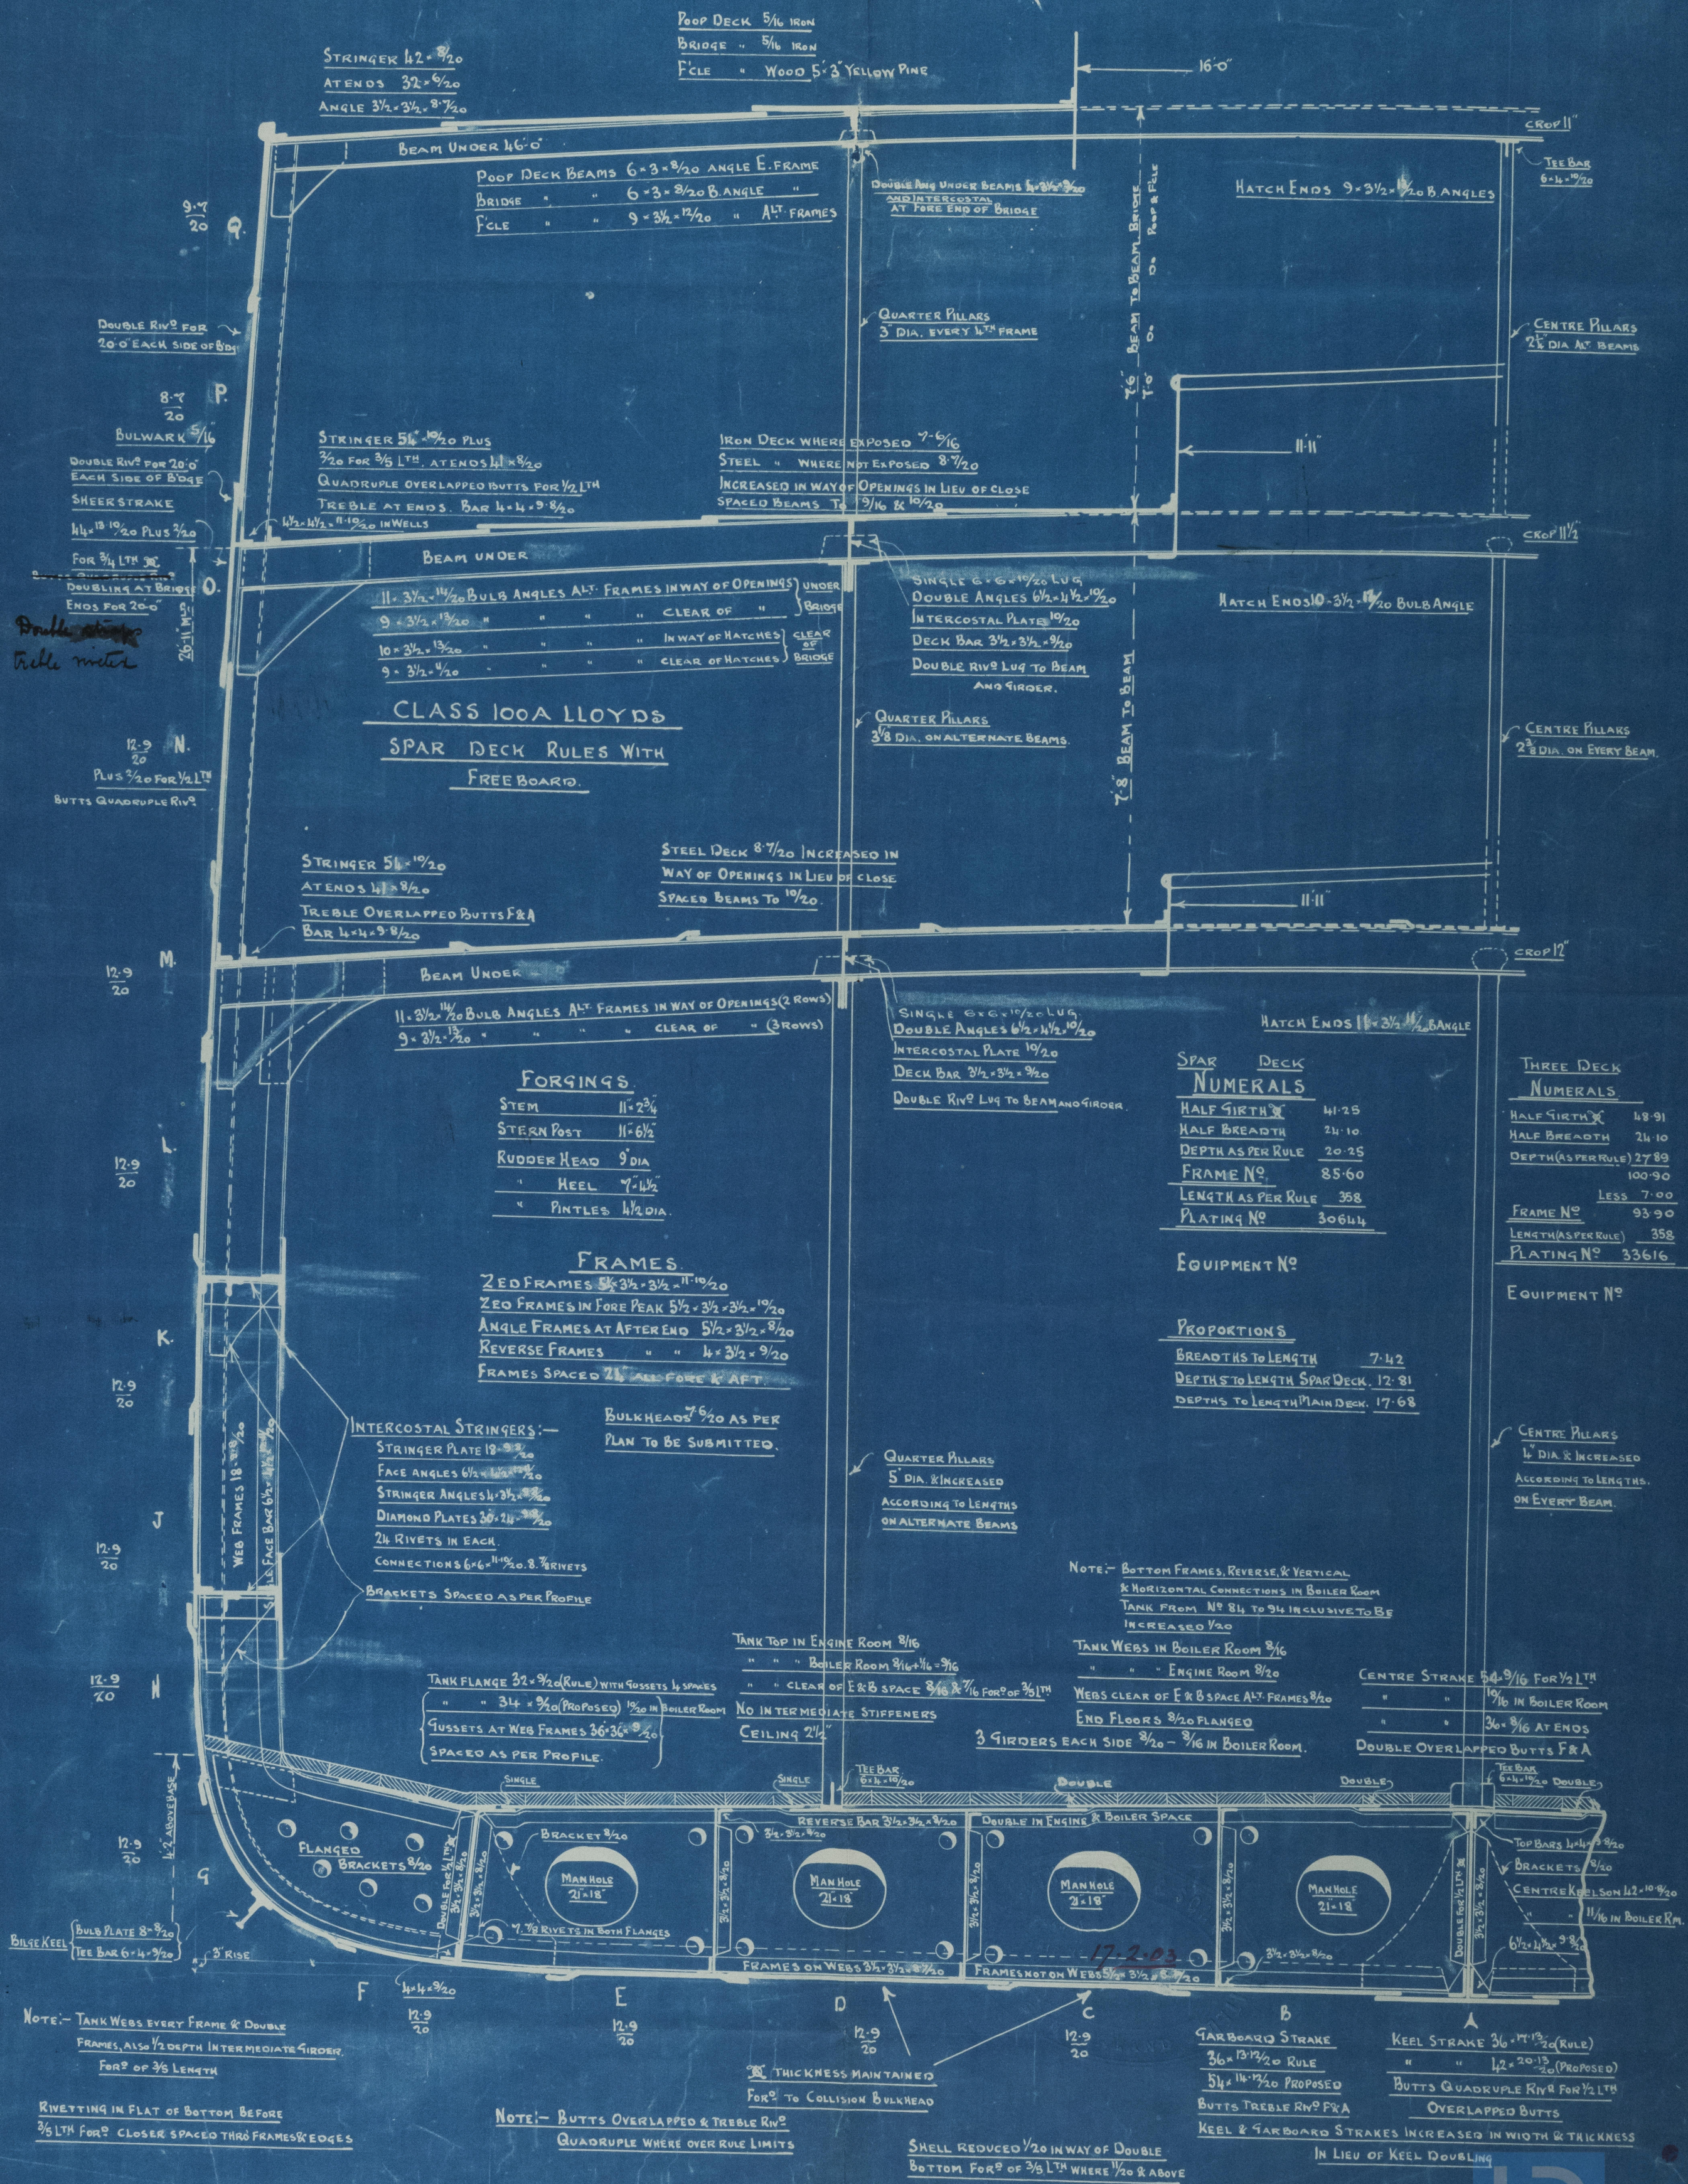

Messrs J. & T. Thompson & Sons  
Midship Section (as built)

S.S. No 405

"ZONE"

*Sunderland.*



RETAIN



© 2021

Lloyd's Register  
Foundation

W731-0045