

13.9.10

# MIDSHIP SECTION

STEEL SCREW TRAWLER

N<sup>o</sup>. 477


DIM<sup>s</sup>. - LENGTH 119'-0" x 22'-0" x 12'-3" DEPTH MLD.

SCALE 1/2" = 1 FOOT.

TO CLASS 100 A.1. FOR FISHING PURPOSES. DECK PLATED  
OVER IN WAY OF MACHINERY. E. & B. CASING AS PREVIOUSLY APPROVED.

PLAN No 9605  
FOR ENCLOSURE TO  
Messrs Lloyds Surveyors  
Hull  
FROM  
COCKPINE & SONS,  
SHIPBUILDERS, 6  
DATE 9/9/10 RR

*Handwritten notes in red ink:*  
1. 1/2" x 3/4" x 1/2"  
2. 1/2" x 3/4" x 1/2"  
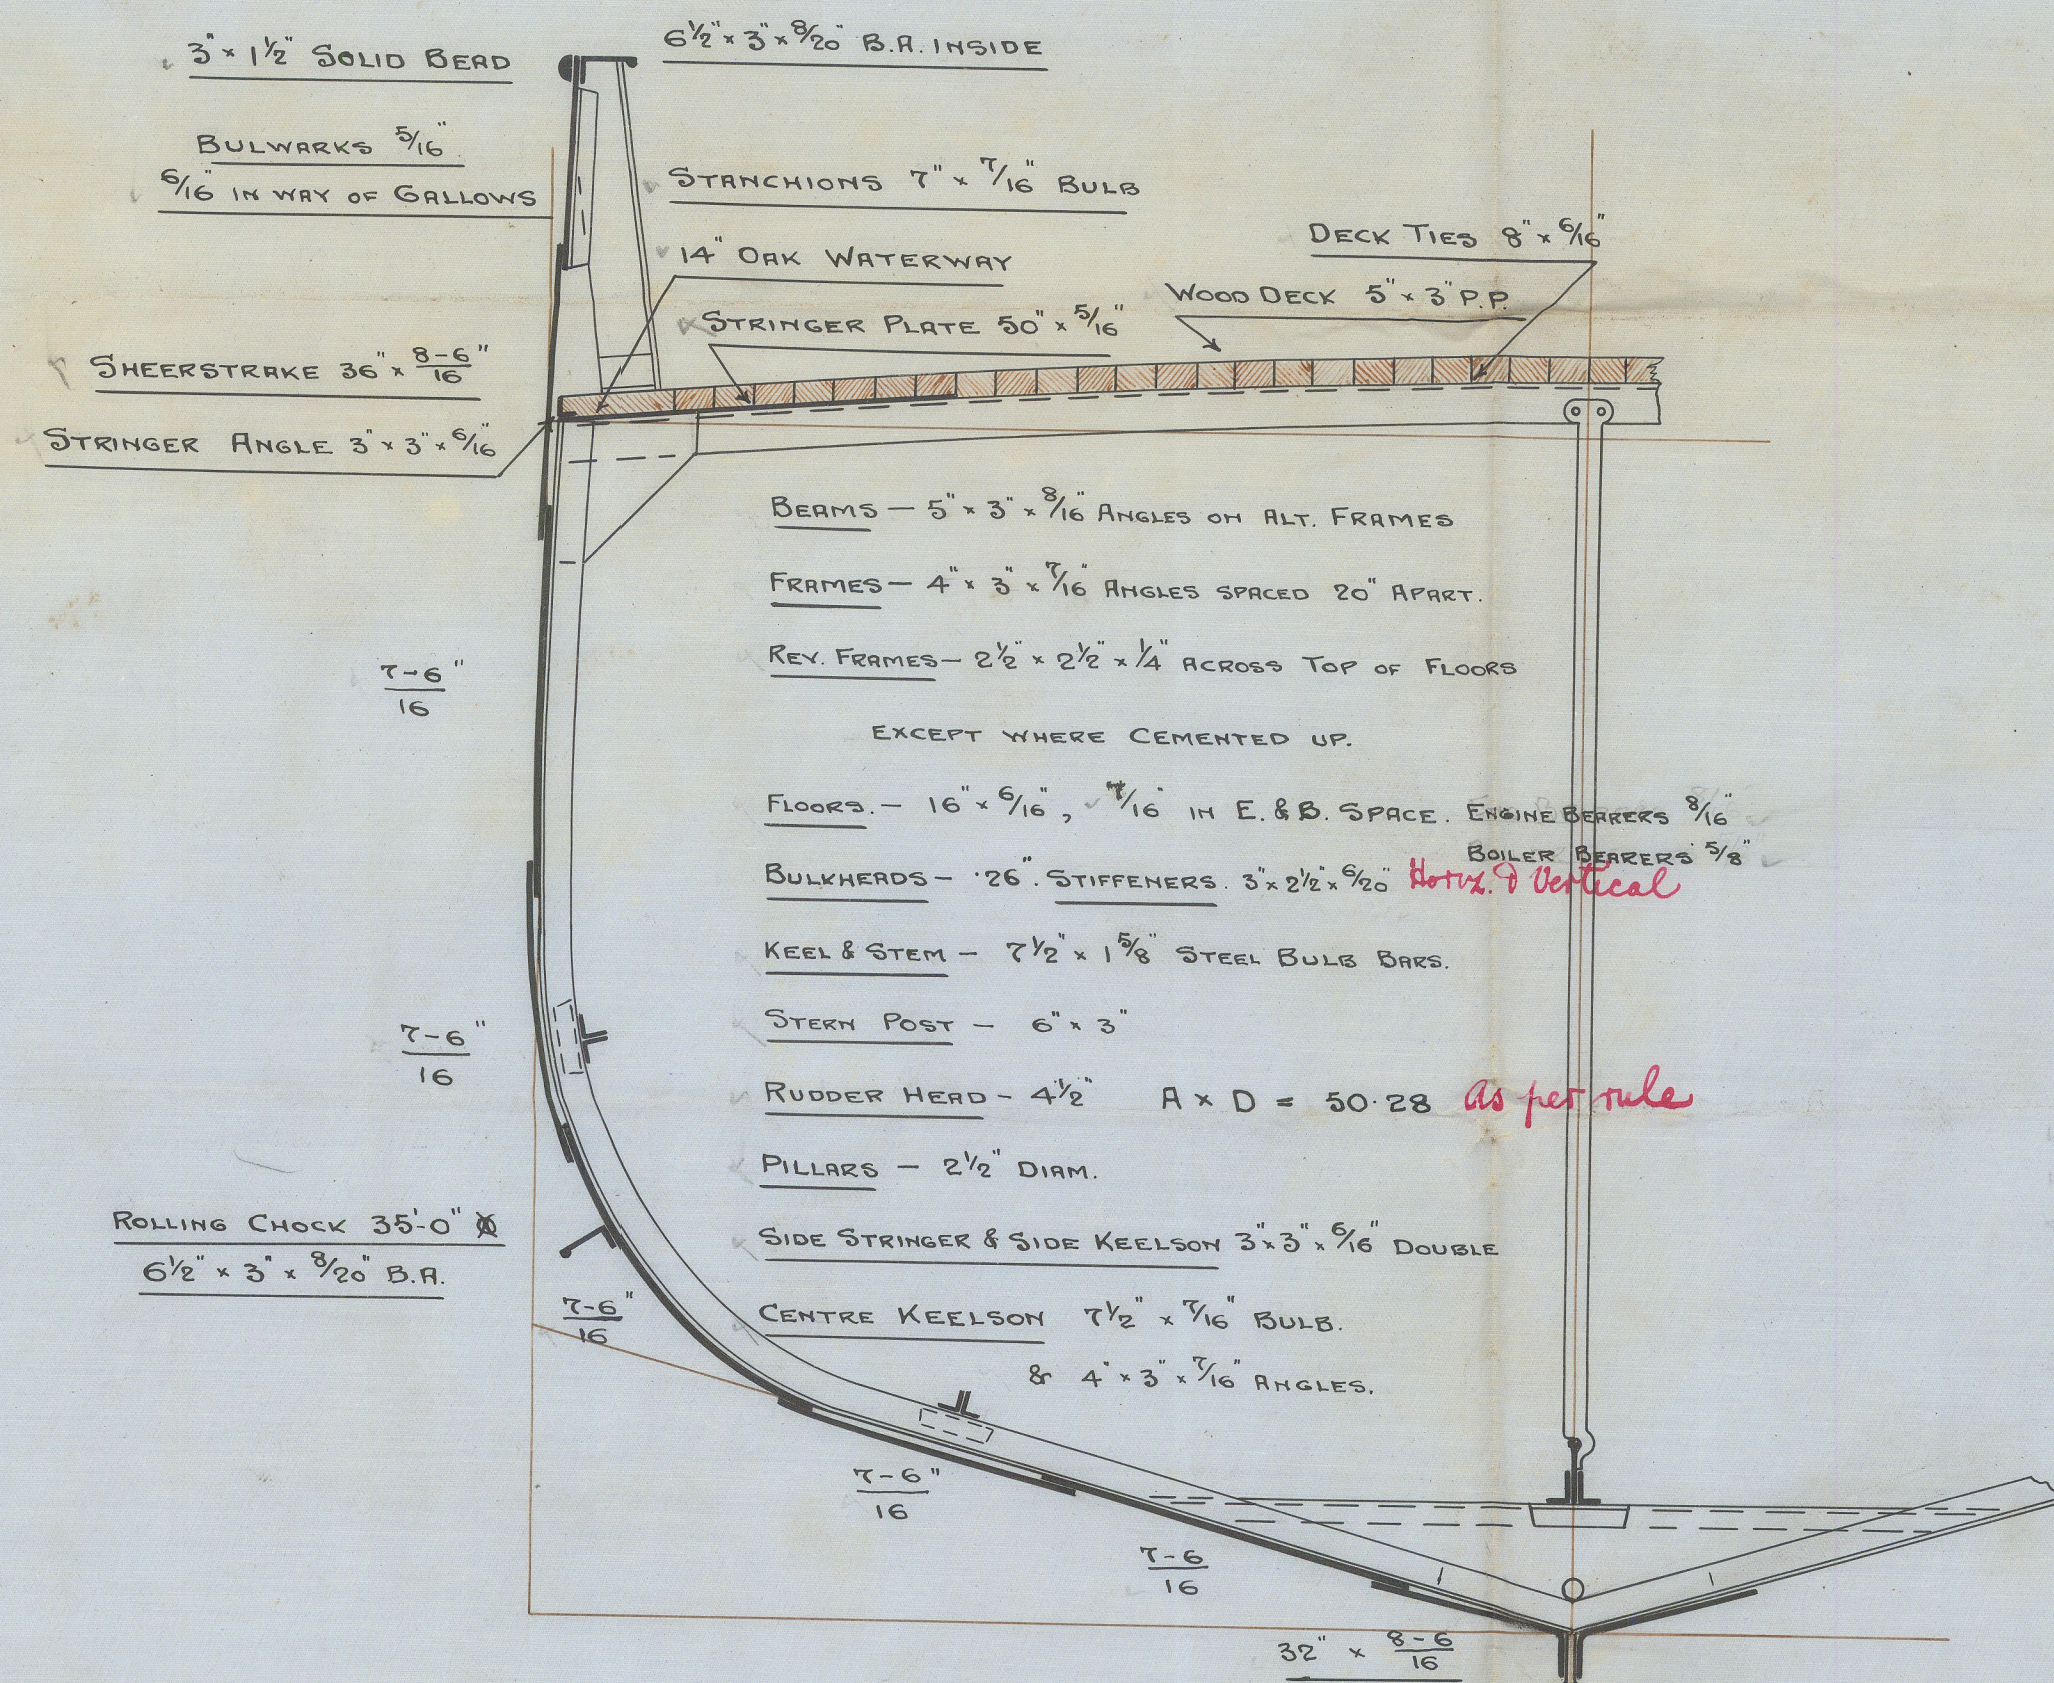

## EQUIPMENT

1ST. BOWER ANCHOR	5 1/4 CWTs EX STOCK
2ND " "	4 3/4 " " "
KEDGE	2 1/2 " " "
90 FATHOMS	1" STUD LINK CABLE.
60 " "	6" HAWSER
60 " "	4 1/2" WARP.

## NUMERALS

B + D	=	34.15
L x (B + D)	=	4063.85

## PROPORTIONS

D/L	=	9.71
B/L	=	5.43

## RIVETING

BUTTS OF GARBOARD & SHEERSTRAKE STRAPPED & DOUBLE RIVETED. REMAINDER OF SHELL OVERLAPPED & DOUBLE RIVETED. BULWARKS SINGLE RIVETED. LANDINGS DOUBLE RIVETED, EXCEPT TOP EDGE OF SHEERSTRAKE, WHICH IS TO BE SINGLE.

C.J.  
13.9.10.

LLOYD'S REGISTER  
OF SHIPPING.  
10 SEP 1910  
+ HULL +



