
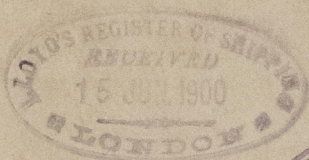


MESS^{RS} BARTRAM & SONS

N^o 181 = SS Tambesi

MIDSHIP SECTION

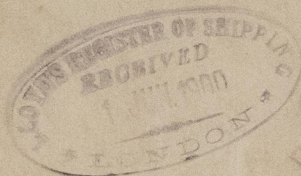

Sec Letter - 7-6-00 &
15-6-00

Sunderland. N^o 20415

