



No. 736-7.

Partial Bulkheads & Reverse Frames in Tween Decks in way of C. & B. Space
& Heavy Beams in Boiler Space.

Scale $\frac{1}{8}" = 1 \text{ Foot}$.



Section showing Partial Bulkheads in Tween Decks
on frames 65-73-83-84-92-95-99.

Scale $\frac{1}{2}" = 1 \text{ Foot}$.

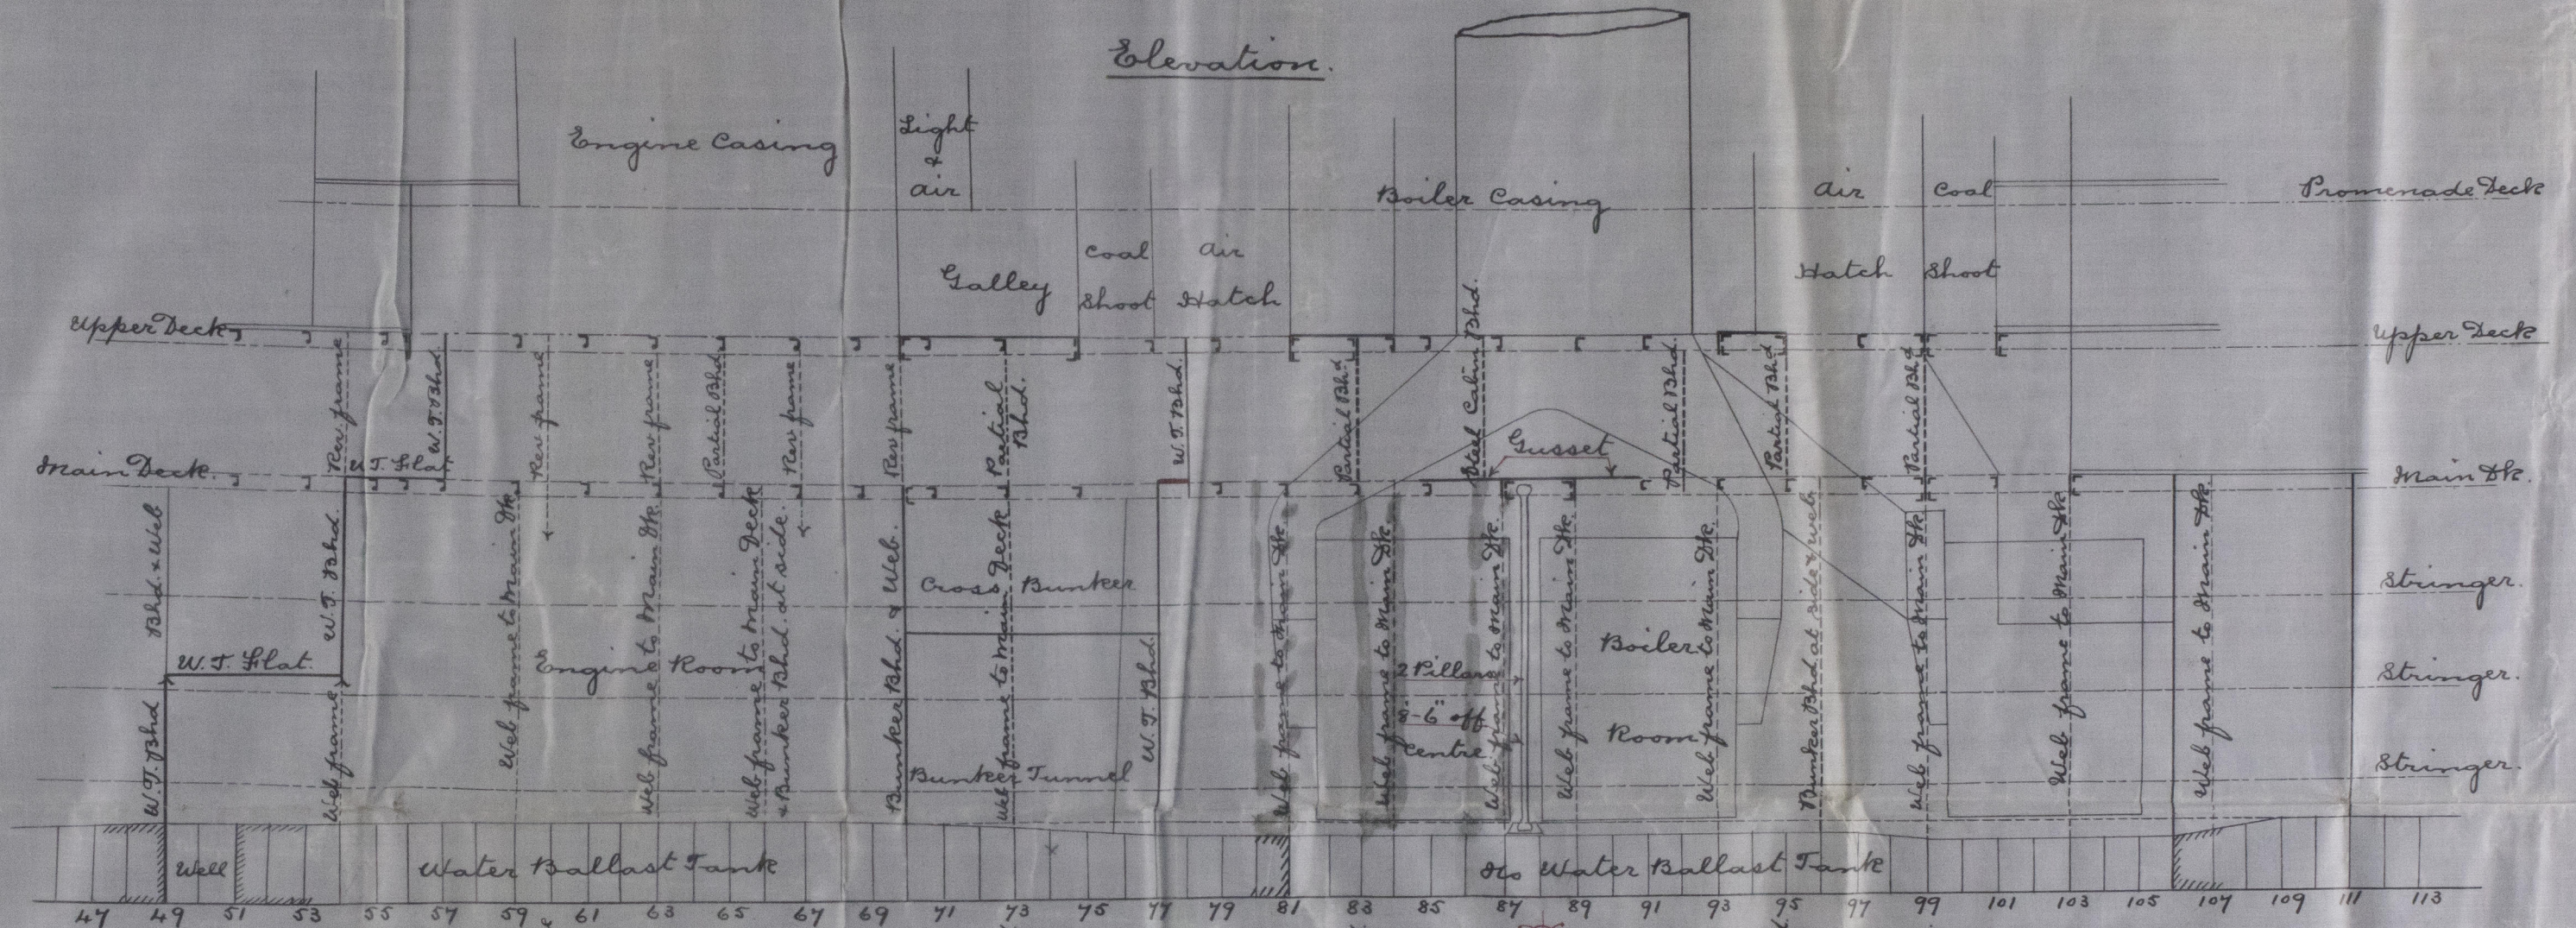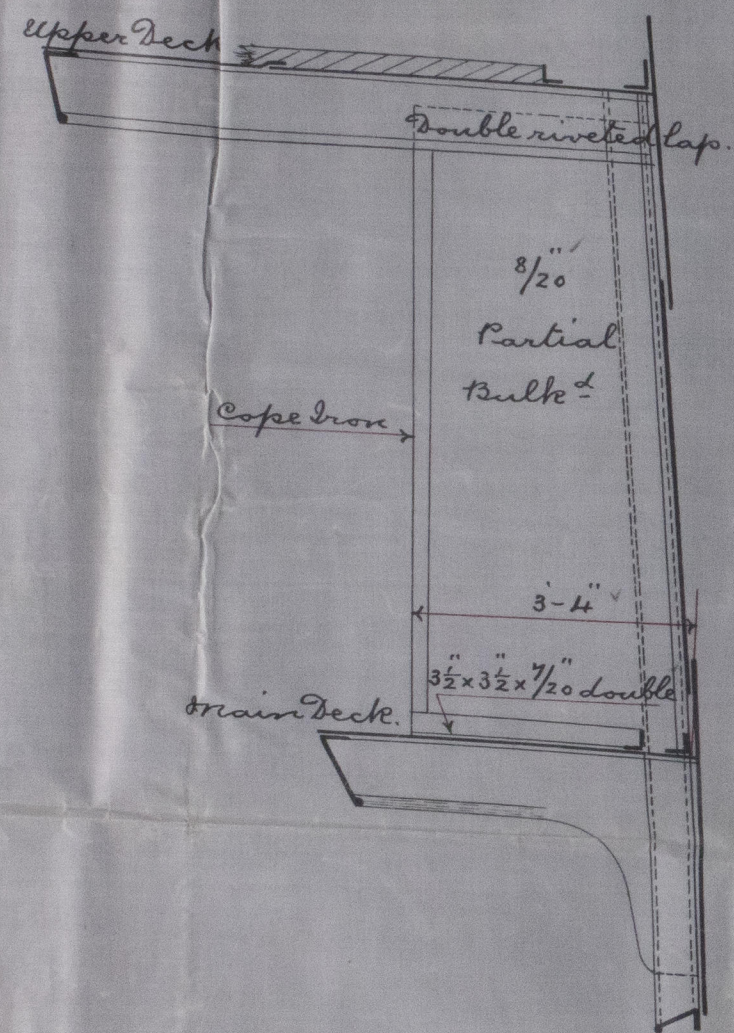

Section showing Reverse Frames in Tween Decks
on frames 54-60-63-67-70.

Scale $\frac{1}{2}" = 1 \text{ Foot}$.

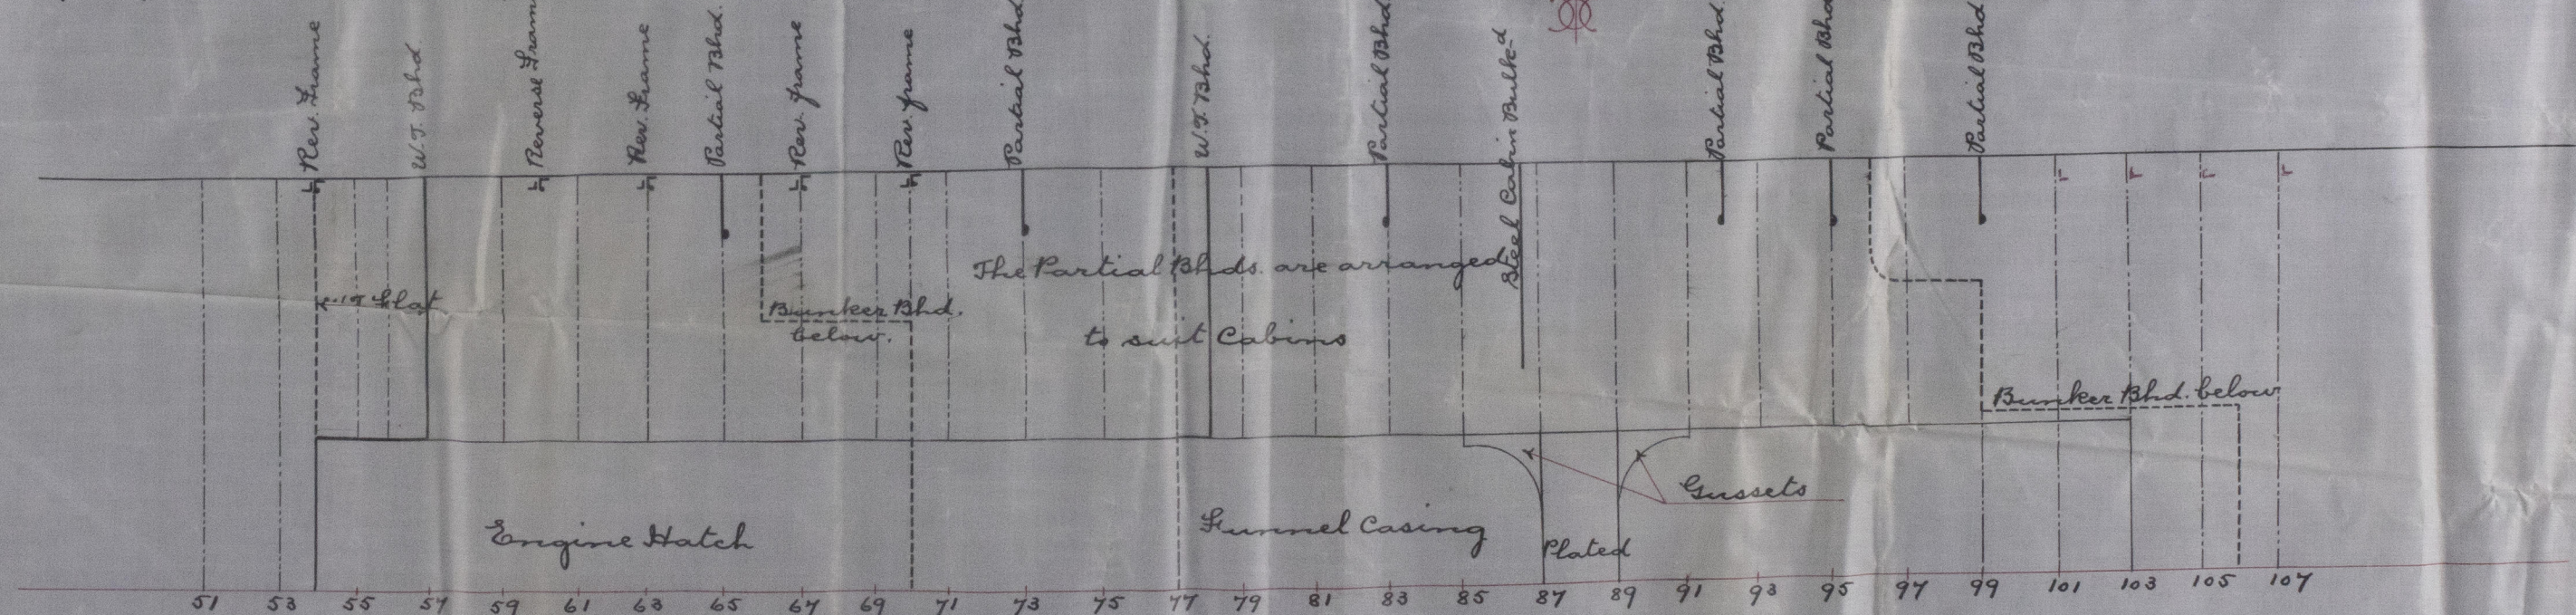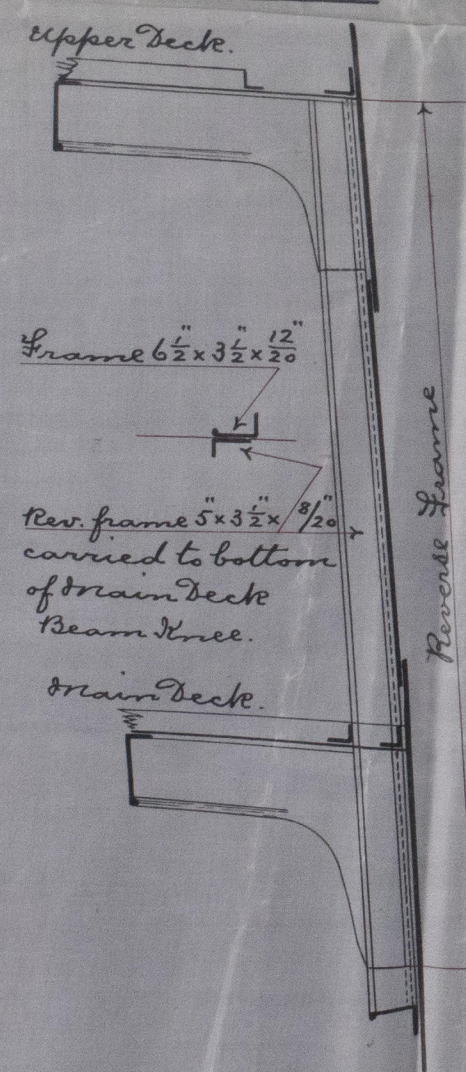

Plan on Main Deck.

C.B.
23.8.02

Sir W. B. ARNSTRONG, WHITWORTH & CO. LONDON.
NEWCASTLE-UPON-TYNE.
No. 2798 DATE 19/8/02
WALKER SHIPYARD.

Lloyd's Register
Foundation

Partial Bulkheads &
heavy beams in E. & B.
space - Armstrong W's
nos 736-7

W732-0010



© 2020

Lloyd's Register
Foundation



