



16.9.02

Section thro' Boat & Promenade Decks

Scale $\frac{1}{2}'' = 1'$ Foot

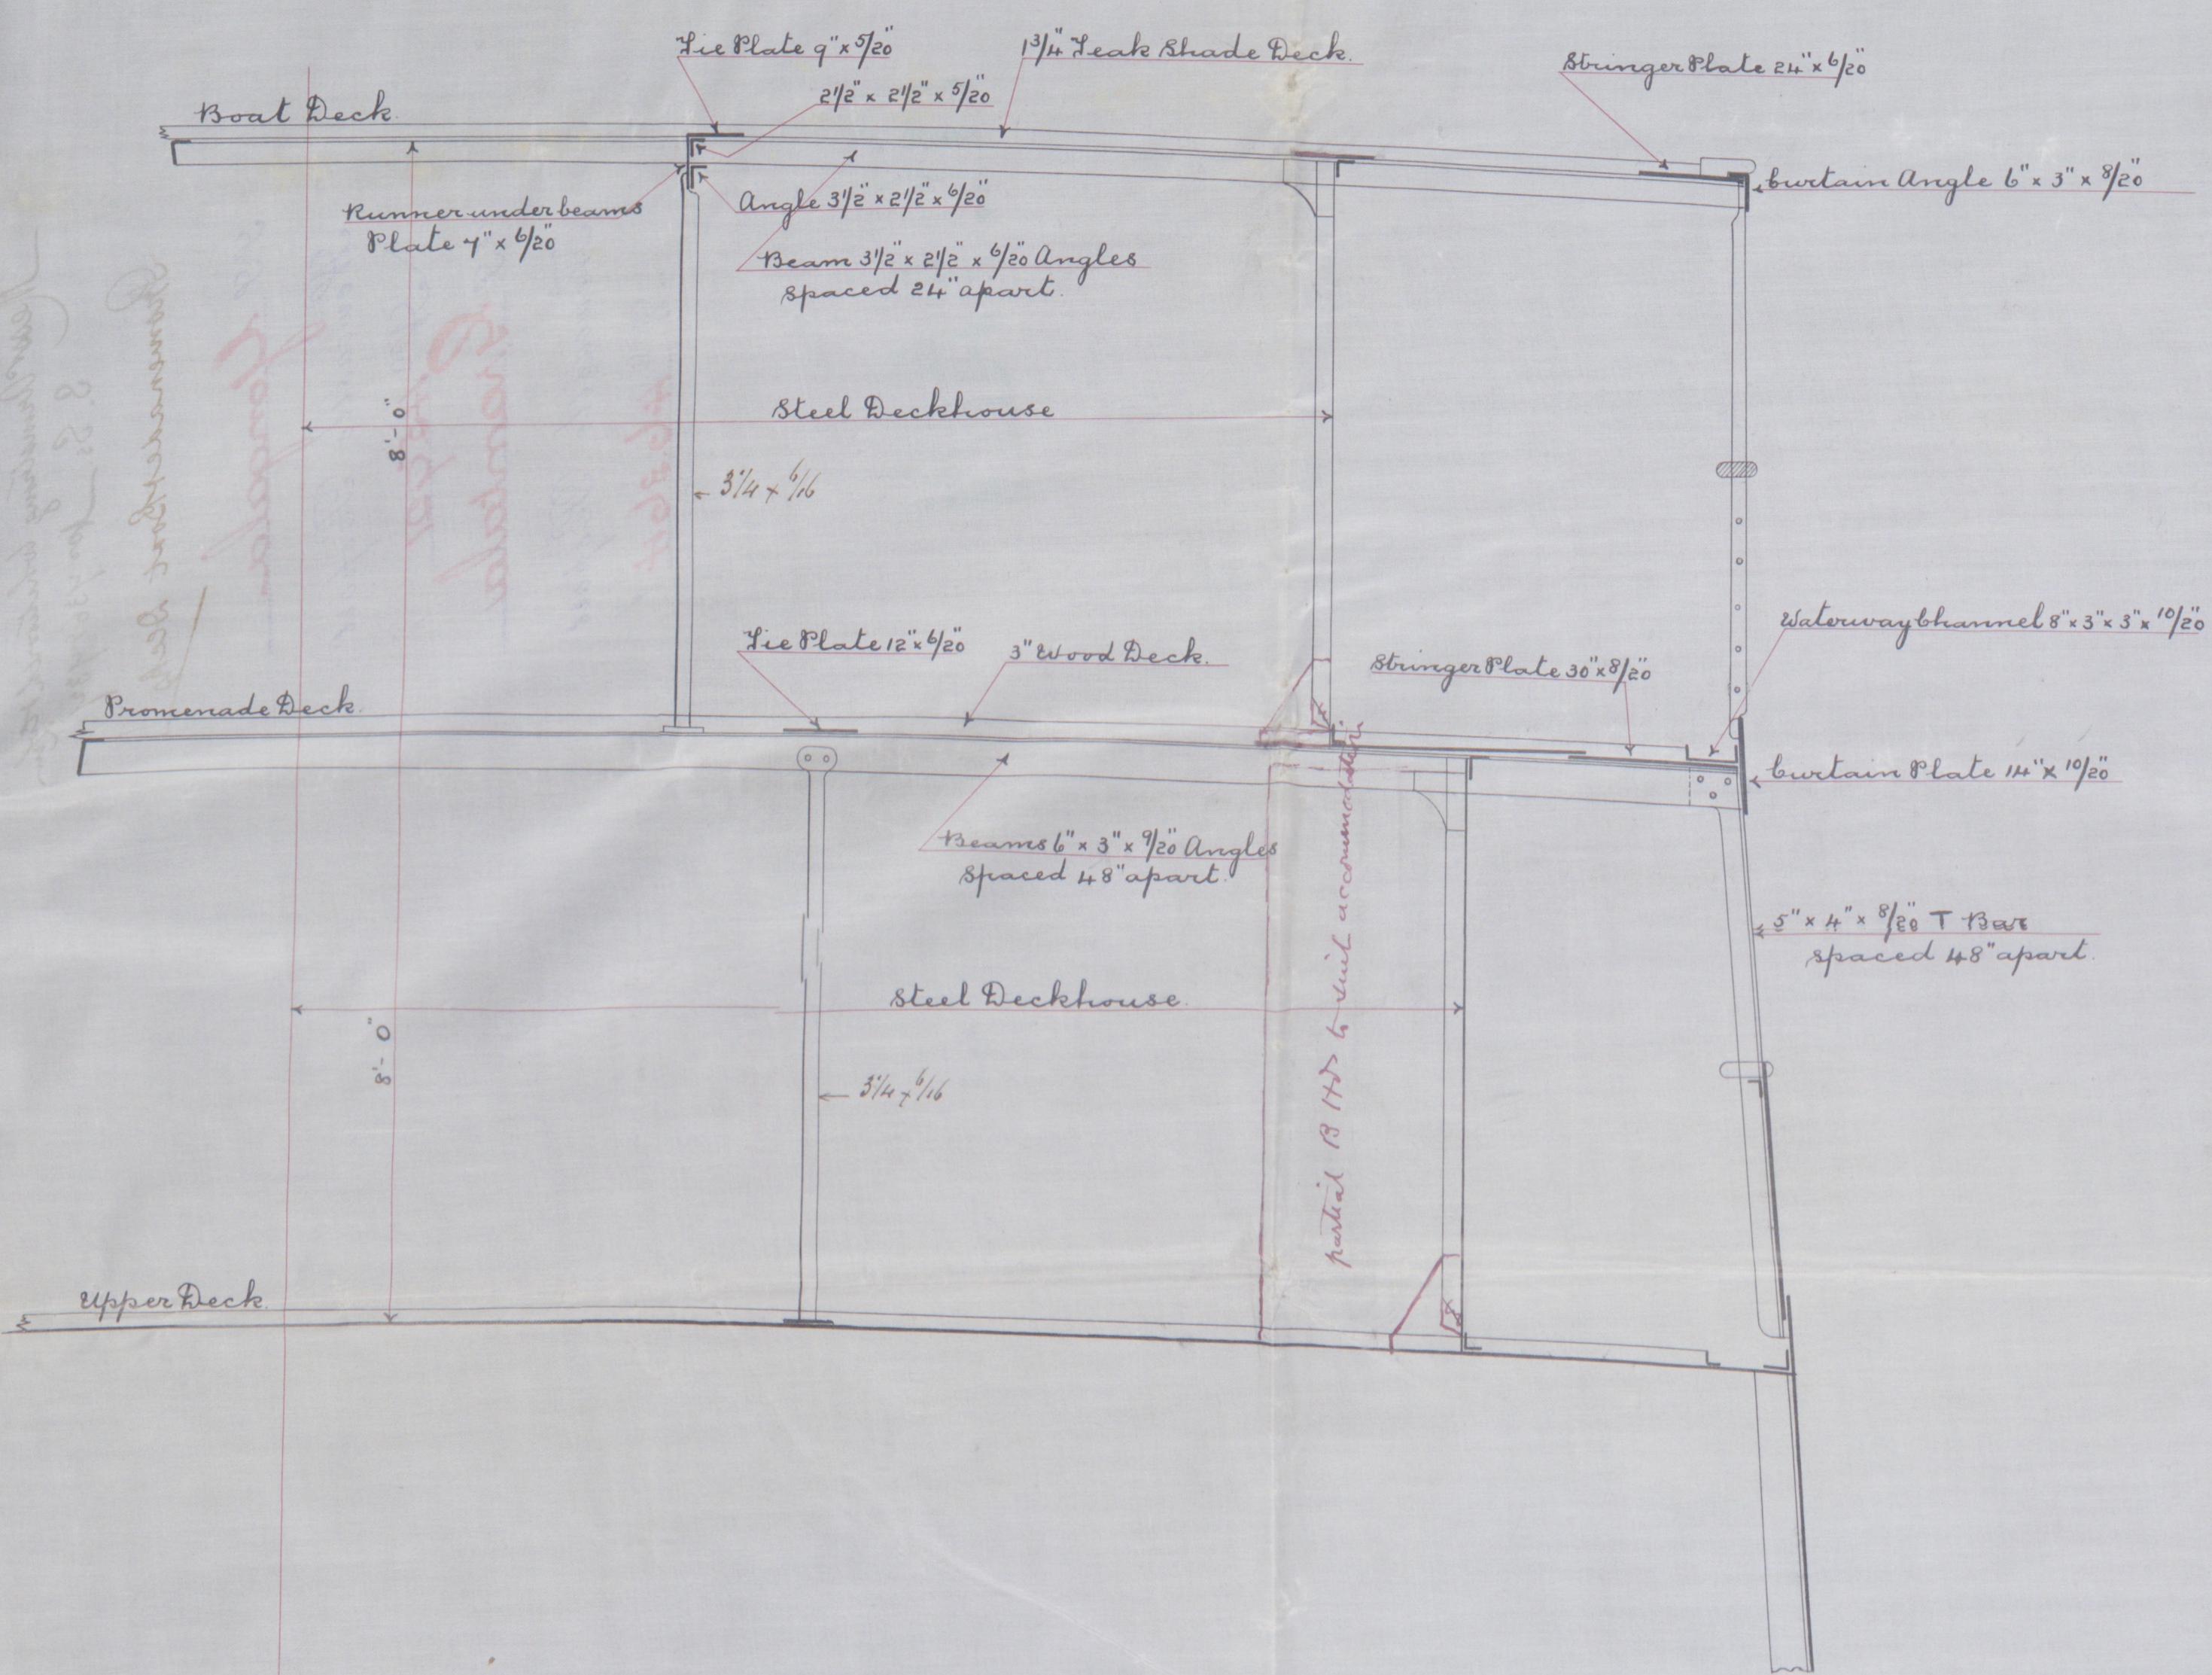


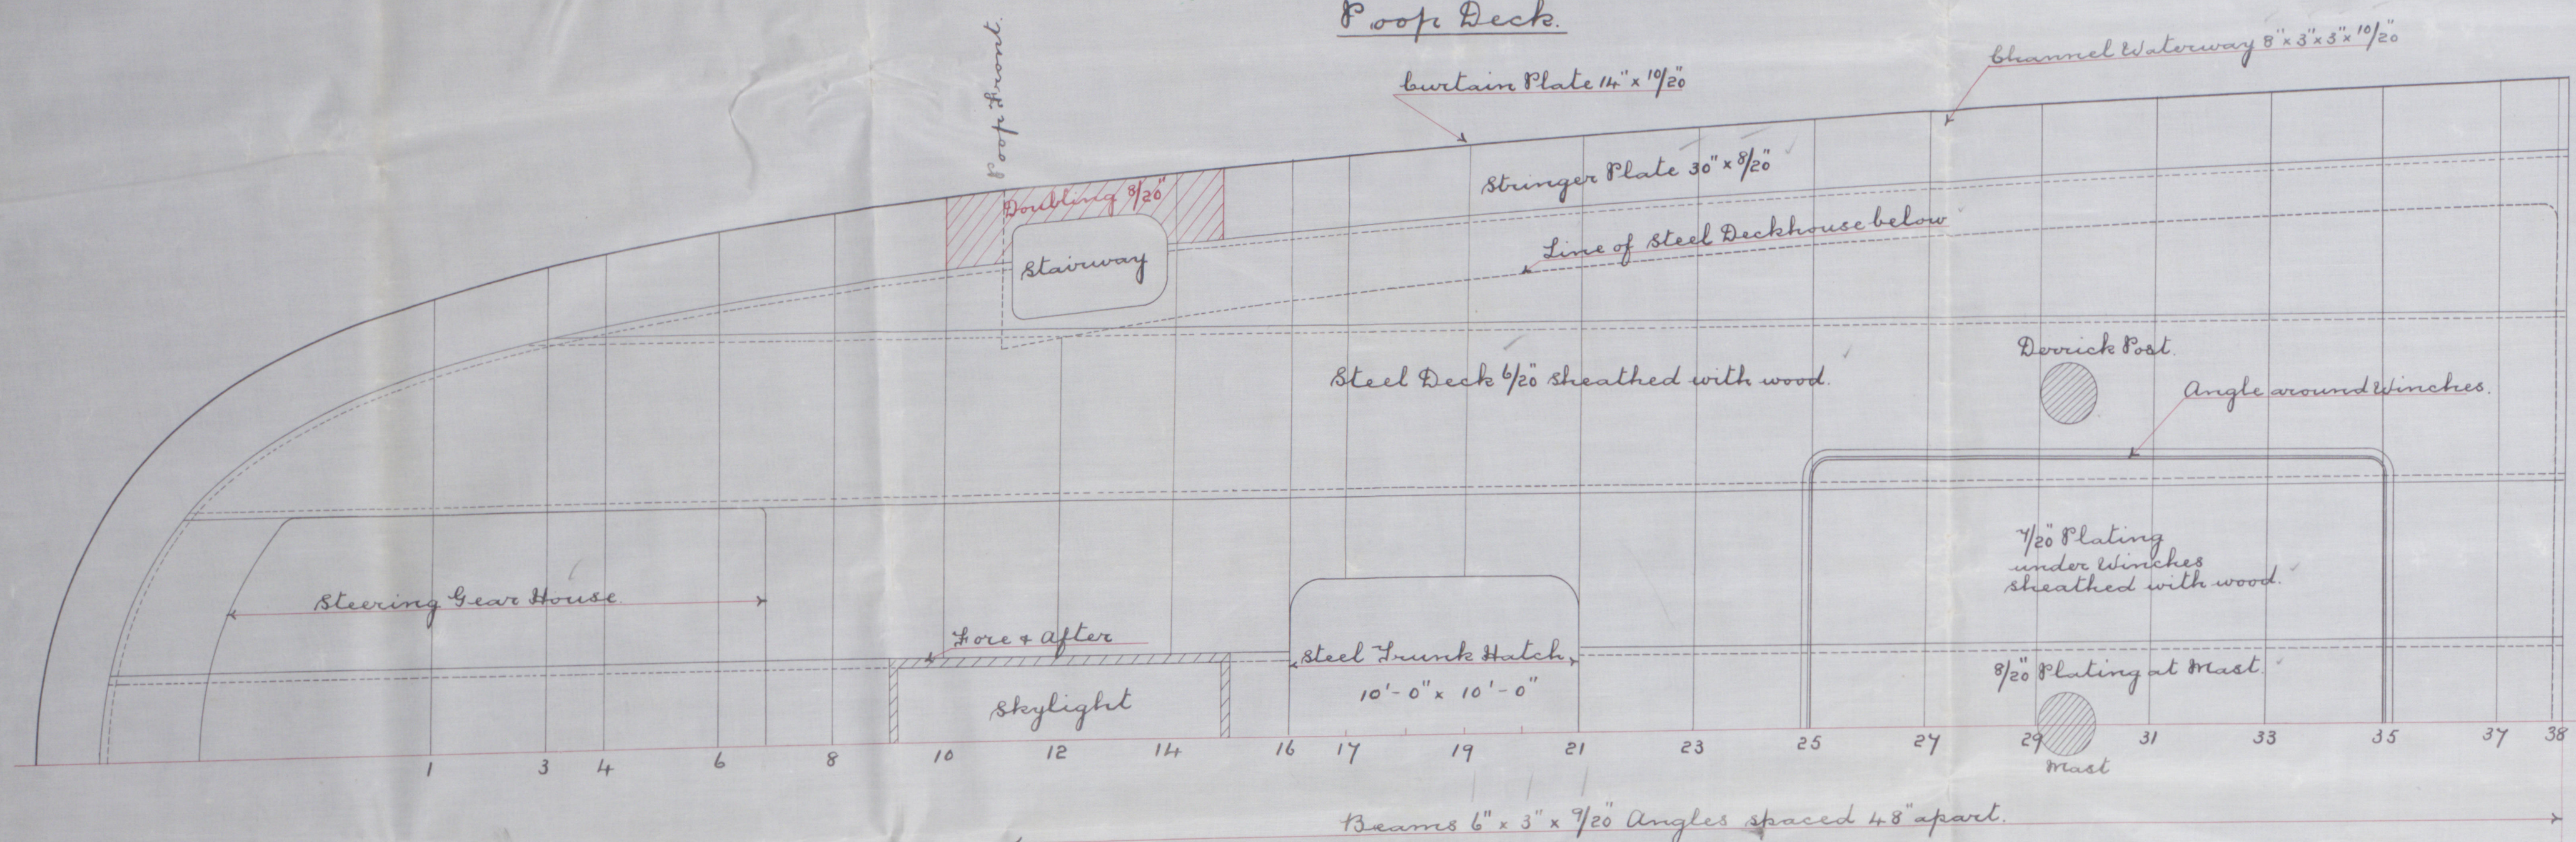


No. 736 - 7 Ships



Promenade & Boat Deck Plans &c.

Scale $\frac{1}{4}'' = 1'$ Foot


Boat Deck

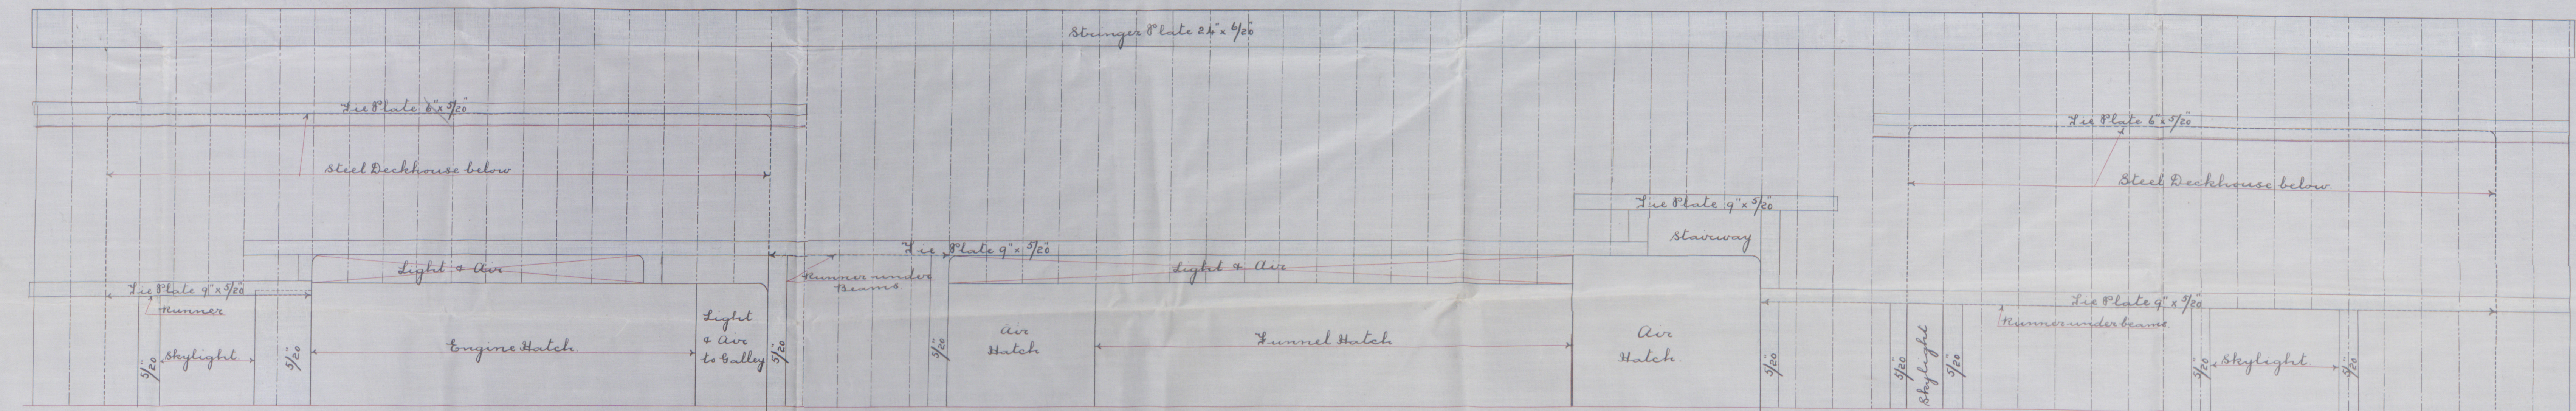

Promenade Deck

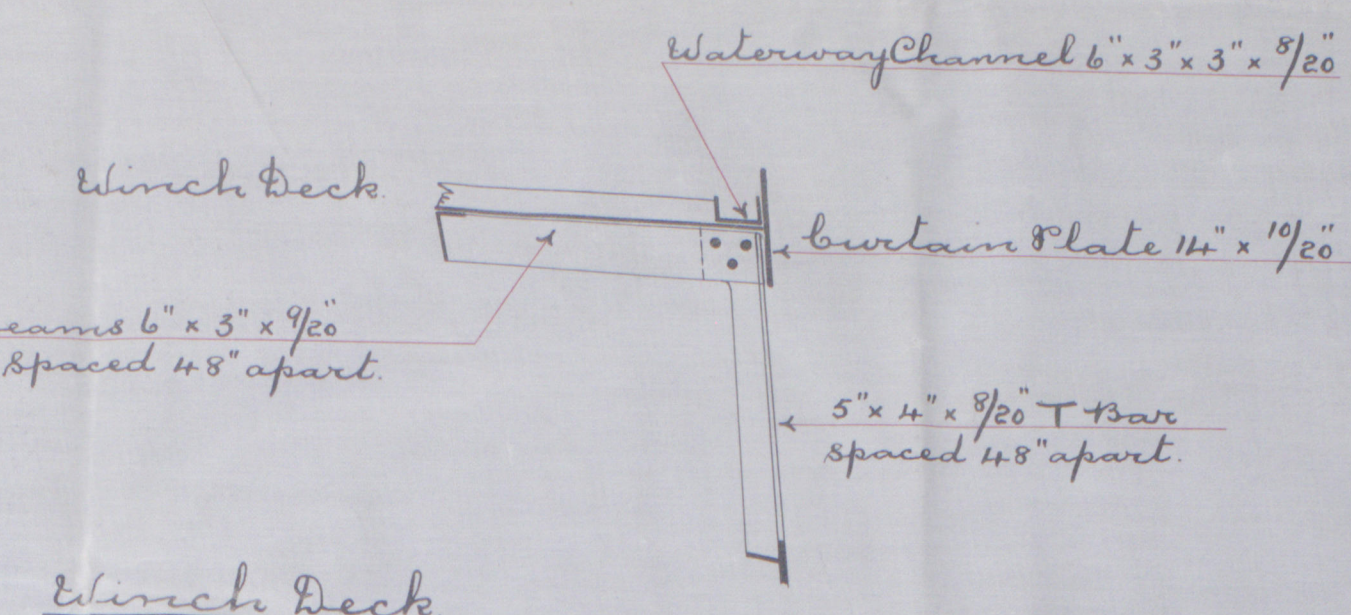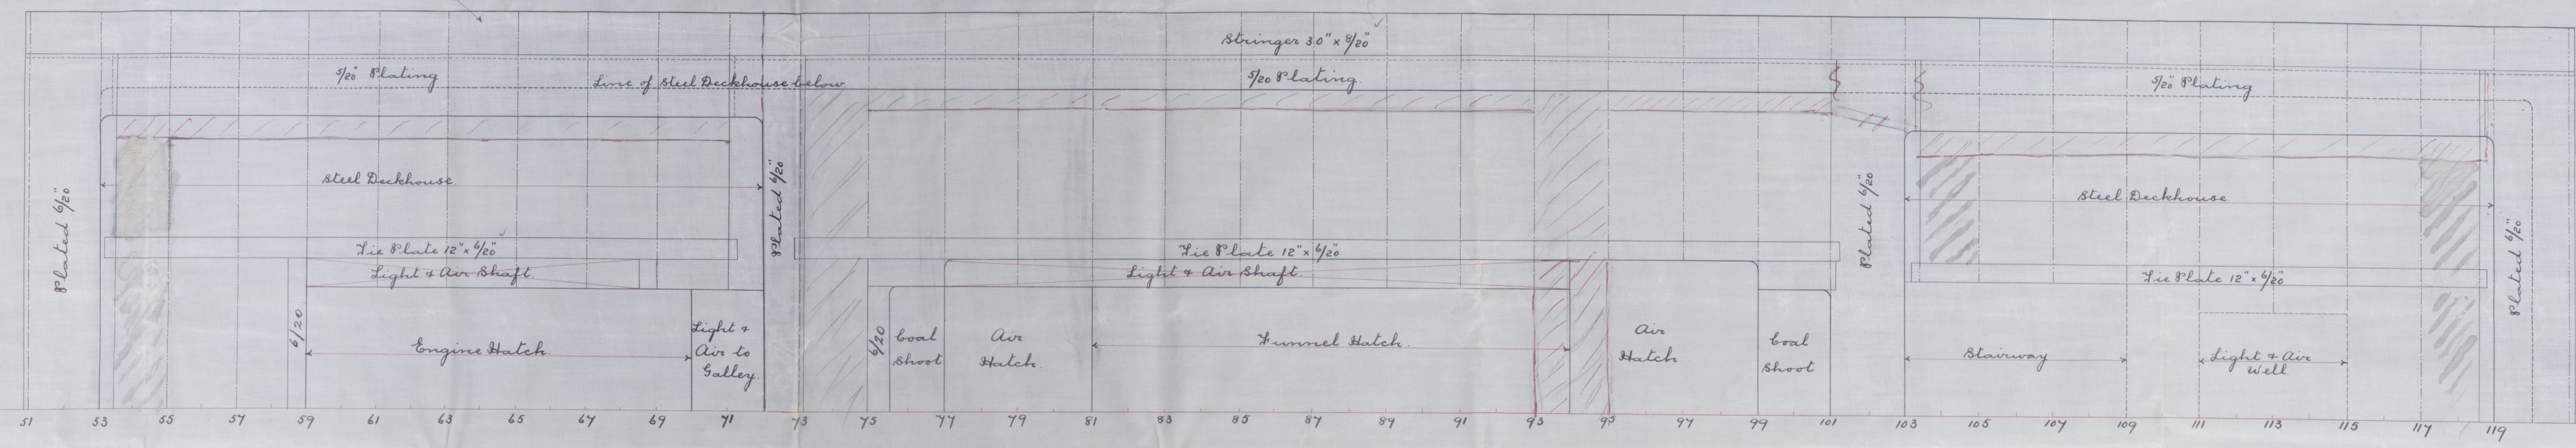

Winch Deck

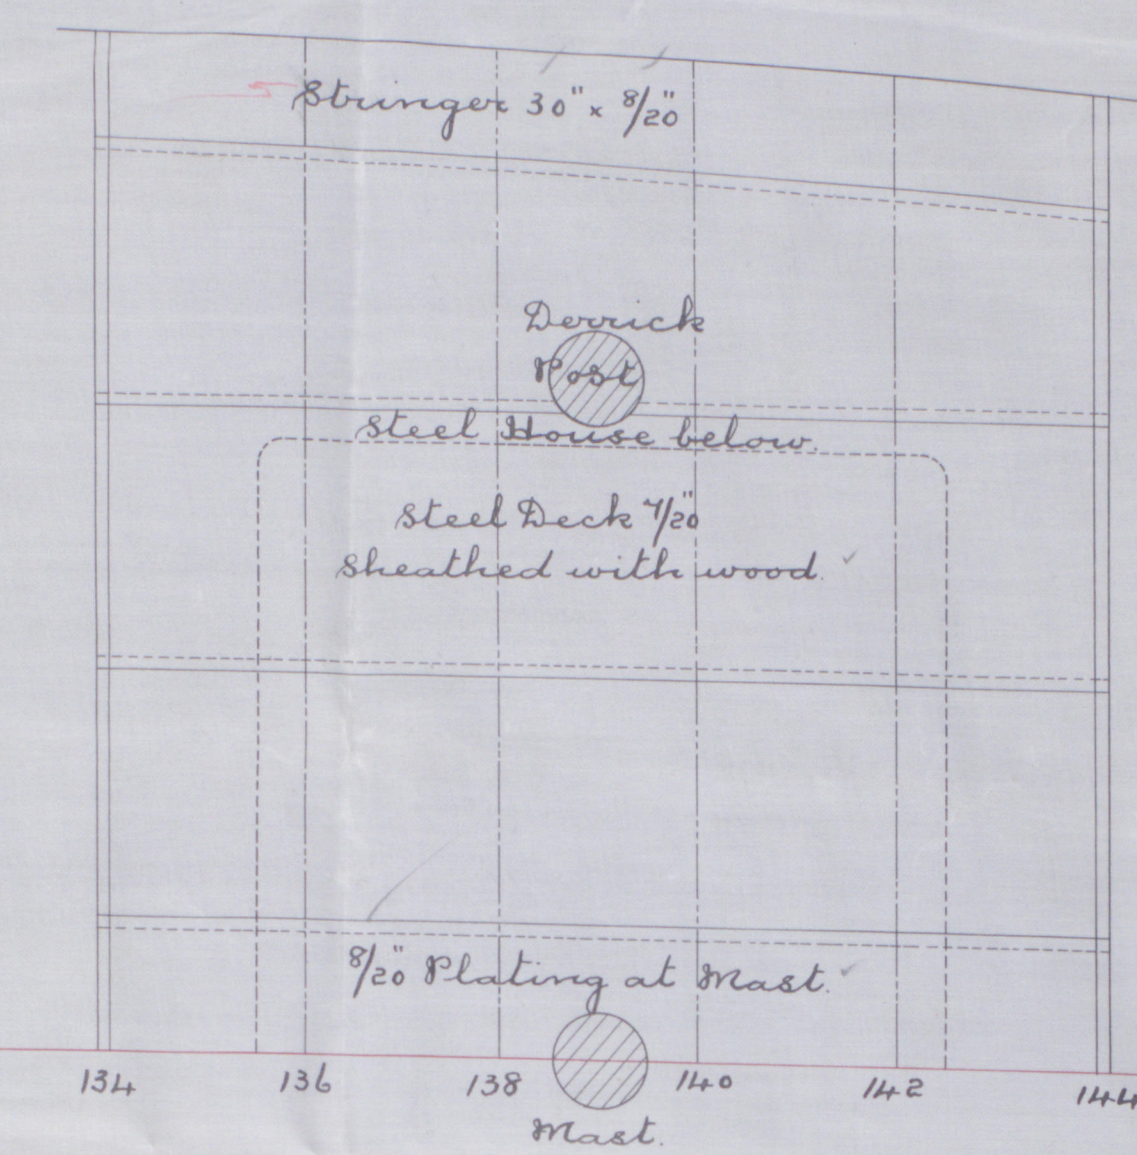


Invc. 45921

N^o 434. S.S. Grantala

7
LOFNS REGISTER OF SHIPPING
RECEIVED
13 JAN. 1904
* LONDON *

[illegible]

[Faint handwritten notes visible through the paper]