










PROFILE AND DECK PLANS

N^o 568 BLACKBURN.

DIMENSIONS 265'-0" B.P. x 35'-10" x 18'-8" M.L.D.


SCALE 1/8" = 1 FT.

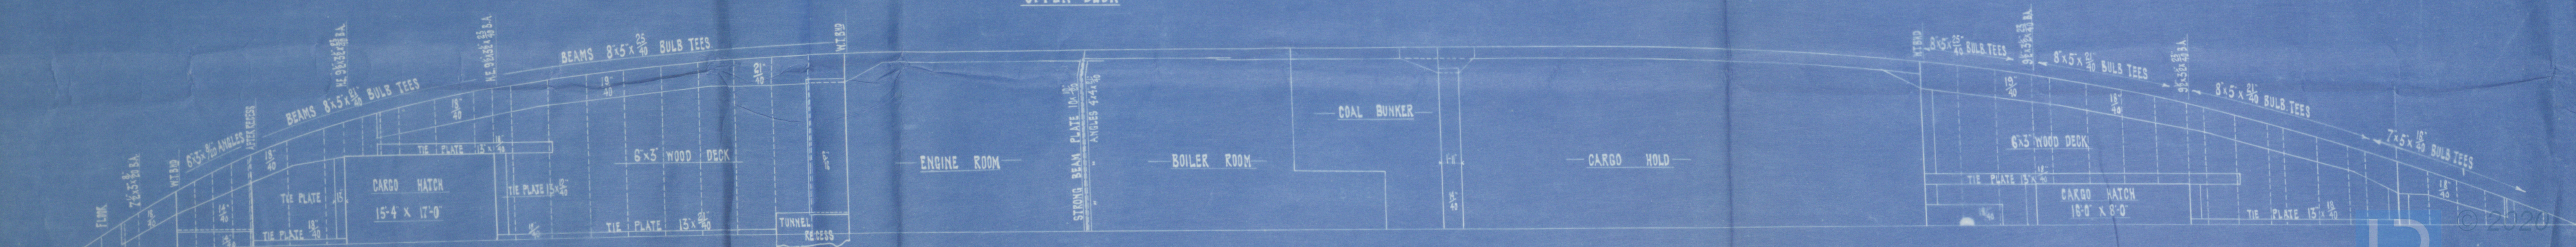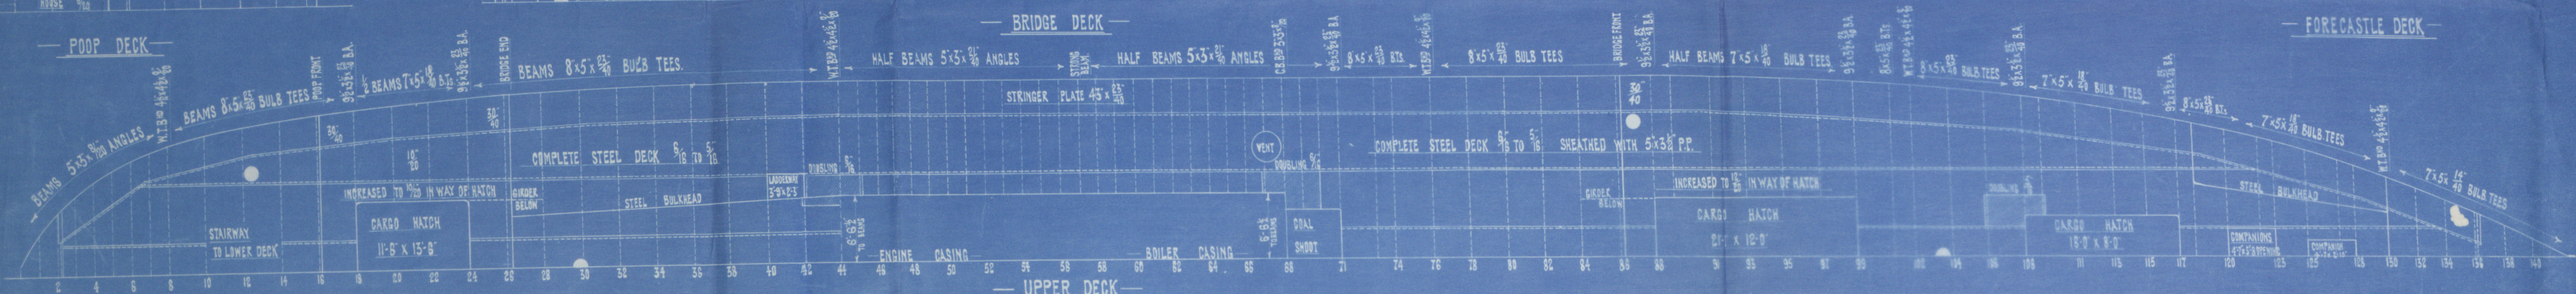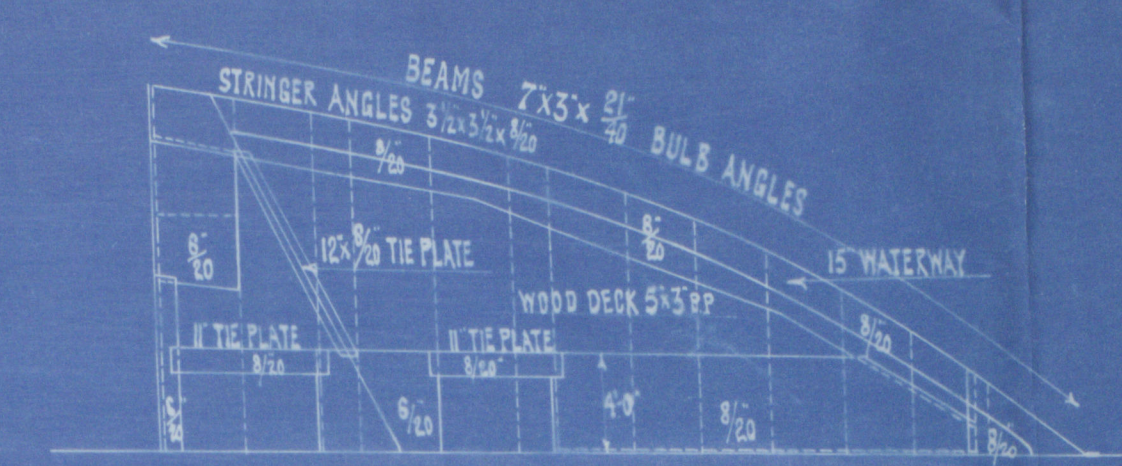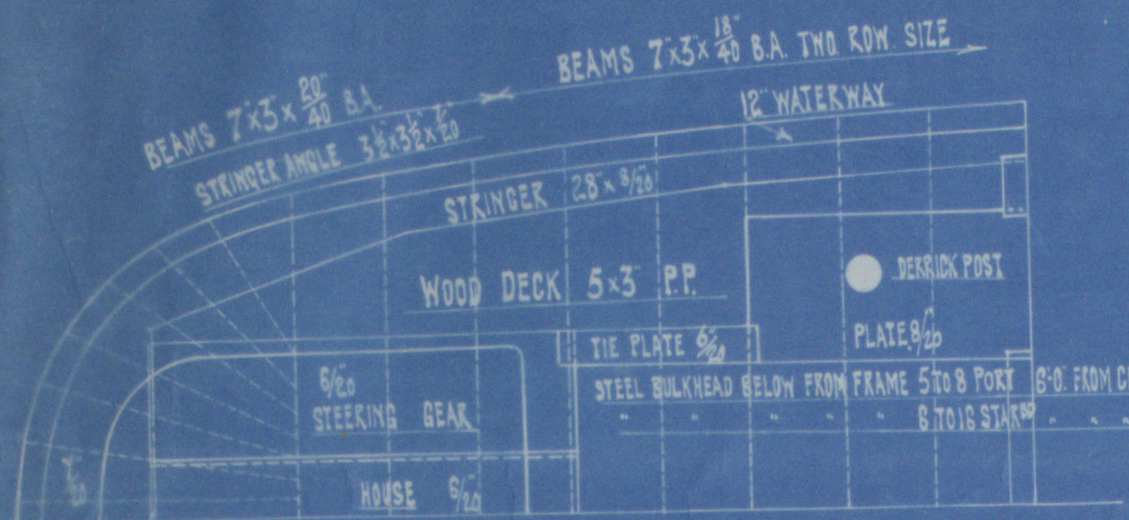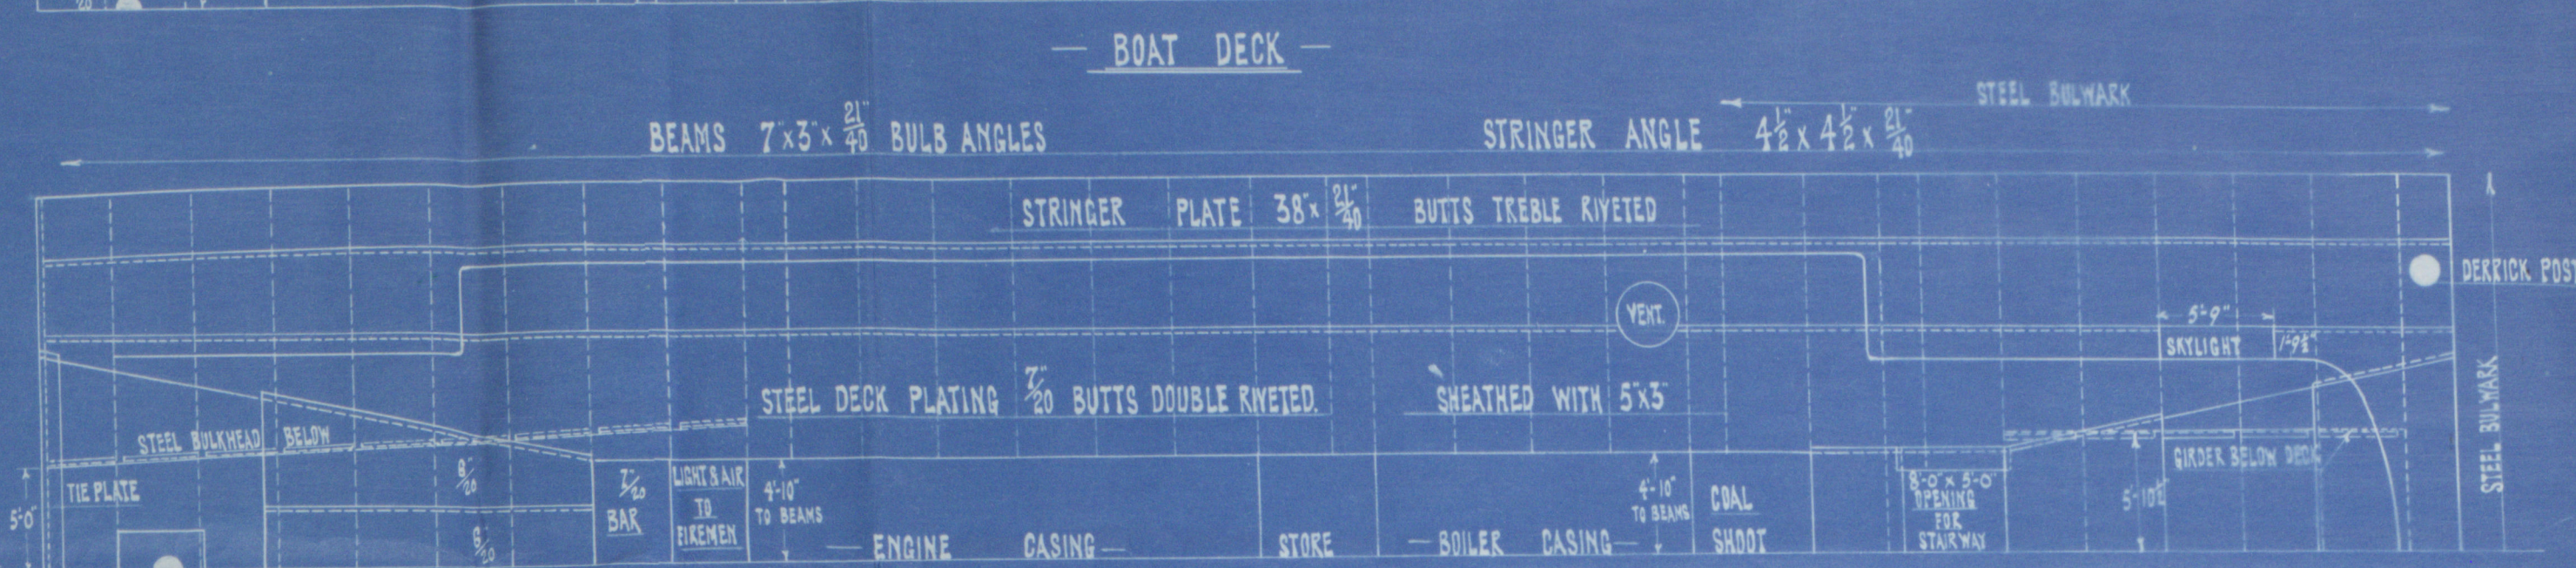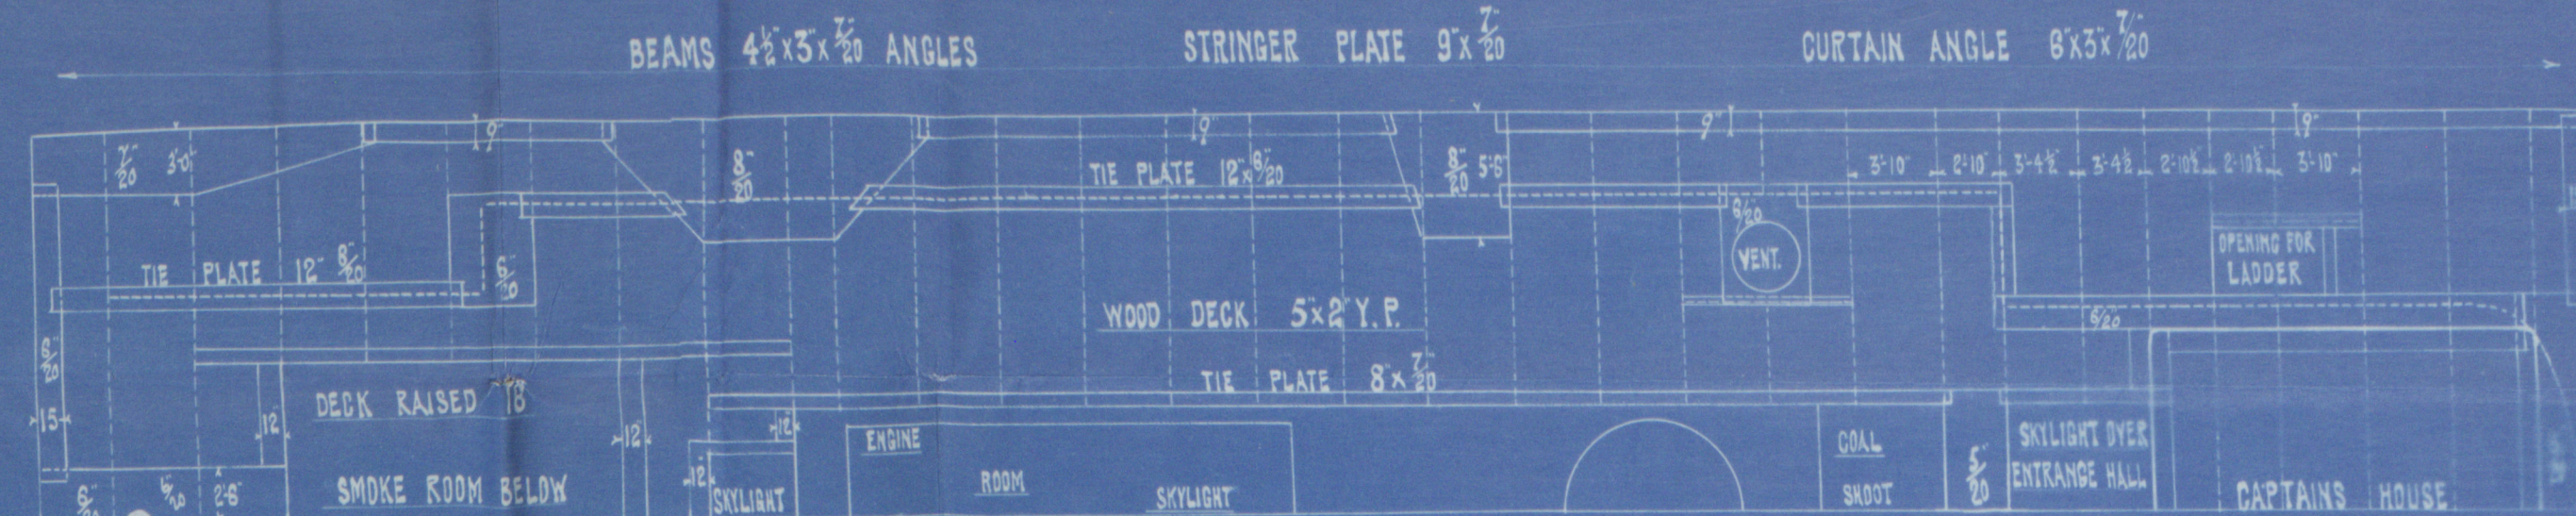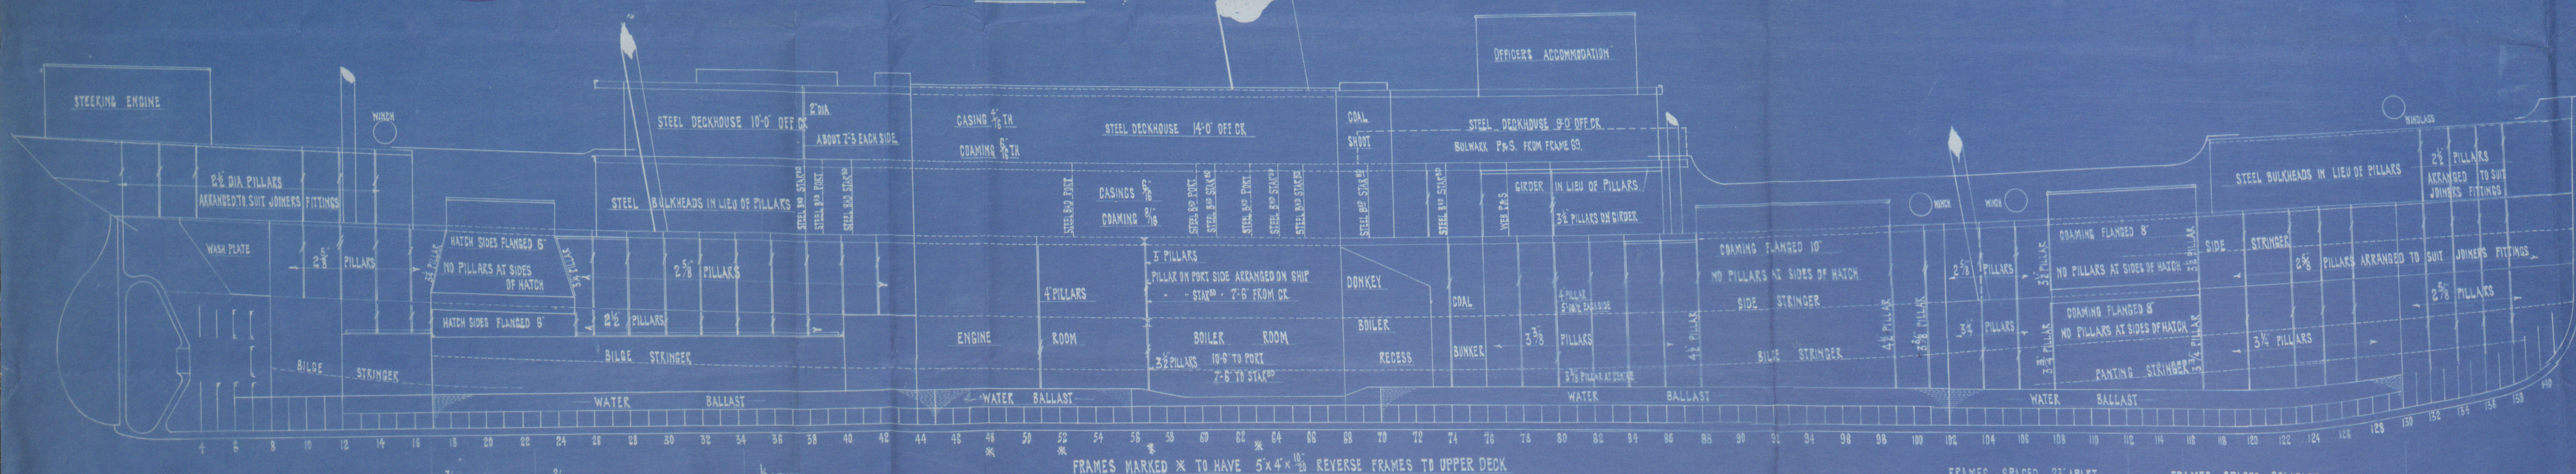

Earle's S. & R. Co. Ltd.
Nos 564, 565, 568, 569, 577

Amended
Profile & Deck Plan

Nº 568. S.S. Blackburn,
Hull Report Nº 23070.

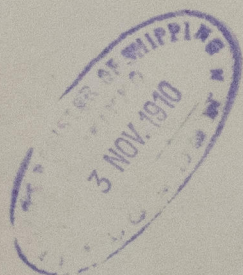

© 2020

Lloyd's Register
Foundation