

9.10.06.

MIDSHIP SECTION

- N^{OS} 529-30 -

Dim^s 110.6BP x 21.6EX x 11.9 DEPTH OF HOLD

CLASS 100A1 STEEL
FOR FISHING PURPOSES

SCALE 1/2" = 1 FOOT

- LLOYD'S NUMERALS -

1/2 BREADTH 10.68

1/2 GIRTH 19.22

DEPTH 13.08

42.98 1ST N°

LLOYD'S LENGTH 109.33

4699.003 2ND N°

- EQUIPMENT -
- 1 ANCHOR 4 1/4 CWT EX STOCK
 - 1 " 4 1/4 " " "
 - 1 " 2 1/2 " " "
 - 90 FATHOMS 15/16 CHAIN
 - 60 " 5/8 HAWSER
 - 60 " 4 WARP

E & B CASING AS
APPROVED IN PREVIOUS
CASES.



SECTION THRO BALLAST TANK



Lloyd's Register Foundation



Earle's S. & E. Co.

No 529-30

Midship Auction

s/s Barbados

Hull Report No. 18864

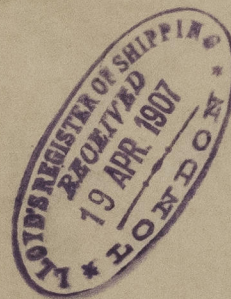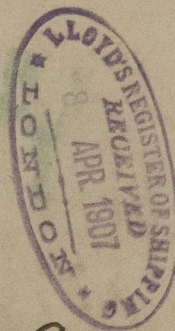

s/s Grenada
Hull Report No.



© 2021

Lloyd's Register
Foundation
W734-0158