

S. S. N<sup>o</sup> 481  
MIDSHIP SECTION.

DIMENSIONS 235 x 33-2 x 14-9 M<sup>LD</sup>

DIMENSIONS PER RULE  $\overset{4.25}{238.77} \times 33.16 \times 15.43$

SCALE  $\frac{1}{2}$  = ONE FOOT.



<u>Length of Erections</u>	
<u>Raised Quarter deck</u>	111' . 11"
<u>Bridge deck</u>	20' . 0"
<u>T. G. Forecastle</u>	30' . 0"

EQUIPMENT.		
✓ 1	Bower Anchor,	Stockless 26 1/4 cwt ✓
✓ 1	" "	26 1/2 " ✓
✓ 1	" "	22 1/2 " ✓
✓ 1	Stream Anchor	7 1/4 " ex. Stock. ✓
✓ 1	Kedge	3 1/2 " ✓
✓ 210	Fathoms	1 3/4" Stud Chain Cable. ✓
✓ 75	"	1 5/8" Stream or 3 1/2" wire. ✓
✓ 90	"	3 1/4" Steel wire Towline. ✓
✓ 90	"	6" Hawser. ✓
✓ 90	"	5" ✓


NUMERALS.

$\frac{1}{2}$ Breadth	16.58	✓
Depth to Keel	15.43	✓
$\frac{1}{2}$ Girth	28.34	
	<u>60.86</u>	
	60.86	Frame No.
Length	234.4	x 25
	14148.70	Rating No. 14-148.7
Add for Erections	12.5	
	<u>15459</u>	
forward.	15459	x 54.4
	841000	Equipment No. 15364
Depth in length	15.11	✓
Breadth	"	= 4.05 ✓

RIVETTING.

✓ All Shell below Main deck  
✓ and Main & Quarter deck Stinger  
Plates to have overlapped ends  
triple riveted for  $\frac{1}{2}$  length.  
✓ remainder double riveted.  
✓ All Landings, below Main & Quarter  
✓ decks double riveted.  
✓ Butts of Centre girder in tank double rivetted  
✓ with double straps.  
✓ Butts of Centre girder in way of ordinary floors,  
✓ triple rivetted with double straps.

✓ Where width of outside  
Sharks of Shell plating  
exceeds 4 ft. and inside  
flaking 5 ft. the Rapped  
Butts to be quadruple  
riveted.. ✓

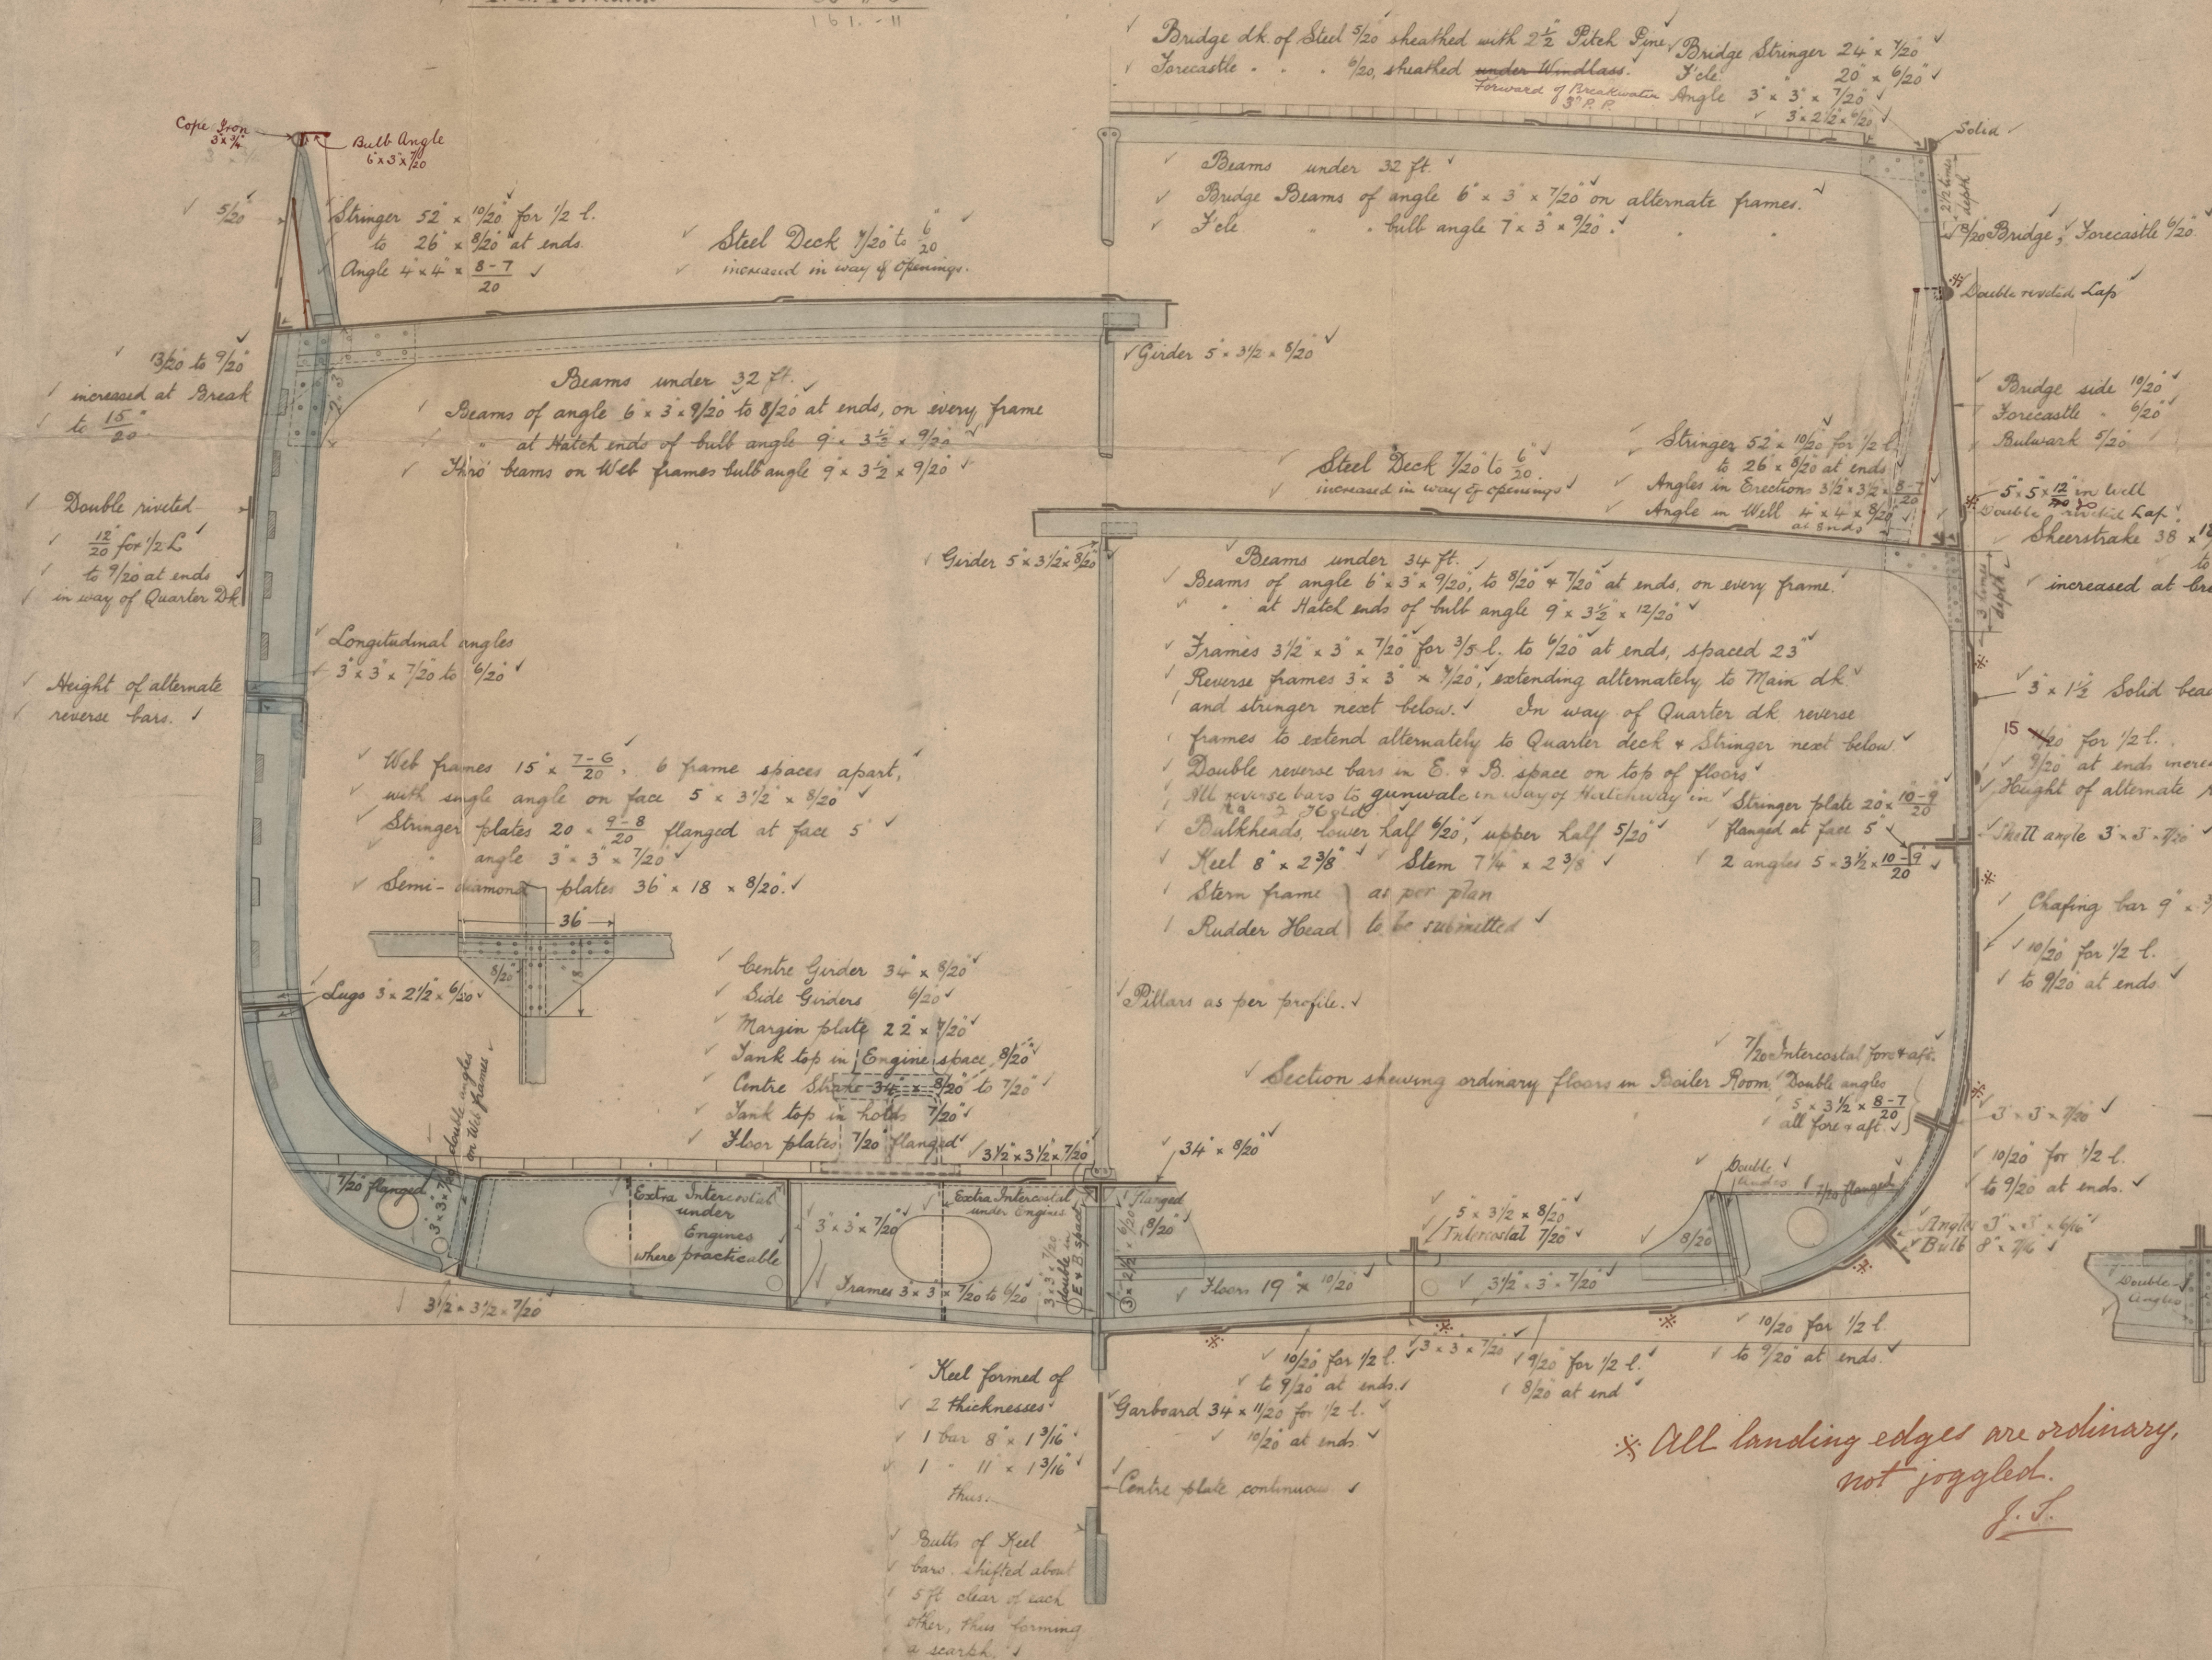

& All landing edges are ordinary,  
not jagged.





W735-0010





Midship Section  
- Carlis No 481  $\frac{1}{2}$  -

RETAIN

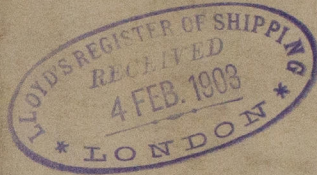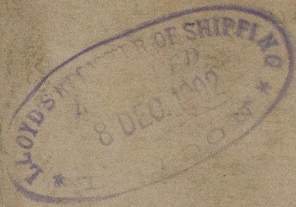

$\frac{1}{2}$  Africa

Hull Report No. 15217



RETAIN



© 2021

Lloyd's Register  
Foundation

W 735-0019