

A circular purple ink stamp. The outer ring contains the text "CRAIG, TAYLOR & CO." at the top and "THORNABY-ON-TEES" at the bottom, separated by small stars. The inner circle contains the text "IRON & STEEL" at the top, "13 AUG 1900" in the center, and "SHEFFIELD" at the bottom.

LENGTH. B. P.	320' - 0"
BREADTH. M ^o	46' - 0"
DEPTH. M ^o	23' - 9"

SCALE $\frac{1}{2}'' = 1$ FOOT.
CLASS 100.A.1. LLOYDS.
THREE DECK RULE. ONE DECK.
STEEL.

$\frac{1}{2}$ BEAM	23.00
$\frac{1}{2}$ GIRTH	43.28
DEPTH	24.70

$$\frac{\frac{L}{D}}{\frac{L}{B}} = \frac{12.88}{6.91}$$


POOP 30
BRIDGE 68
FCLF 30
128

$\frac{128}{320}$

4

$8 \overline{) 28949}$
3618

30396 EQUIPMENT No WITH ERECTIONS (30020/32820)

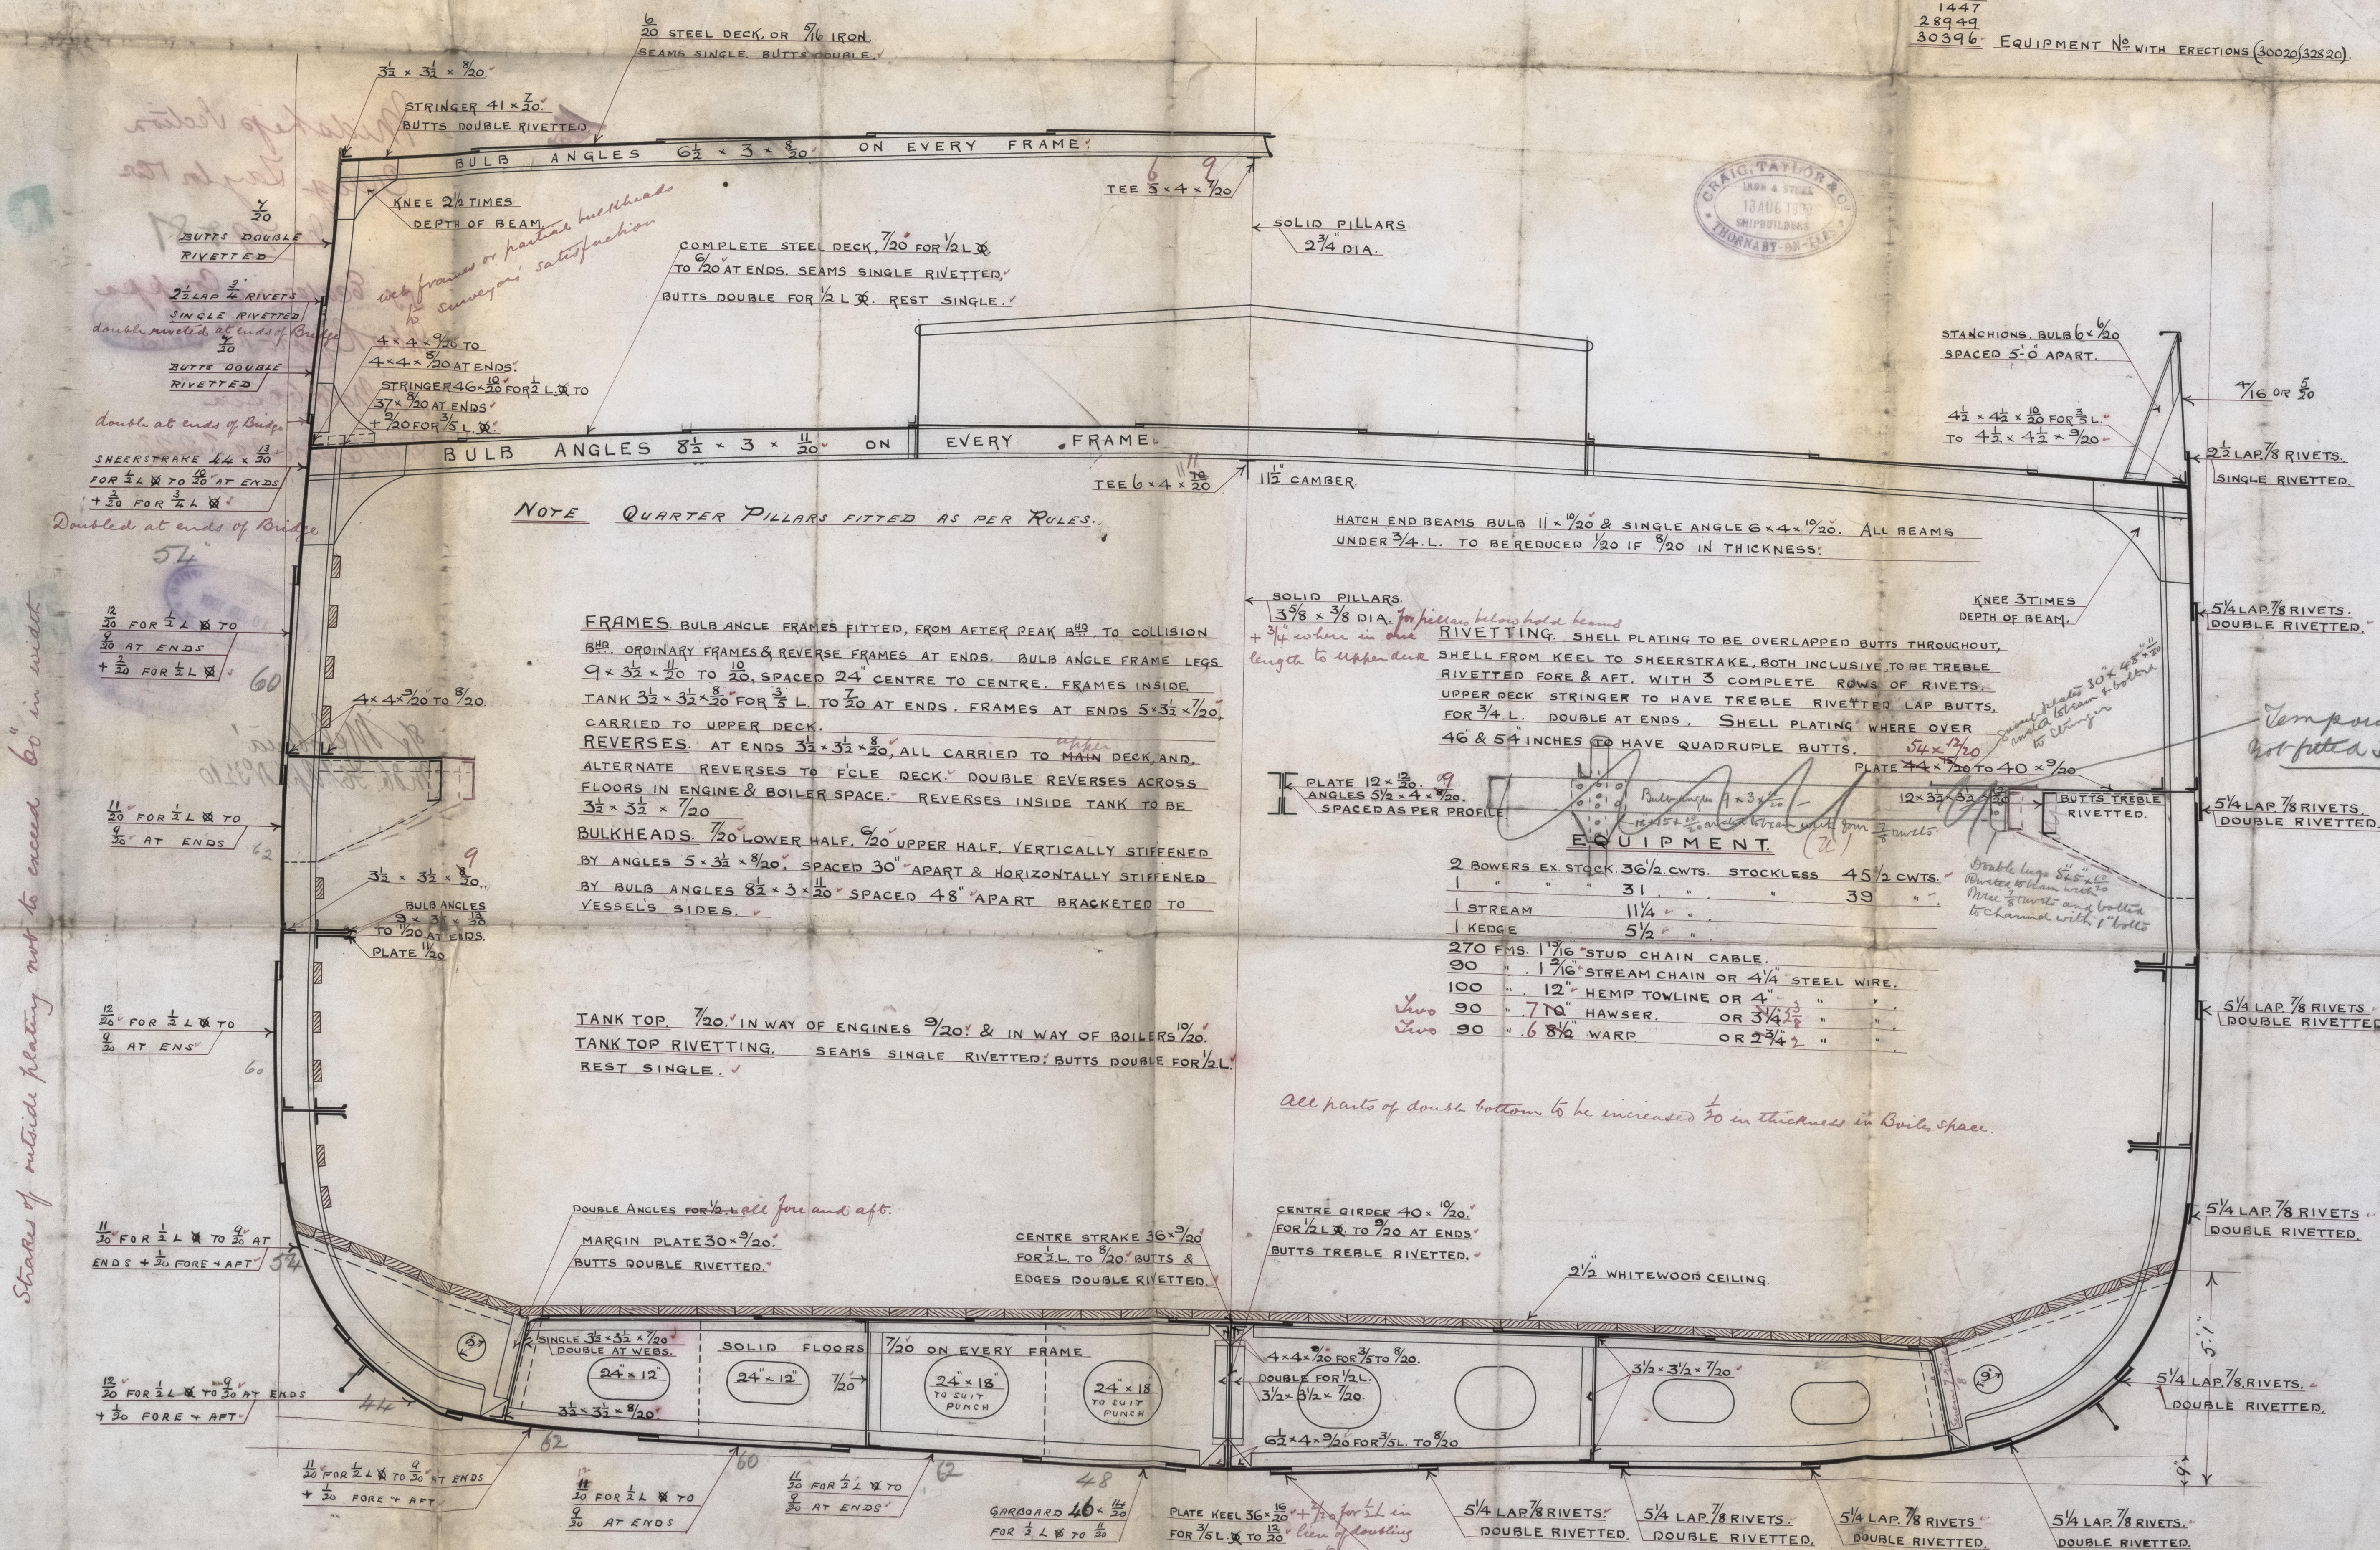

NOTE - TWO STAKES OF PLATING NEXT TO GARBOARD STRAKE TO HAVE MIDSHIP THICKNESS CARRIED TO COLLISION BULKHEAD.

STEM	$10\frac{1}{2} \times 2\frac{3}{4}$
STERN POST	11×6
RUDDER HEAD	8
RUDDER HEEL & PINTLES	4

FRAMES IN TANK DOUBLED FROM 3/5L
FORWARD TO COLLISION BULKHEAD
and remaining requirements of Circular No 1012 to be complied with.

16-8-00 25

TRACING № 5652

Midship Section
Craig Taylor 100
No. 79 & 81



S.S. "Ecatarina Couppa"
Intro Report - No. 3115

S.S. "Melobesia"
Intro Report - No. 3223

S.S. "Melobesia"
Intro. 36? Rpt. No. 3210

RETAIN

RETAIN

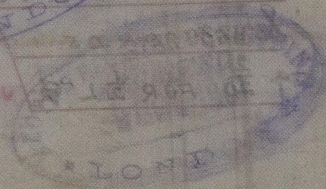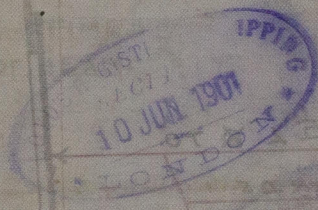

© 2021

Lloyd's Register
Foundation