



9:2:01

HORIZONTAL MULTITUBULAR STEEL BOILER 8'-6" DIA. x 8'-0" LONG. LLOYD'S SURVEY 130 LBS. W.P.

FOR MESSRS CRABTREE & CO GREAT YARMOUTH.

Boiler No 2914.

SCALE 1" = 1 FOOT.

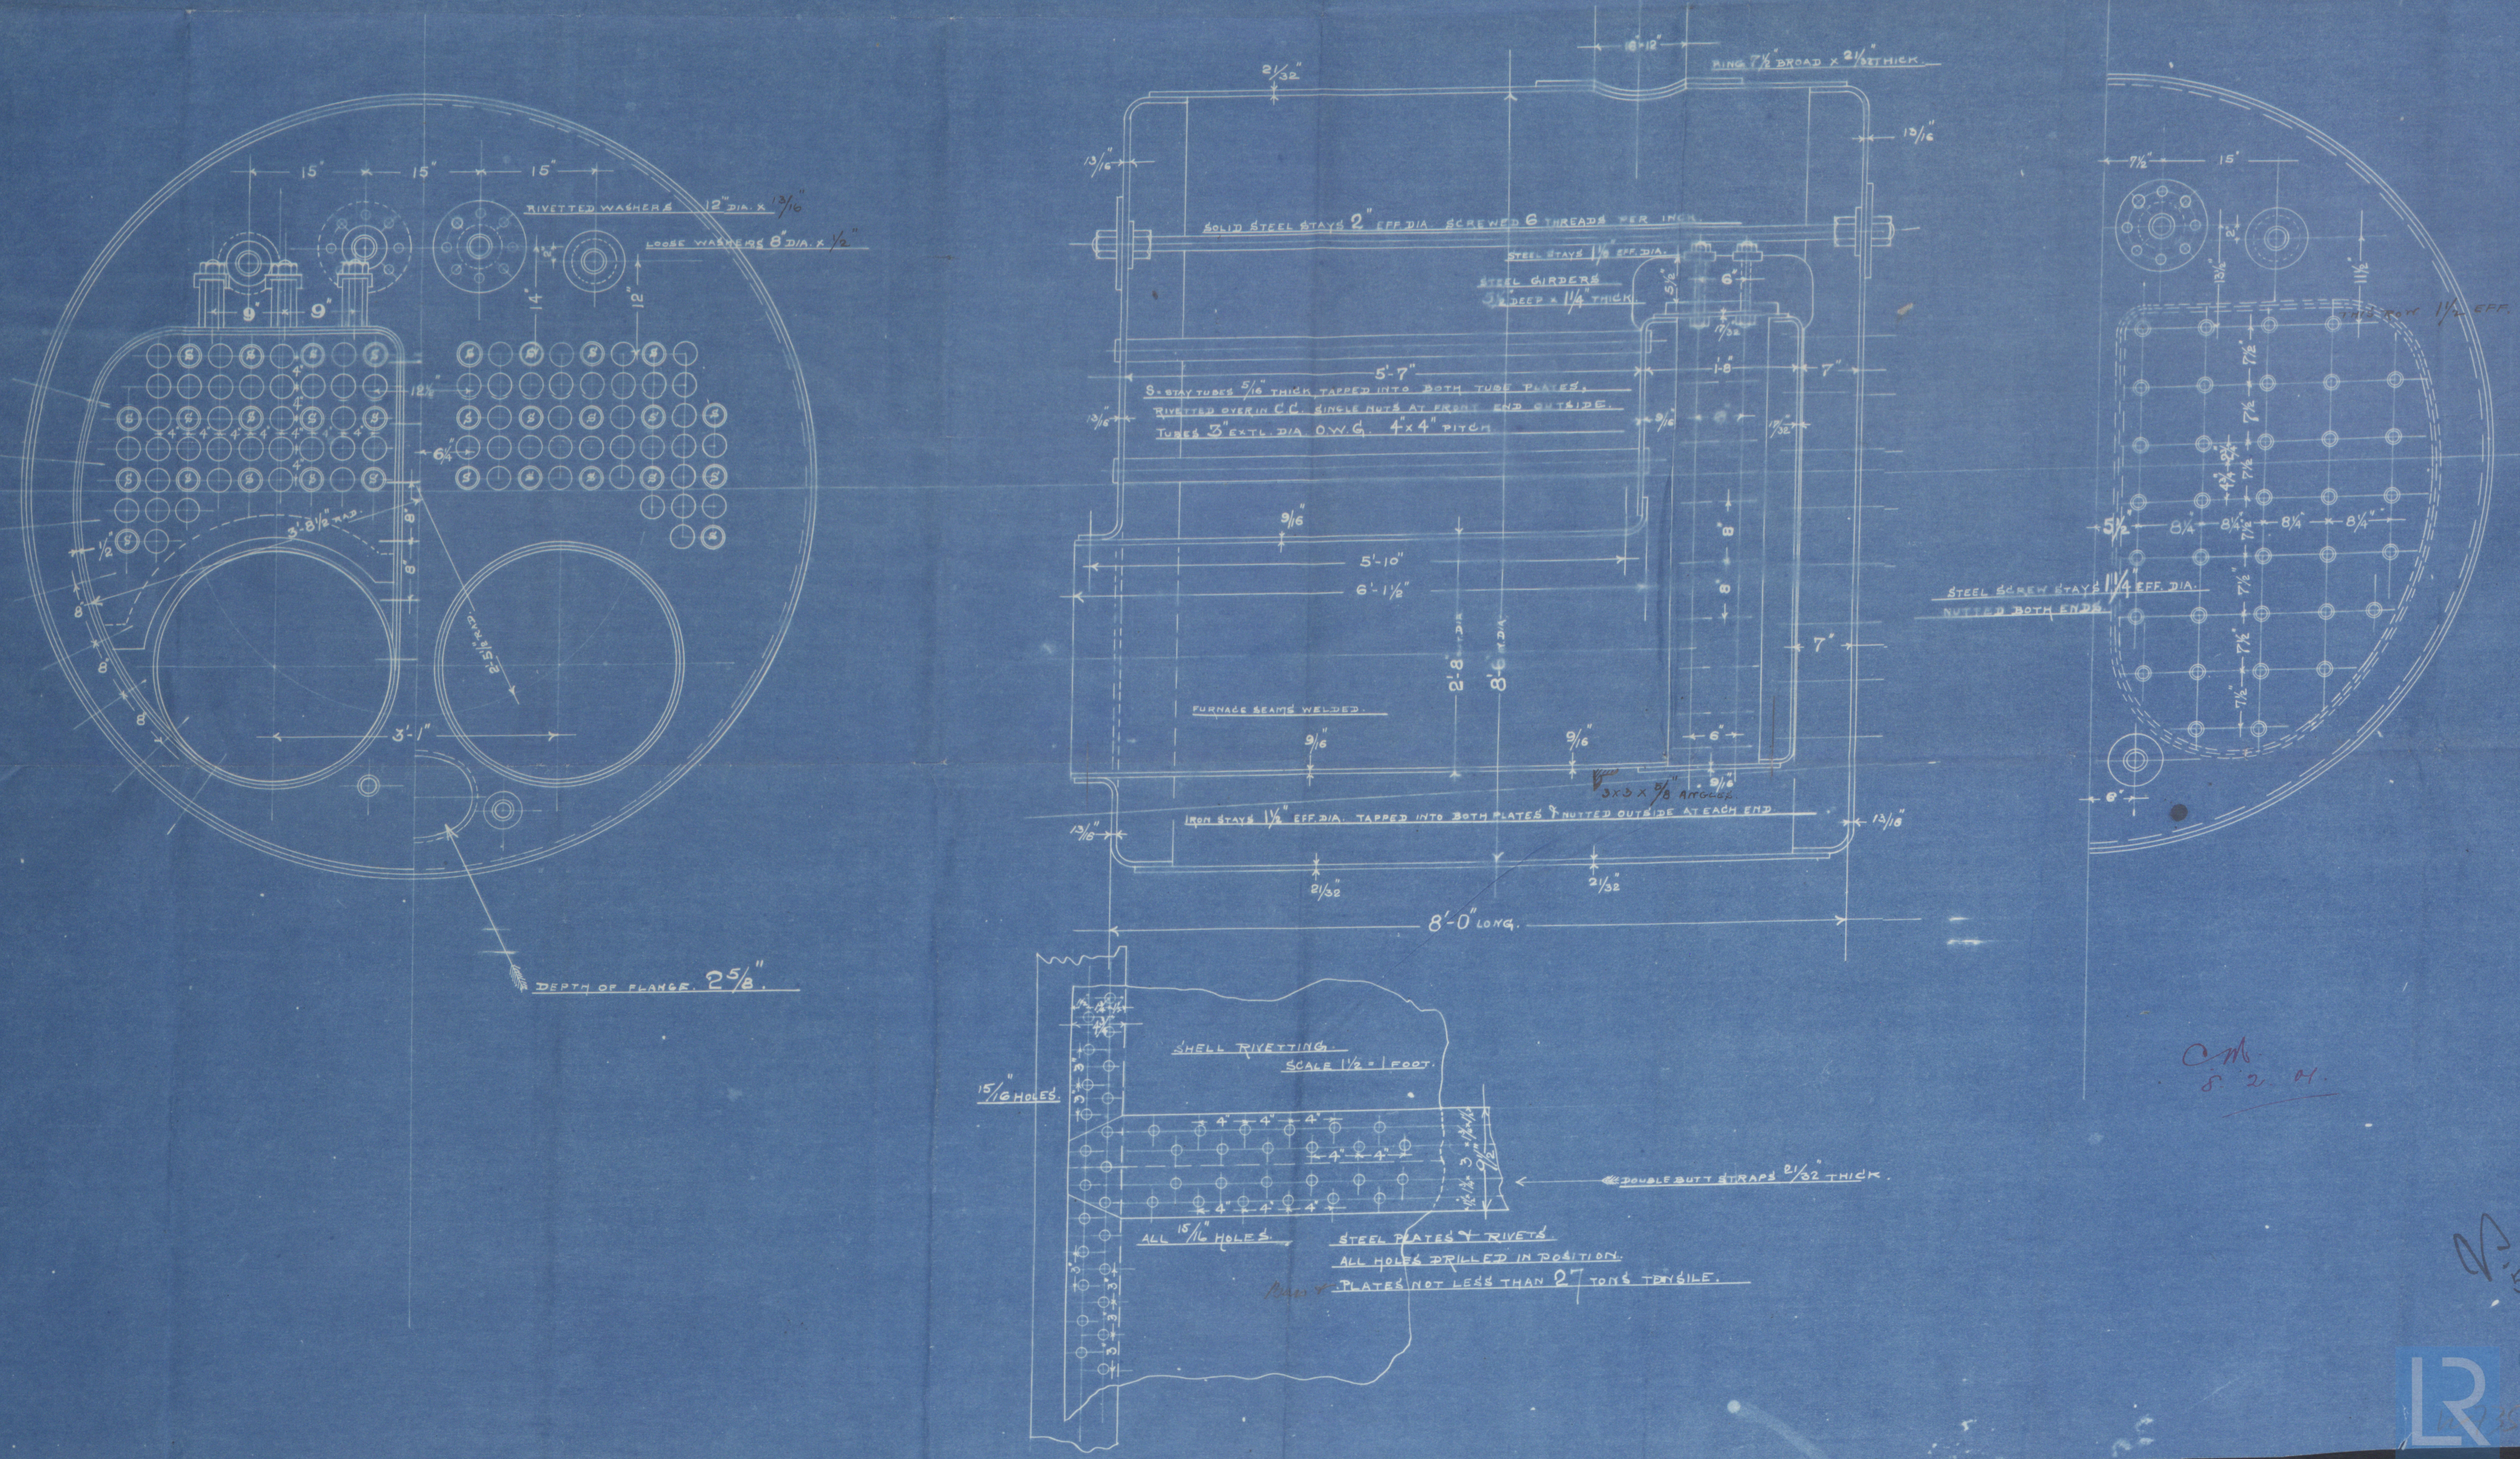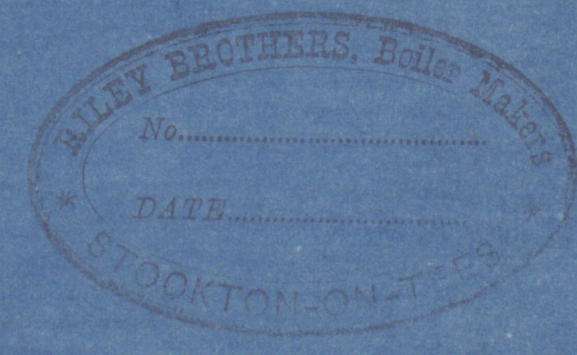


9:2:01

9:2:01

Crabtree & Co's
Boiler 130 h.p.

Piley No 2914.

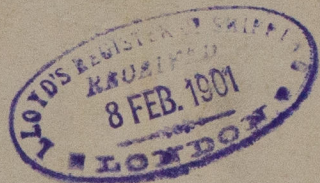

of "Melobesia"
Mob & Co. No 3223



© 2021

Lloyd's Register
Foundation

W735-0108