



STEEL STEAM TRAWLER

-Nº 335.


DIMENSIONS.

122'-0" x 21'-8" MLD x 12'-1" MOULDED.

SCALE $\frac{1}{2}'' = 1 \text{ FOOT.}$

E & B. CASING AS PREVIOUSLY APPROVED.

DECK PLATED AT SIDES OF E. & B. CASING.

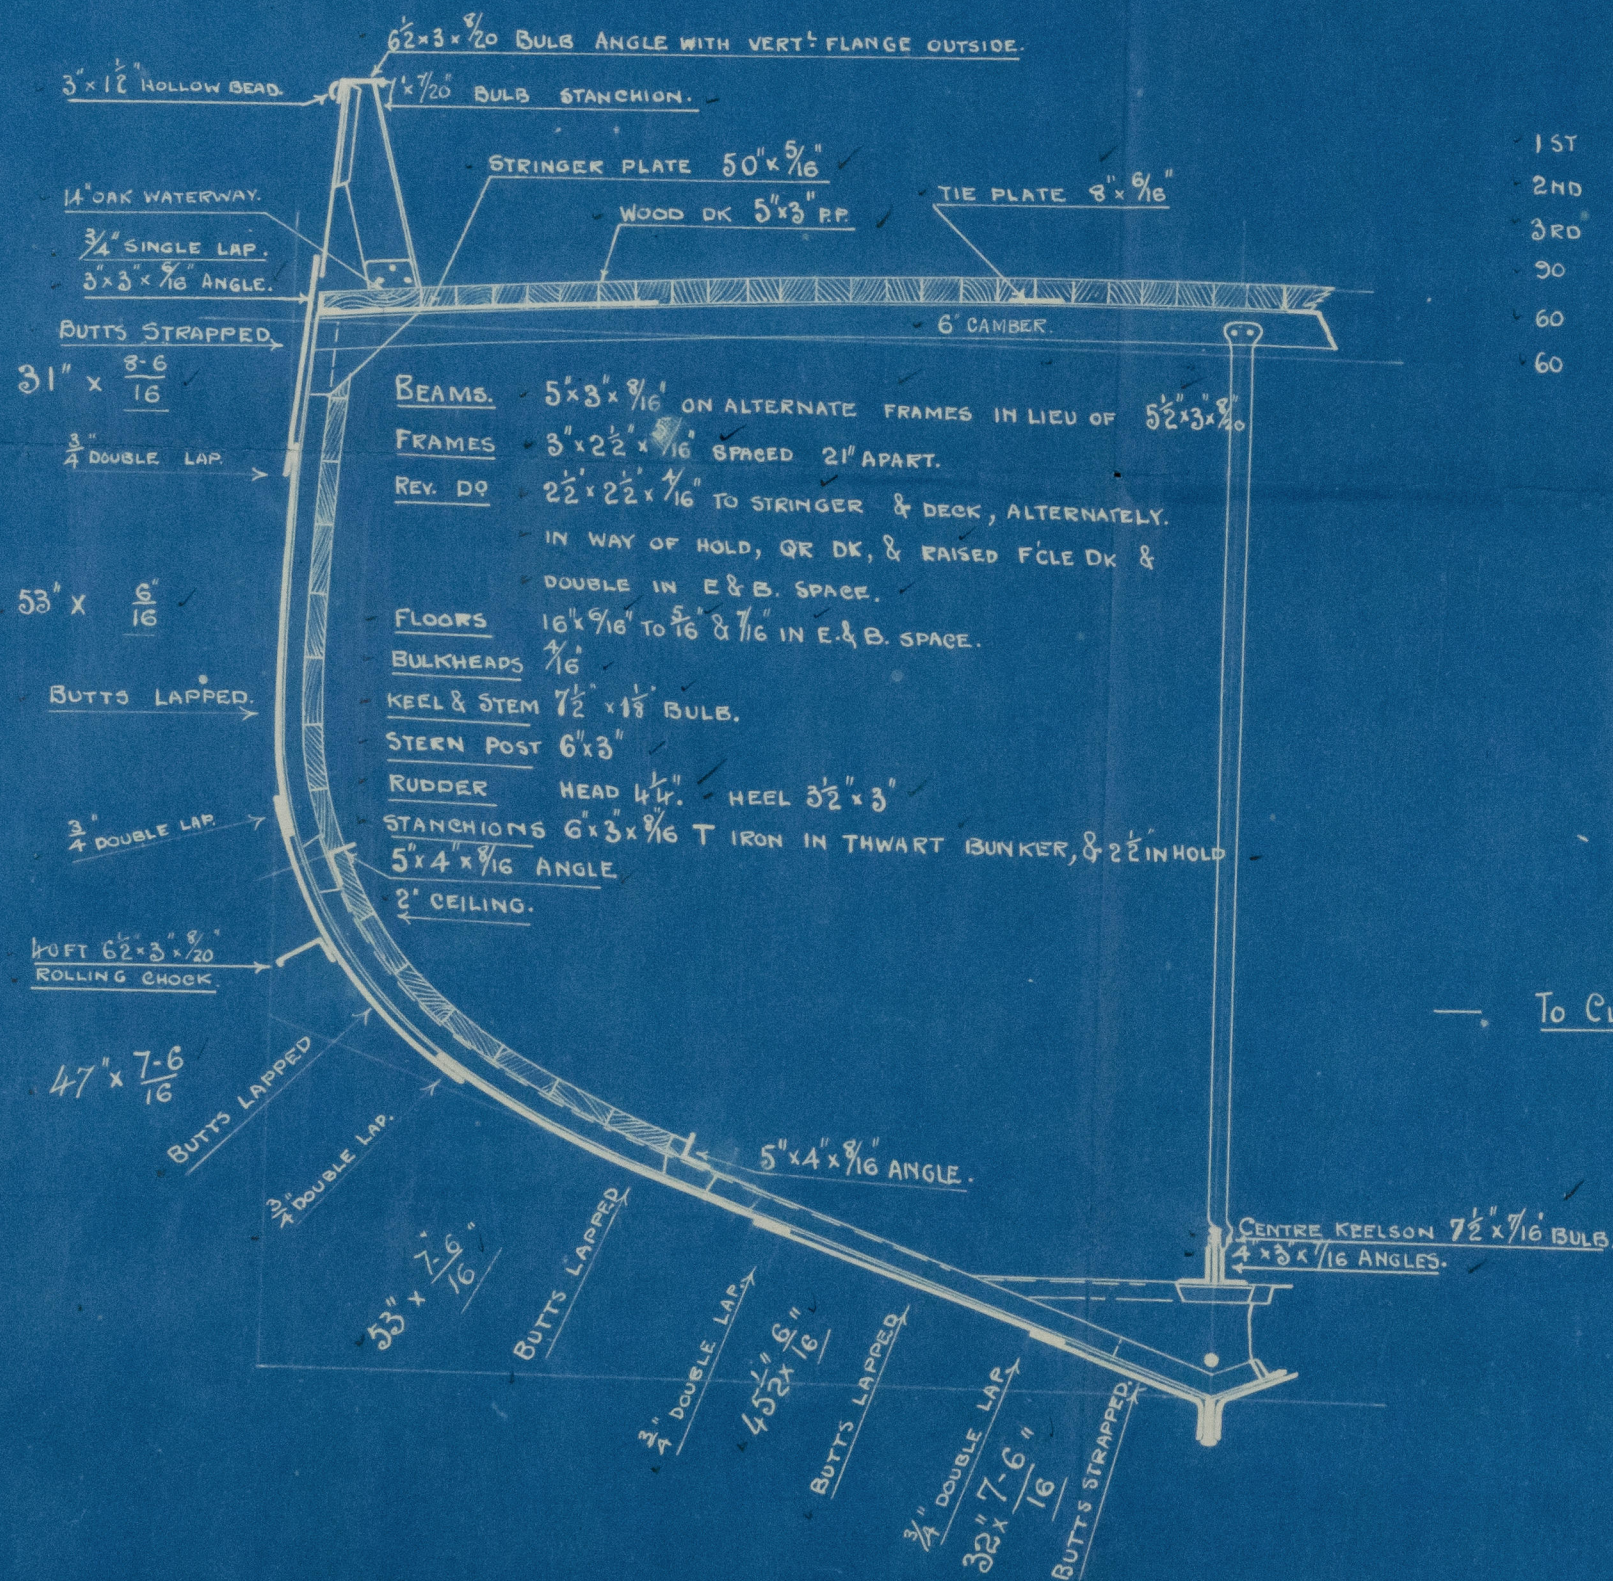

EQUIPMENT.

LLOYD'S NUMERALS.—

$\frac{1}{2}$ GIRTH. 18.66.
 $\frac{1}{2}$ BREADTH. 10.83.
 DEPTH. $\frac{12.54.}{42.03} = 1^{ST} N^o$
 $120.87 = \text{LENGTH AS PER RULE.}$
 $\frac{29421}{33624}$
 8406
 $\frac{4203}{50801661} = 2^{ND} N^o$


TO CLASS 100.A.I. FOR FISHING PURPOSES.

COCHRANE & SONS

SHIPBUILDERS

SELBY.



YORK

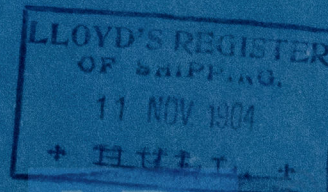


- Midship Section
bockrane & sons
No. 335

11
s/s 'Calabria'

Hull Rpt. No. 16641

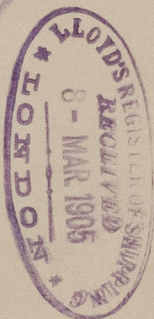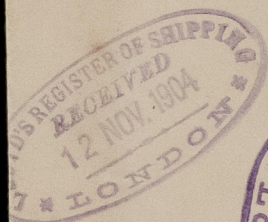

RETAIN

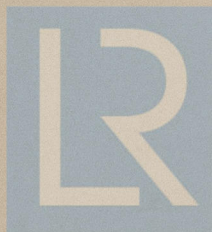

© 2021

Lloyd's Register
Foundation

W736-0008