



15. 11. 04

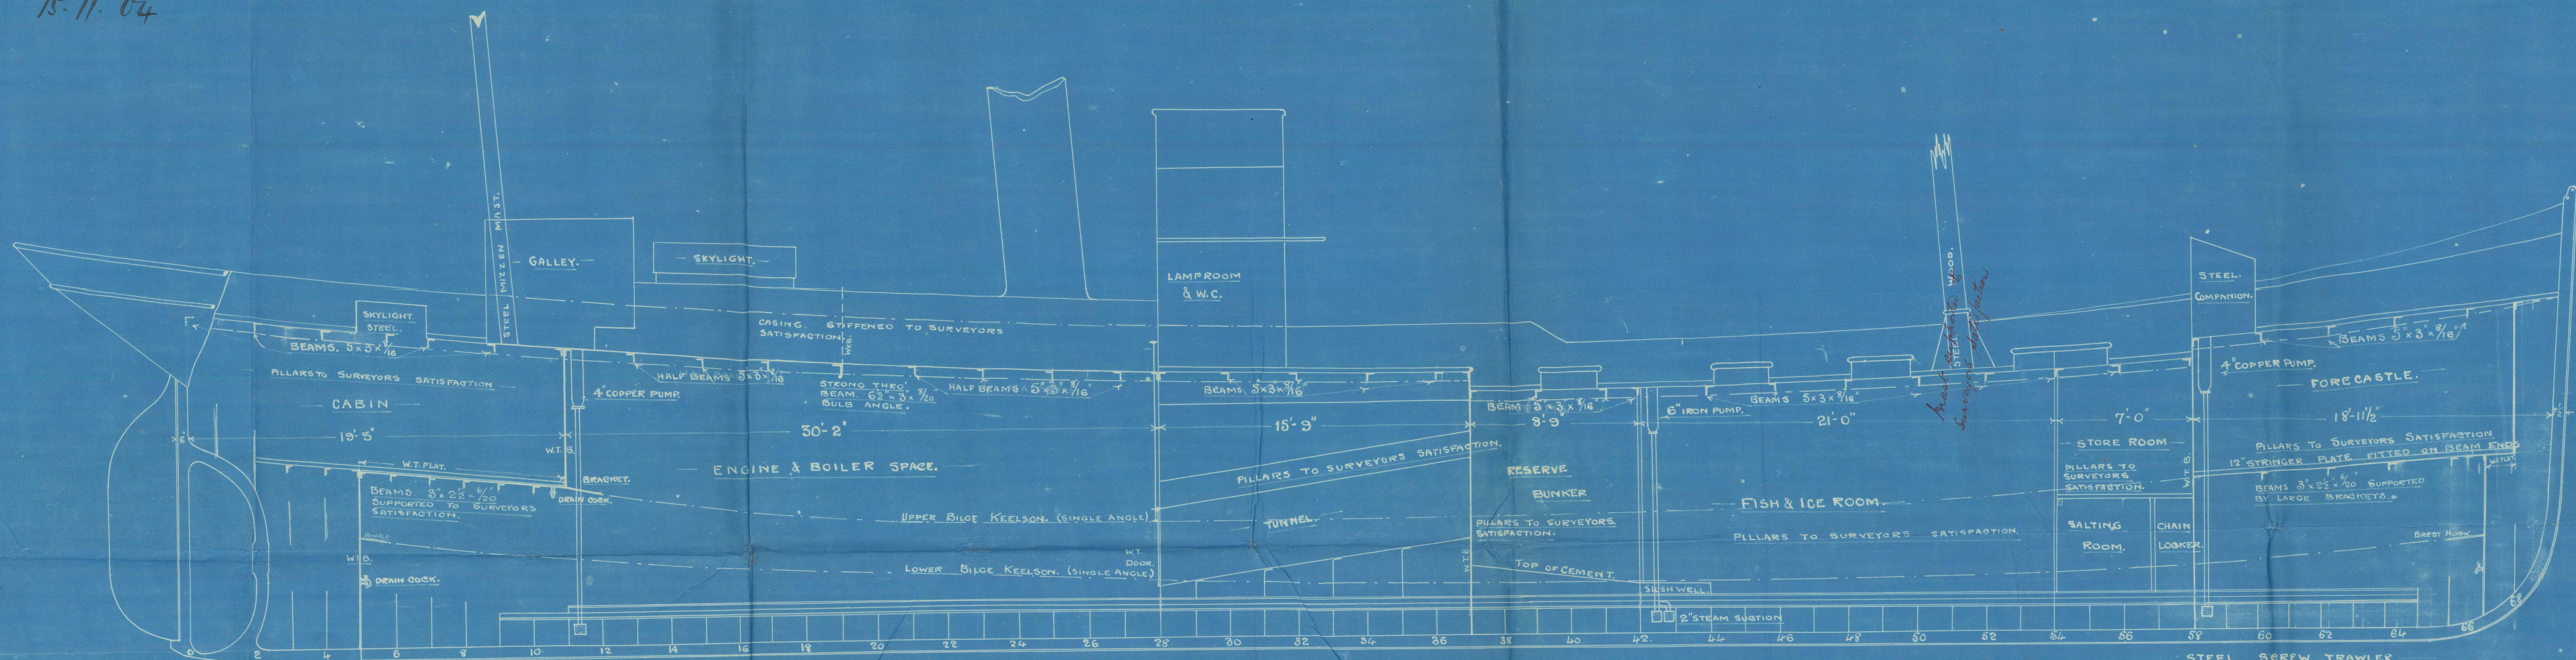

STEEL SCREW TRAWLER
PROFILE & DECK PLAN

1/2" = 1' 385.
120'-0" B.P. x 21'-5" x 11'-5" HOLD.
SCALE 1/4" = 1 FOOT.
1st N. 42-03
2nd N. 8080-1861

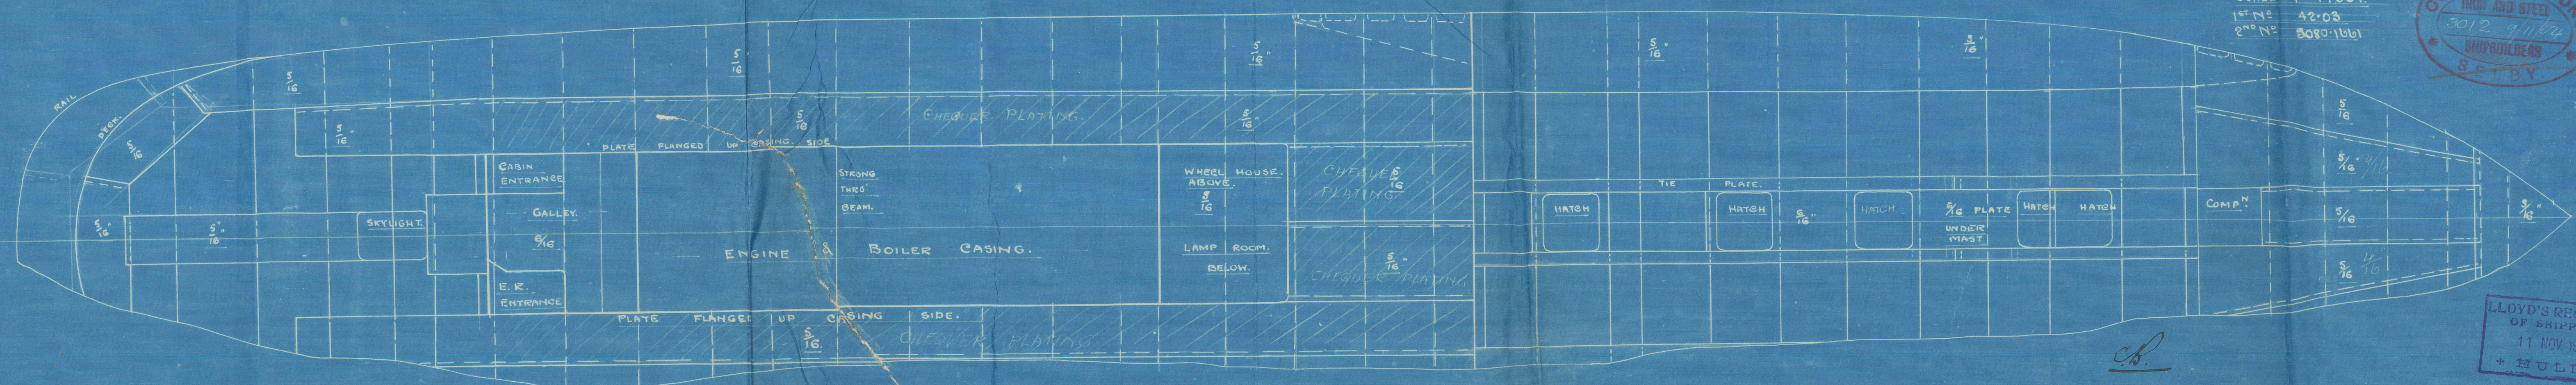

14. 11. 04

W 116-00-04

— Profile —
No. 335
— 11 —



s/s 'balabria'
Hull Rpt No. 16641

PET 111N



© 2021

Lloyd's Register
Foundation

W736-0009