


120.0" B.P. x 21.6" EX. x 12.6" MLD.

PLAN No. 4909.
FOR ENCLOSURE TO
MESSRS LLOYDS SURVEYOR
HULL. FROM
COCHRANE & SONS, LTD.
SHIPBUILDERS, SELBY.
DATE 3/11/14 (8318)

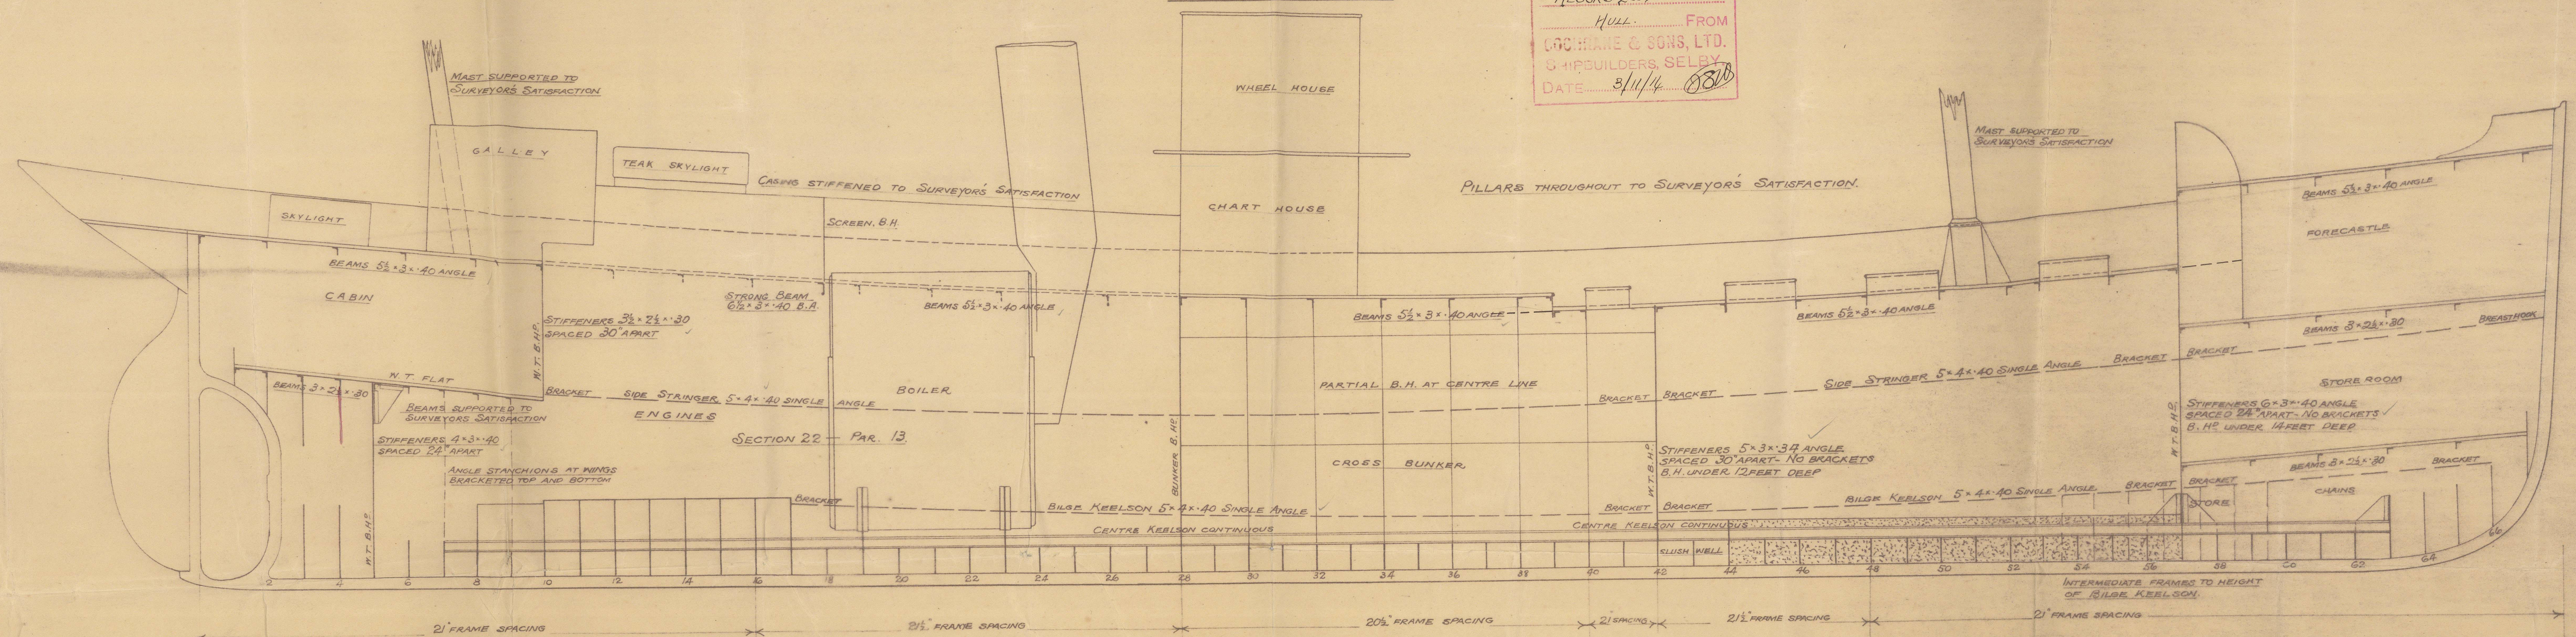

— SCALE $\frac{1}{4}$ IN. = 1 FOOT. —

BB/

9. 11. 14.

Cochranes by Toss

Profile & Deck



S.T. "Carysfort" Hull Rpt No. 28692
" " " " " " 28693

RETAIN



© 2021

Lloyd's Register
Foundation

W737-0152