



# - MIDSHIP SECTION -

STEEL SCREW TRAWLERS


## - No 637-8 -

120' 0" B.P. x 21' 6" EX. x 12' 6" MLD.

SCALE  $\frac{1}{2}$  IN = 1 FT.

TO CLASS 100.A.1. STEAM TRAWLER  
DECK PLATED OVER IN WAY OF MACHINERY SPACE  
ENGINE AND BOILER CASING AS PREVIOUSLY APPROVED

PLAN No. 4908  
FOR ENCLOSURE TO  
MESSRS LLOYD'S SURVEYOR  
HULL. FROM  
COCHRANE & SONS, LTD.  
SHIPBUILDERS, SELBY.  
DATE 3/11/14. 8810

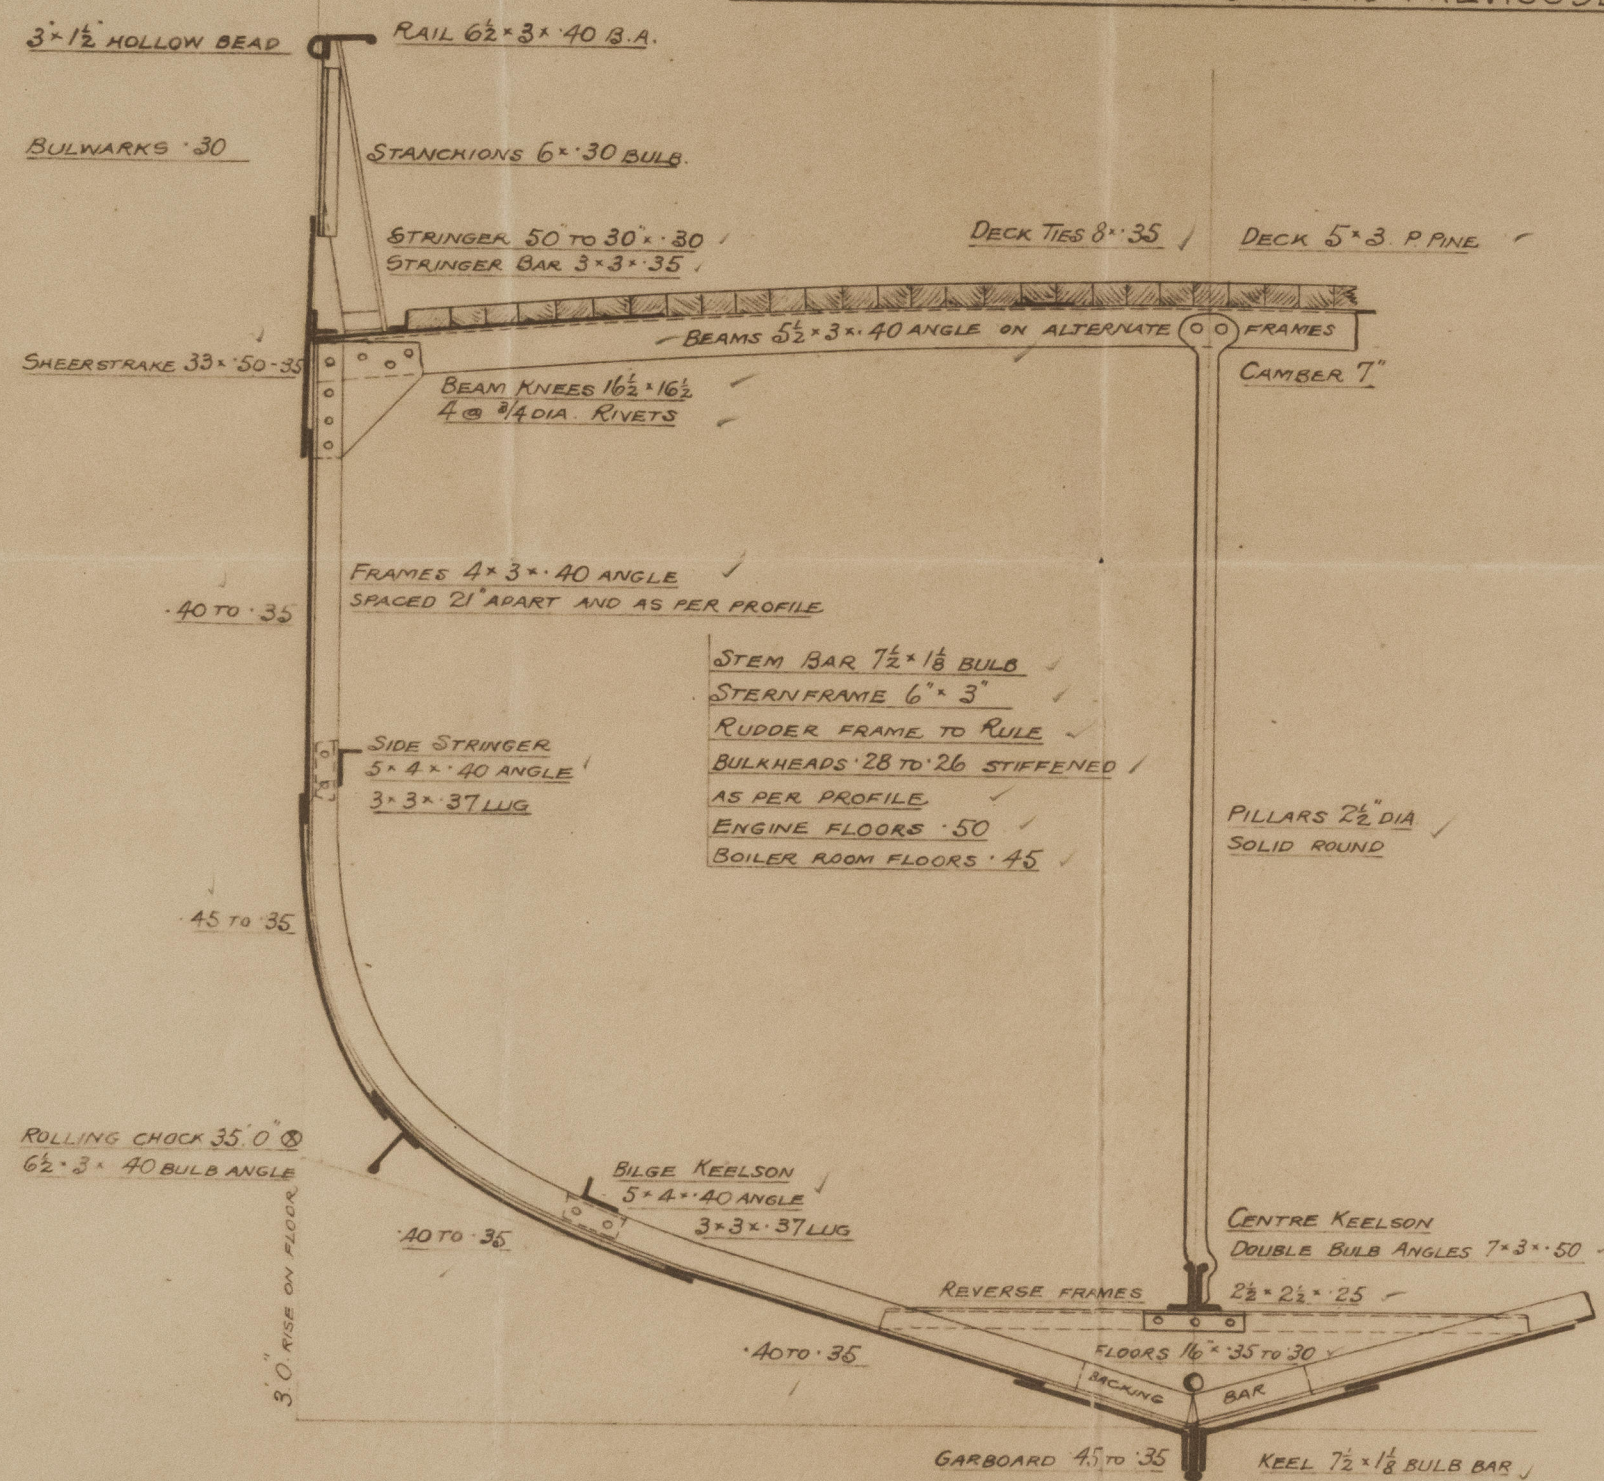

### NUMERALS

21.35 x 12.30  
B + D ----- 33.86  
L x (B + D) ----- 4063. -

### PROPORTIONS

L ----- 9.6  
D ----- 5.62  
L/B

### EQUIPMENT

1<sup>ST</sup> BOWER ANCHOR 62 CHTS. STOCKLESS  
2<sup>ND</sup> " " 6 " "  
KEEDGE " 2 1/2 " EX STOCK  
90 FMS 1" STUD LINK CABLE  
60 " 6" HANSER  
60 " 4 1/2" WARP

### RIVETTING



BUTTS OF SHELL PLATING LAPPED AND DOUBLE RIVETTED, EXCEPT GARBOARD AND SHEERSTRAKE WHICH ARE TO BE STRAPPED AND DOUBLE RIVETTED. LANDING EDGES DOUBLE RIVETTED EXCEPT TOP EDGE OF SHEERSTRAKE, WHICH IS SINGLE RIVETTED. BUTTS OF DECK STRINGER AND TIE PLATES LAPPED AND DOUBLE RIVETTED.

*CCP*  
9.11.14



*Cochran's by Vass.*

*Midship Leuten'*

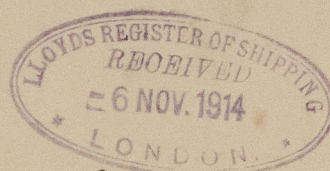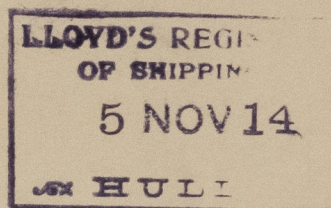

*S.S. "Baryforn" Hull Rpt No. 28692*  
*S.S. "Botomuri" " " " 28693*



RETAIN



© 2021

Lloyd's Register  
Foundation

W737-0153